

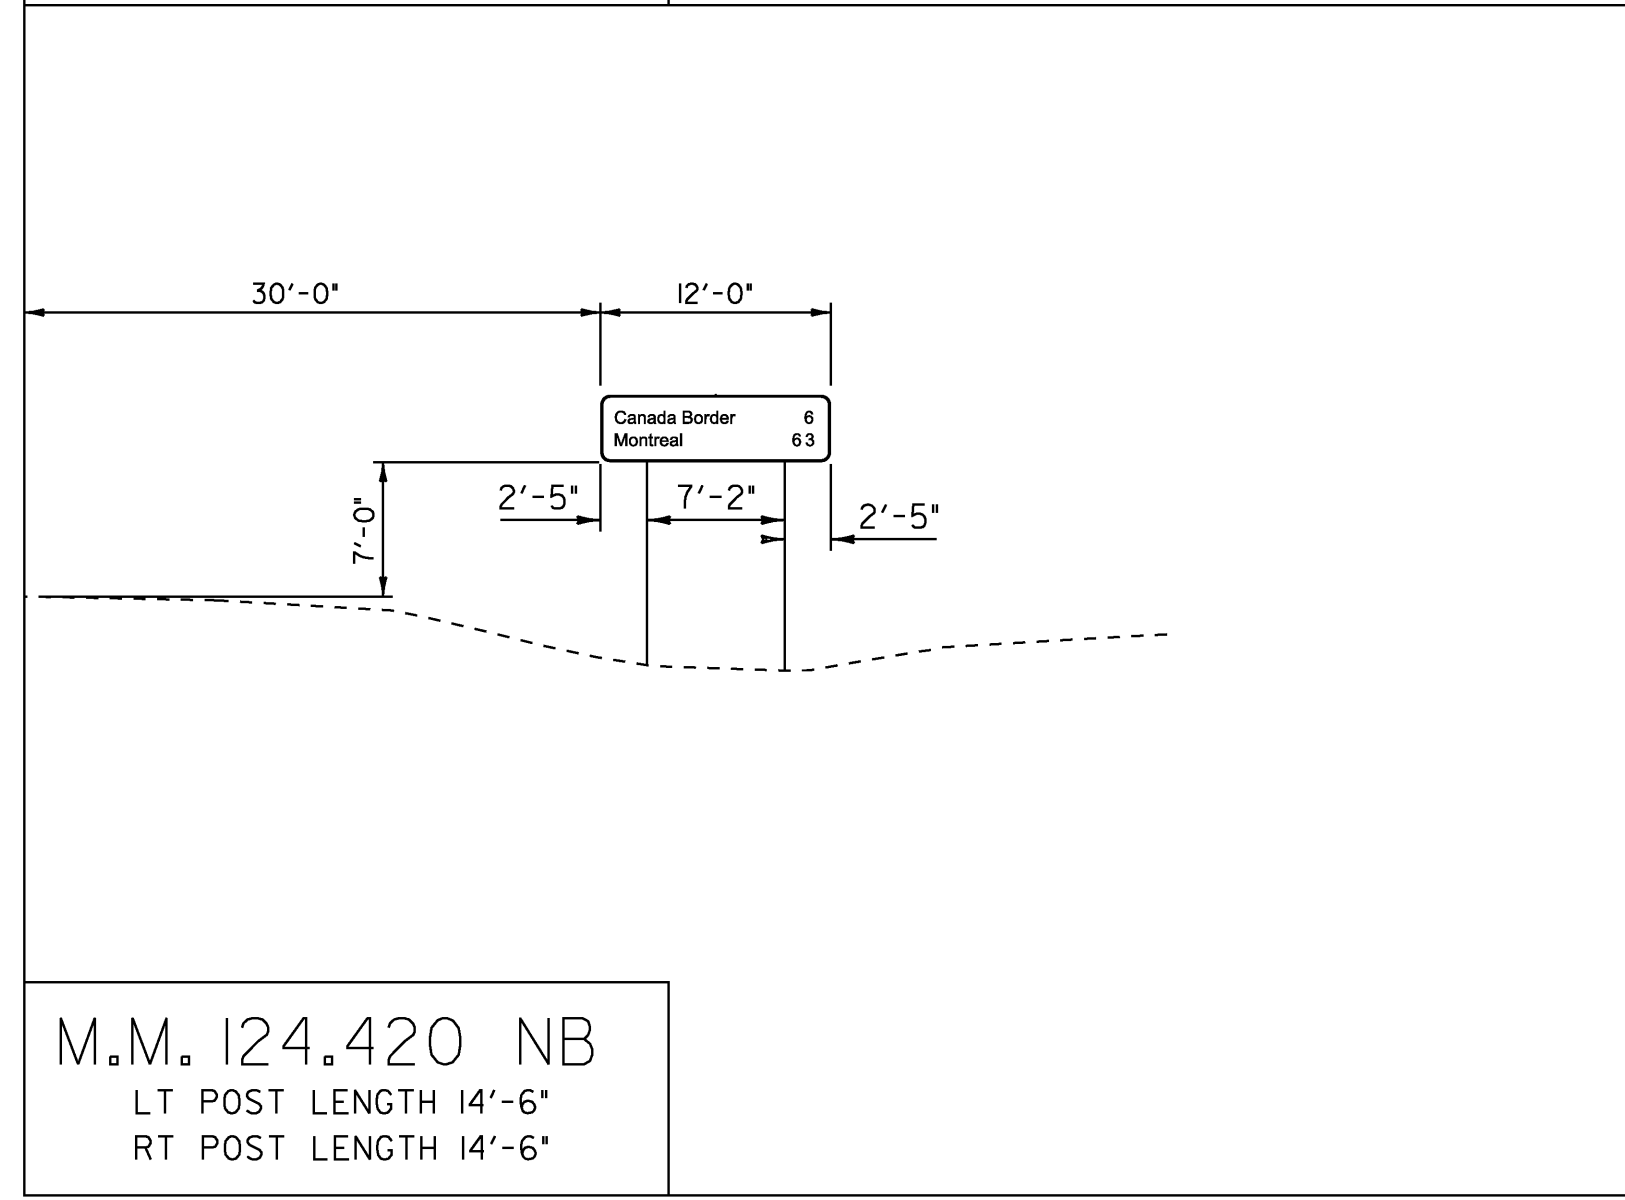
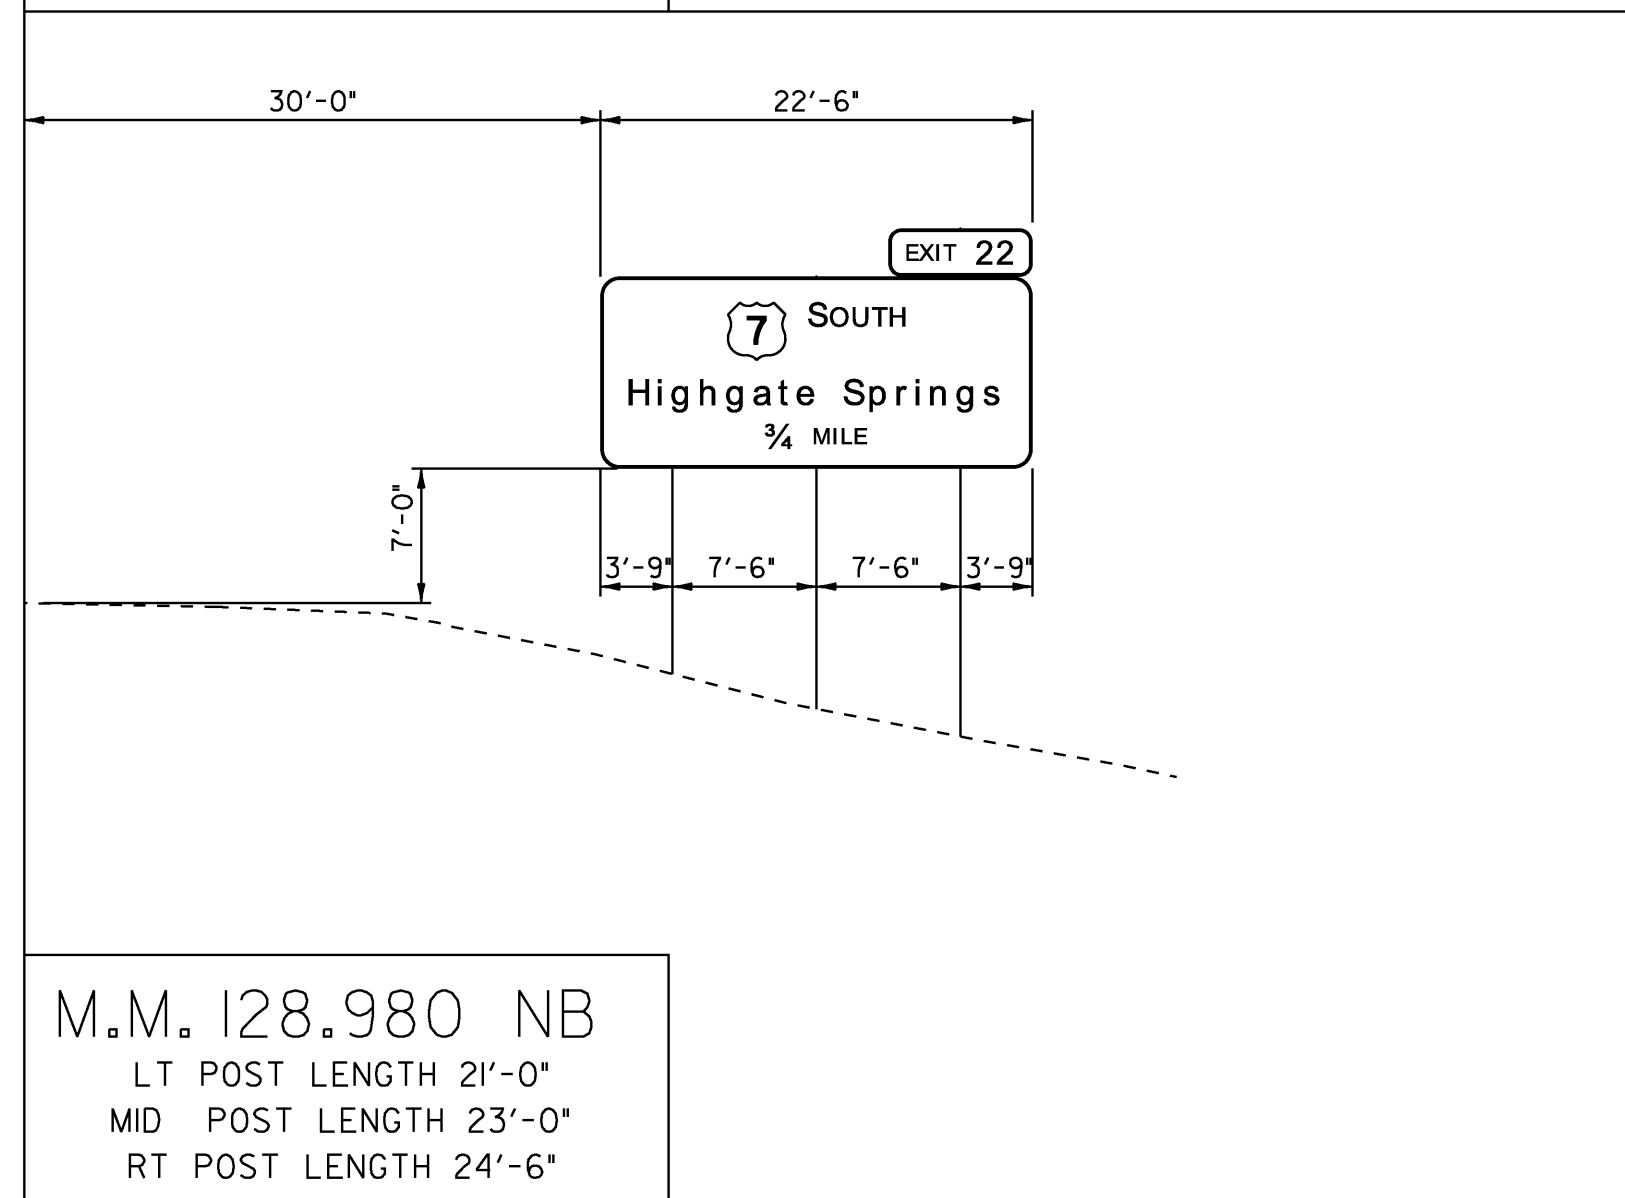


EDGE OF TRAVELLED WAY

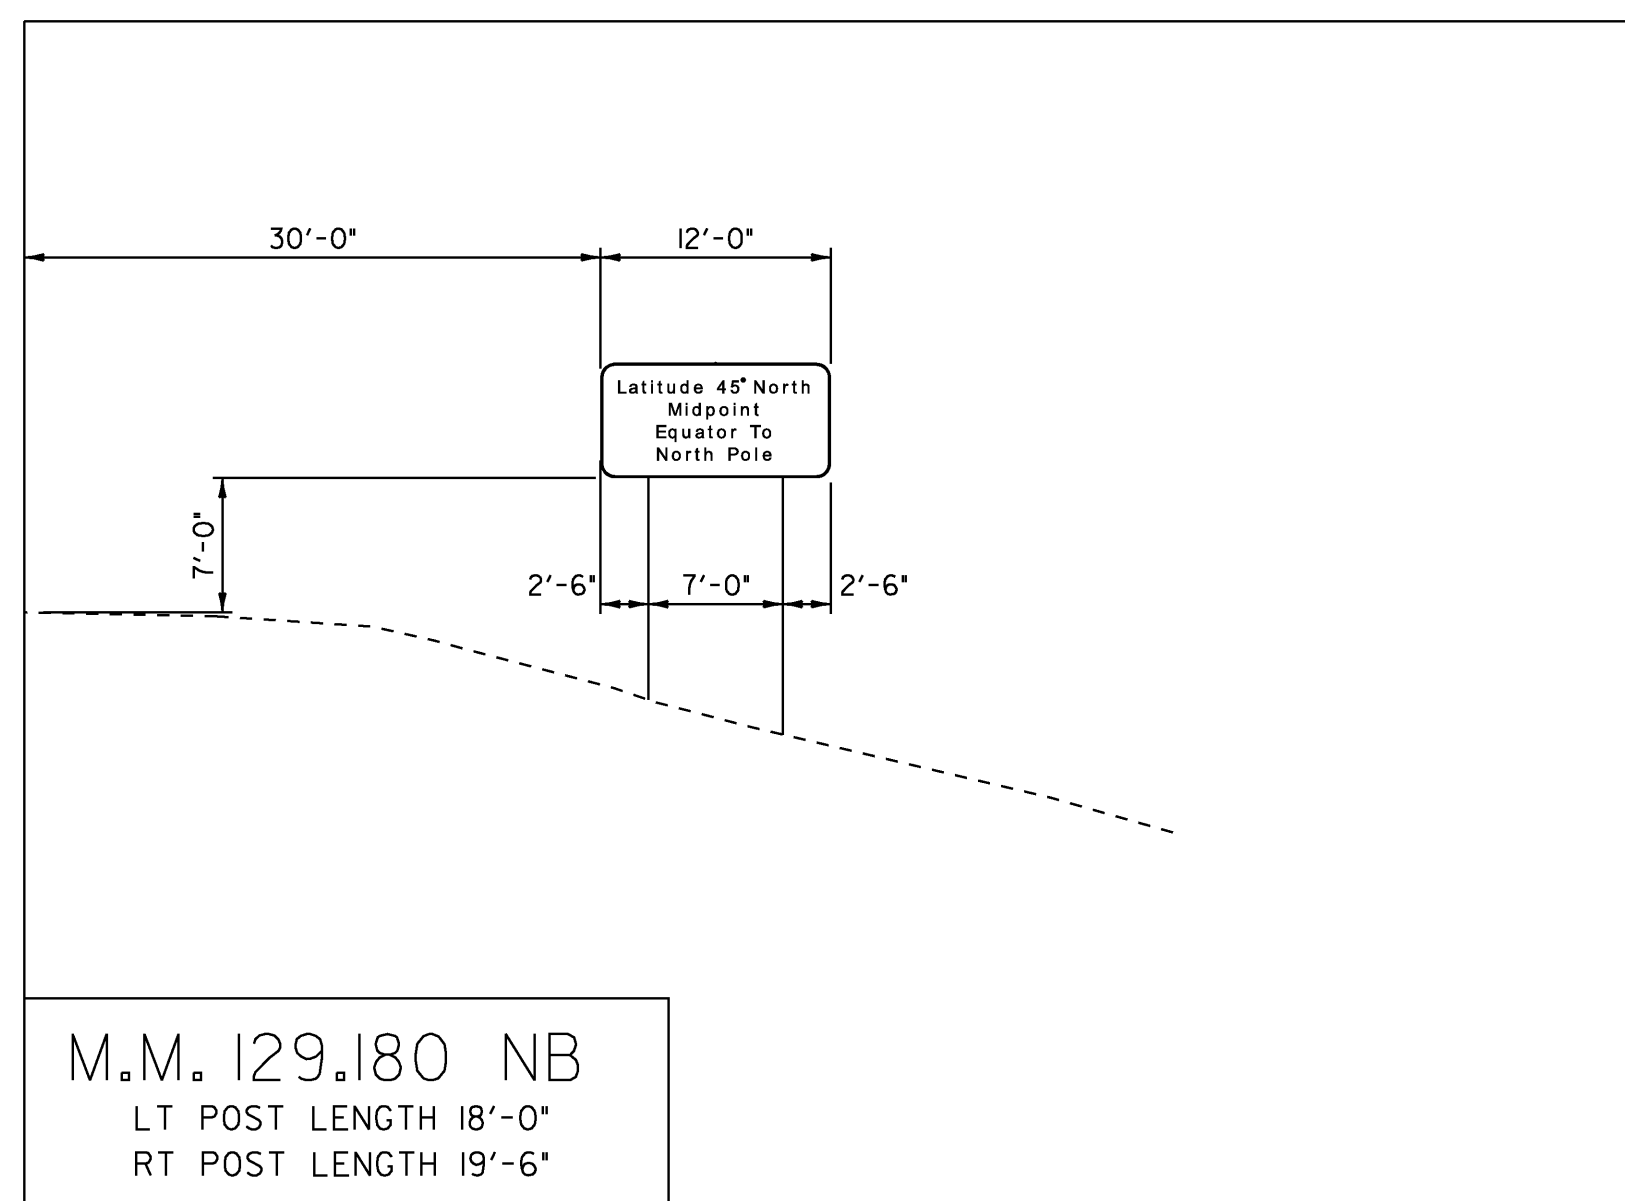

EDGE OF TRAVELLED WAY

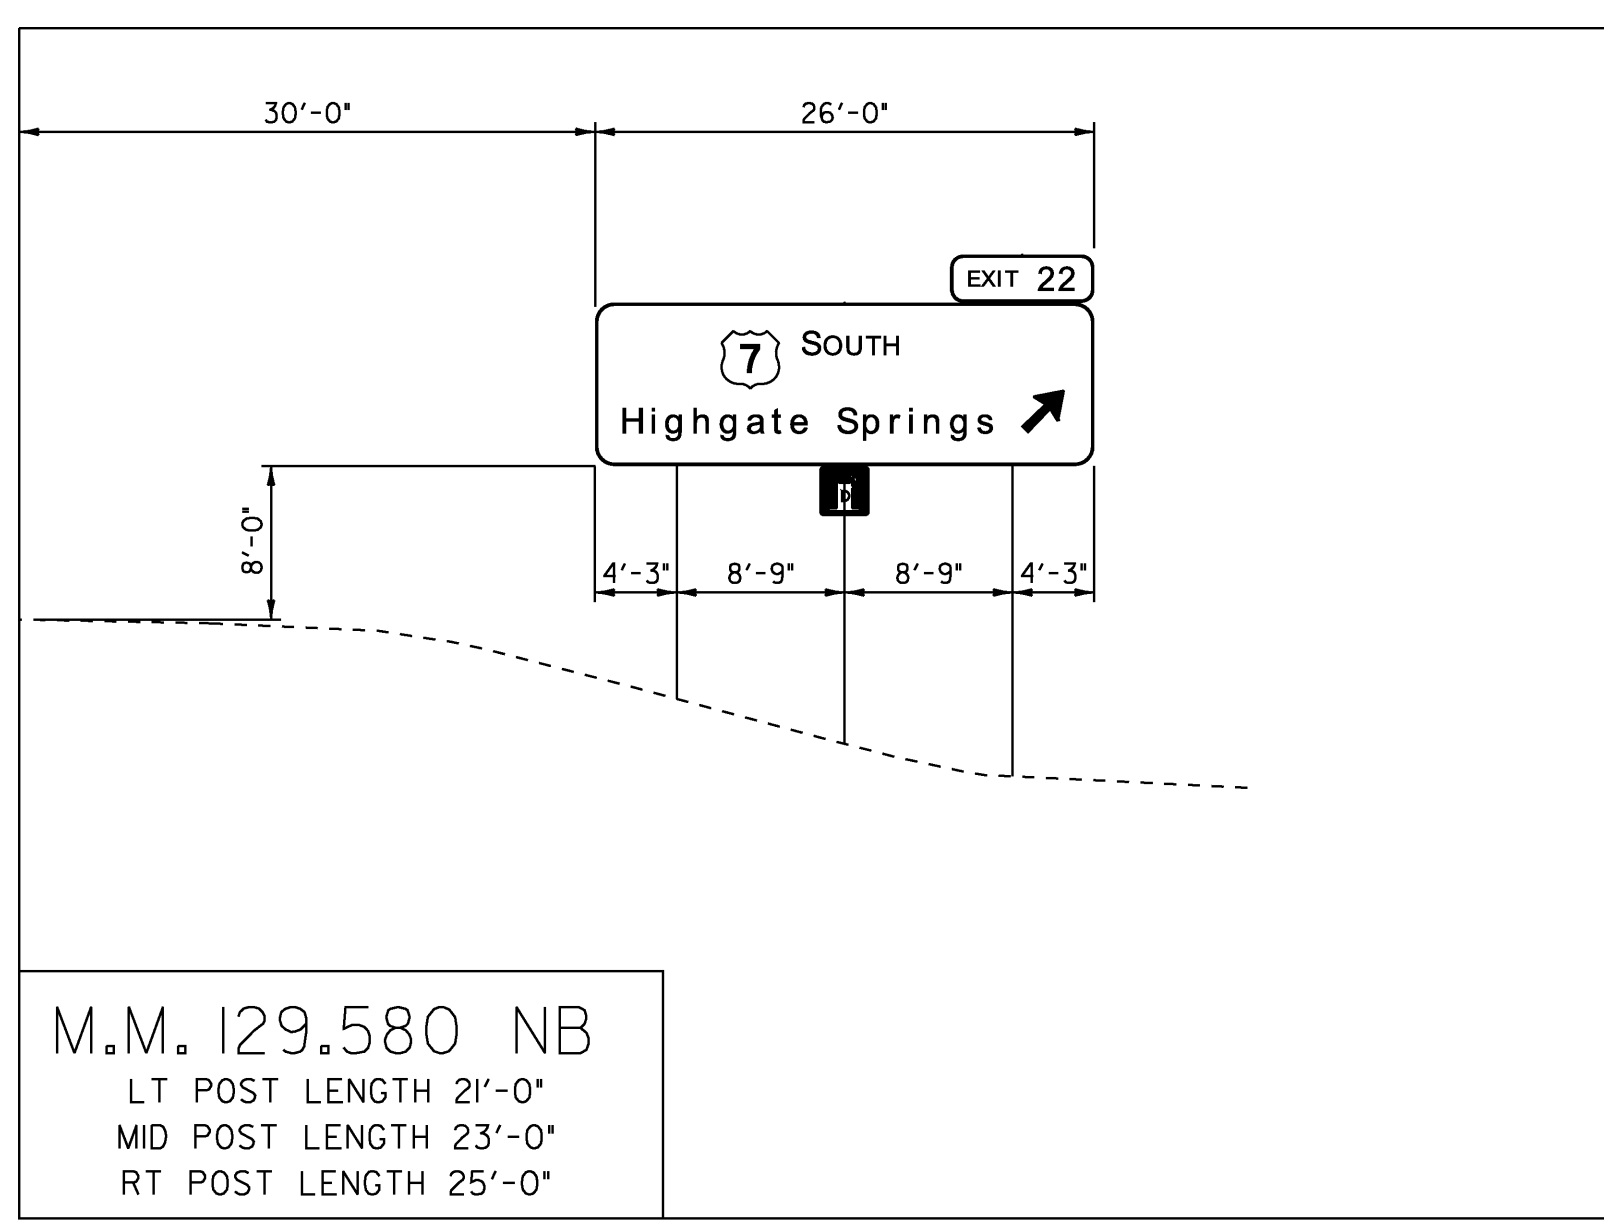

- NOTES:**
1. TYPICAL FOOTING BASE DEPTH IS PER STANDARD E-161, UNLESS SPECIFIED WITH THE NOTE: "SPECIAL 8' DEEP W-SHAPE FOOTING".
 2. THE SPECIAL W-SHAPE FOOTING DETAIL IS LOCATED ON THE INDEX OF SHEETS & GENERAL NOTES, SHEET 2.

SCALE 1" = 10'-0"
 10 0 10

**NORTHBOUND
 CROSS SECTIONS
 5**

COLCHESTER-HIGHGATE	
PROJECT NUMBER: IMG SIGN (17)	
FILE NAME: 09A016.DGN	PLOT DATE: 8/21/2009
PROJECT LEADER: EPD	DRAWN BY: JDG
DESIGNED BY: JDG	CHECKED BY: EPD
PLOT FILE: 09A016CS5.i	SHEET 54 OF 221