


MODEL 08-New

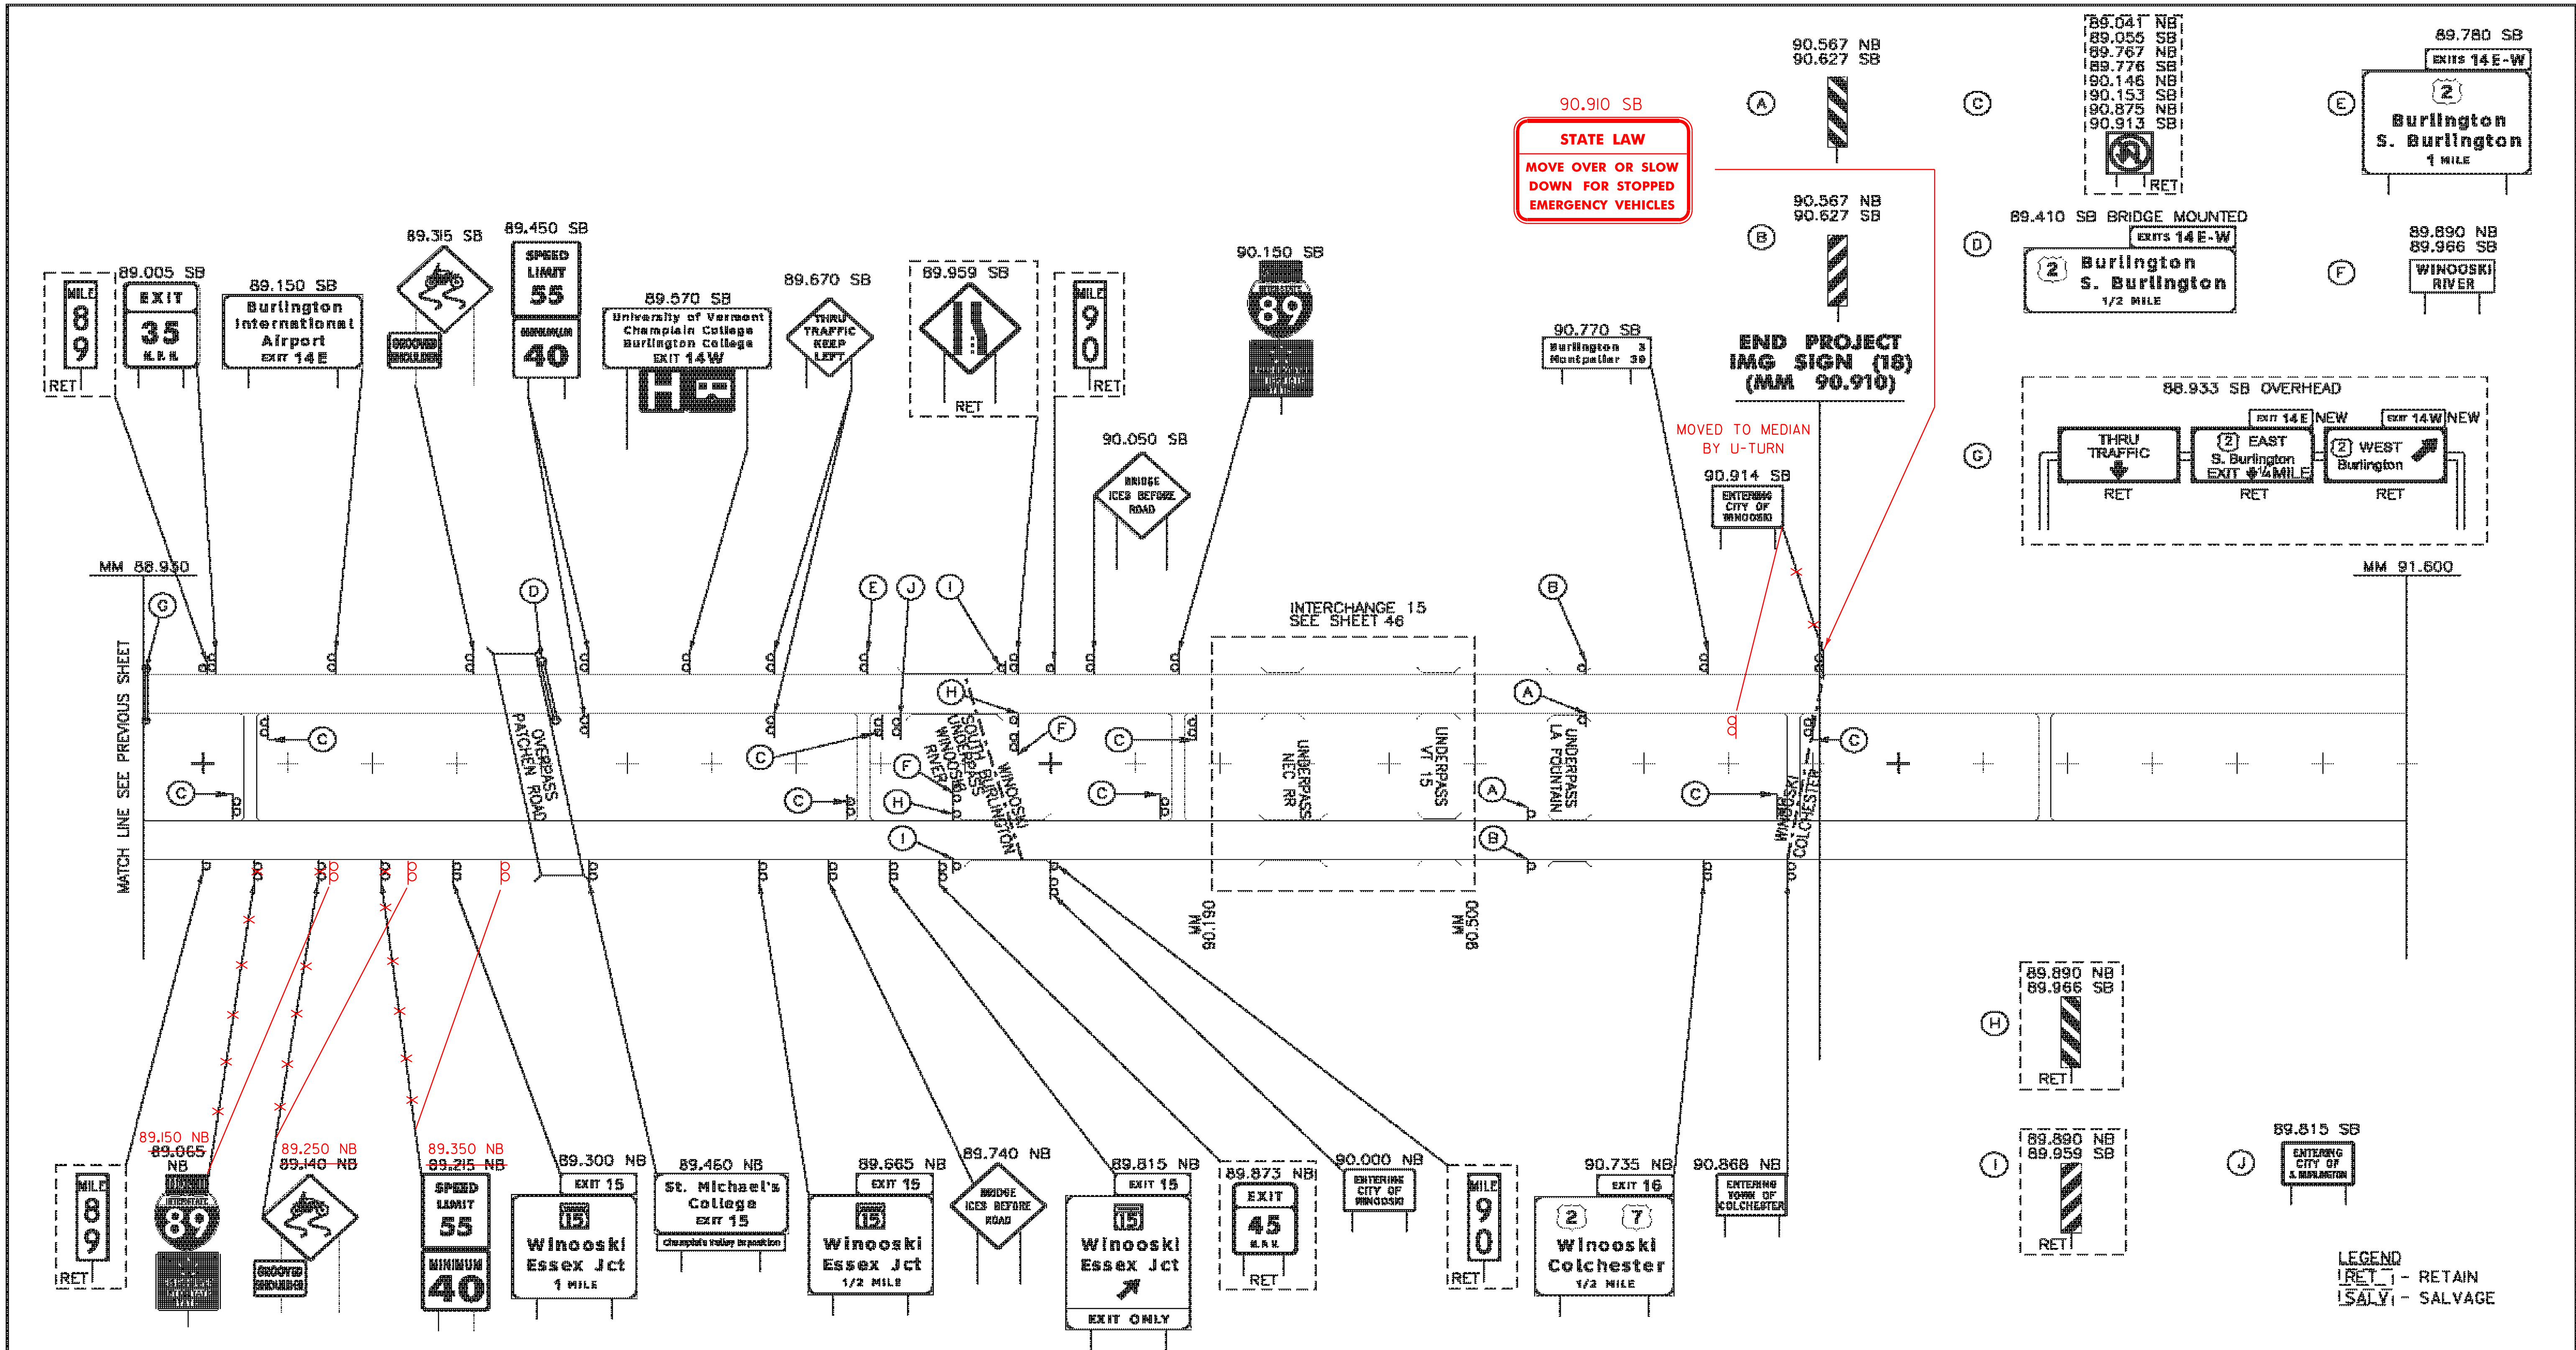

90.910 SB  
**STATE LAW**  
 MOVE OVER OR SLOW  
 DOWN FOR STOPPED  
 EMERGENCY VEHICLES

**END PROJECT  
 IMG SIGN (18)  
 (MM 90.910)**

MOVED TO MEDIAN  
 BY U-TURN

89.890 NB  
 89.966 SB  
 RET

89.890 NB  
 89.959 SB  
 RET

89.815 SB  
 ENTERING  
 CITY OF  
 WINDSOR

LEGEND  
 RET - RETAIN  
 SALV - SALVAGE

ALL SIGNS AND POSTS ARE NEW UNLESS OTHERWISE NOTED

<b>NEW SIGNS          MAINLINE (8)          88.930 - 91.600</b>	PROJECT NAME: WATERBURY - WINOOSKI
	PROJECT NUMBER: IMG SIGN(18)
FILE NAME: z09008mainline.dgn	PLOT DATE: 10/27/2008
PROJECT LEADER: CRB	DRAWN BY: JBZ
DESIGNED BY: BDB	CHECKED BY: DAM
CLD REF. NO.: 09-0124	SHEET 34 OF 174