


NOTE
FOR TYPICAL PLACEMENT OF DELINEATORS
SEE STANDARDS E-197 AND SHEET 4.

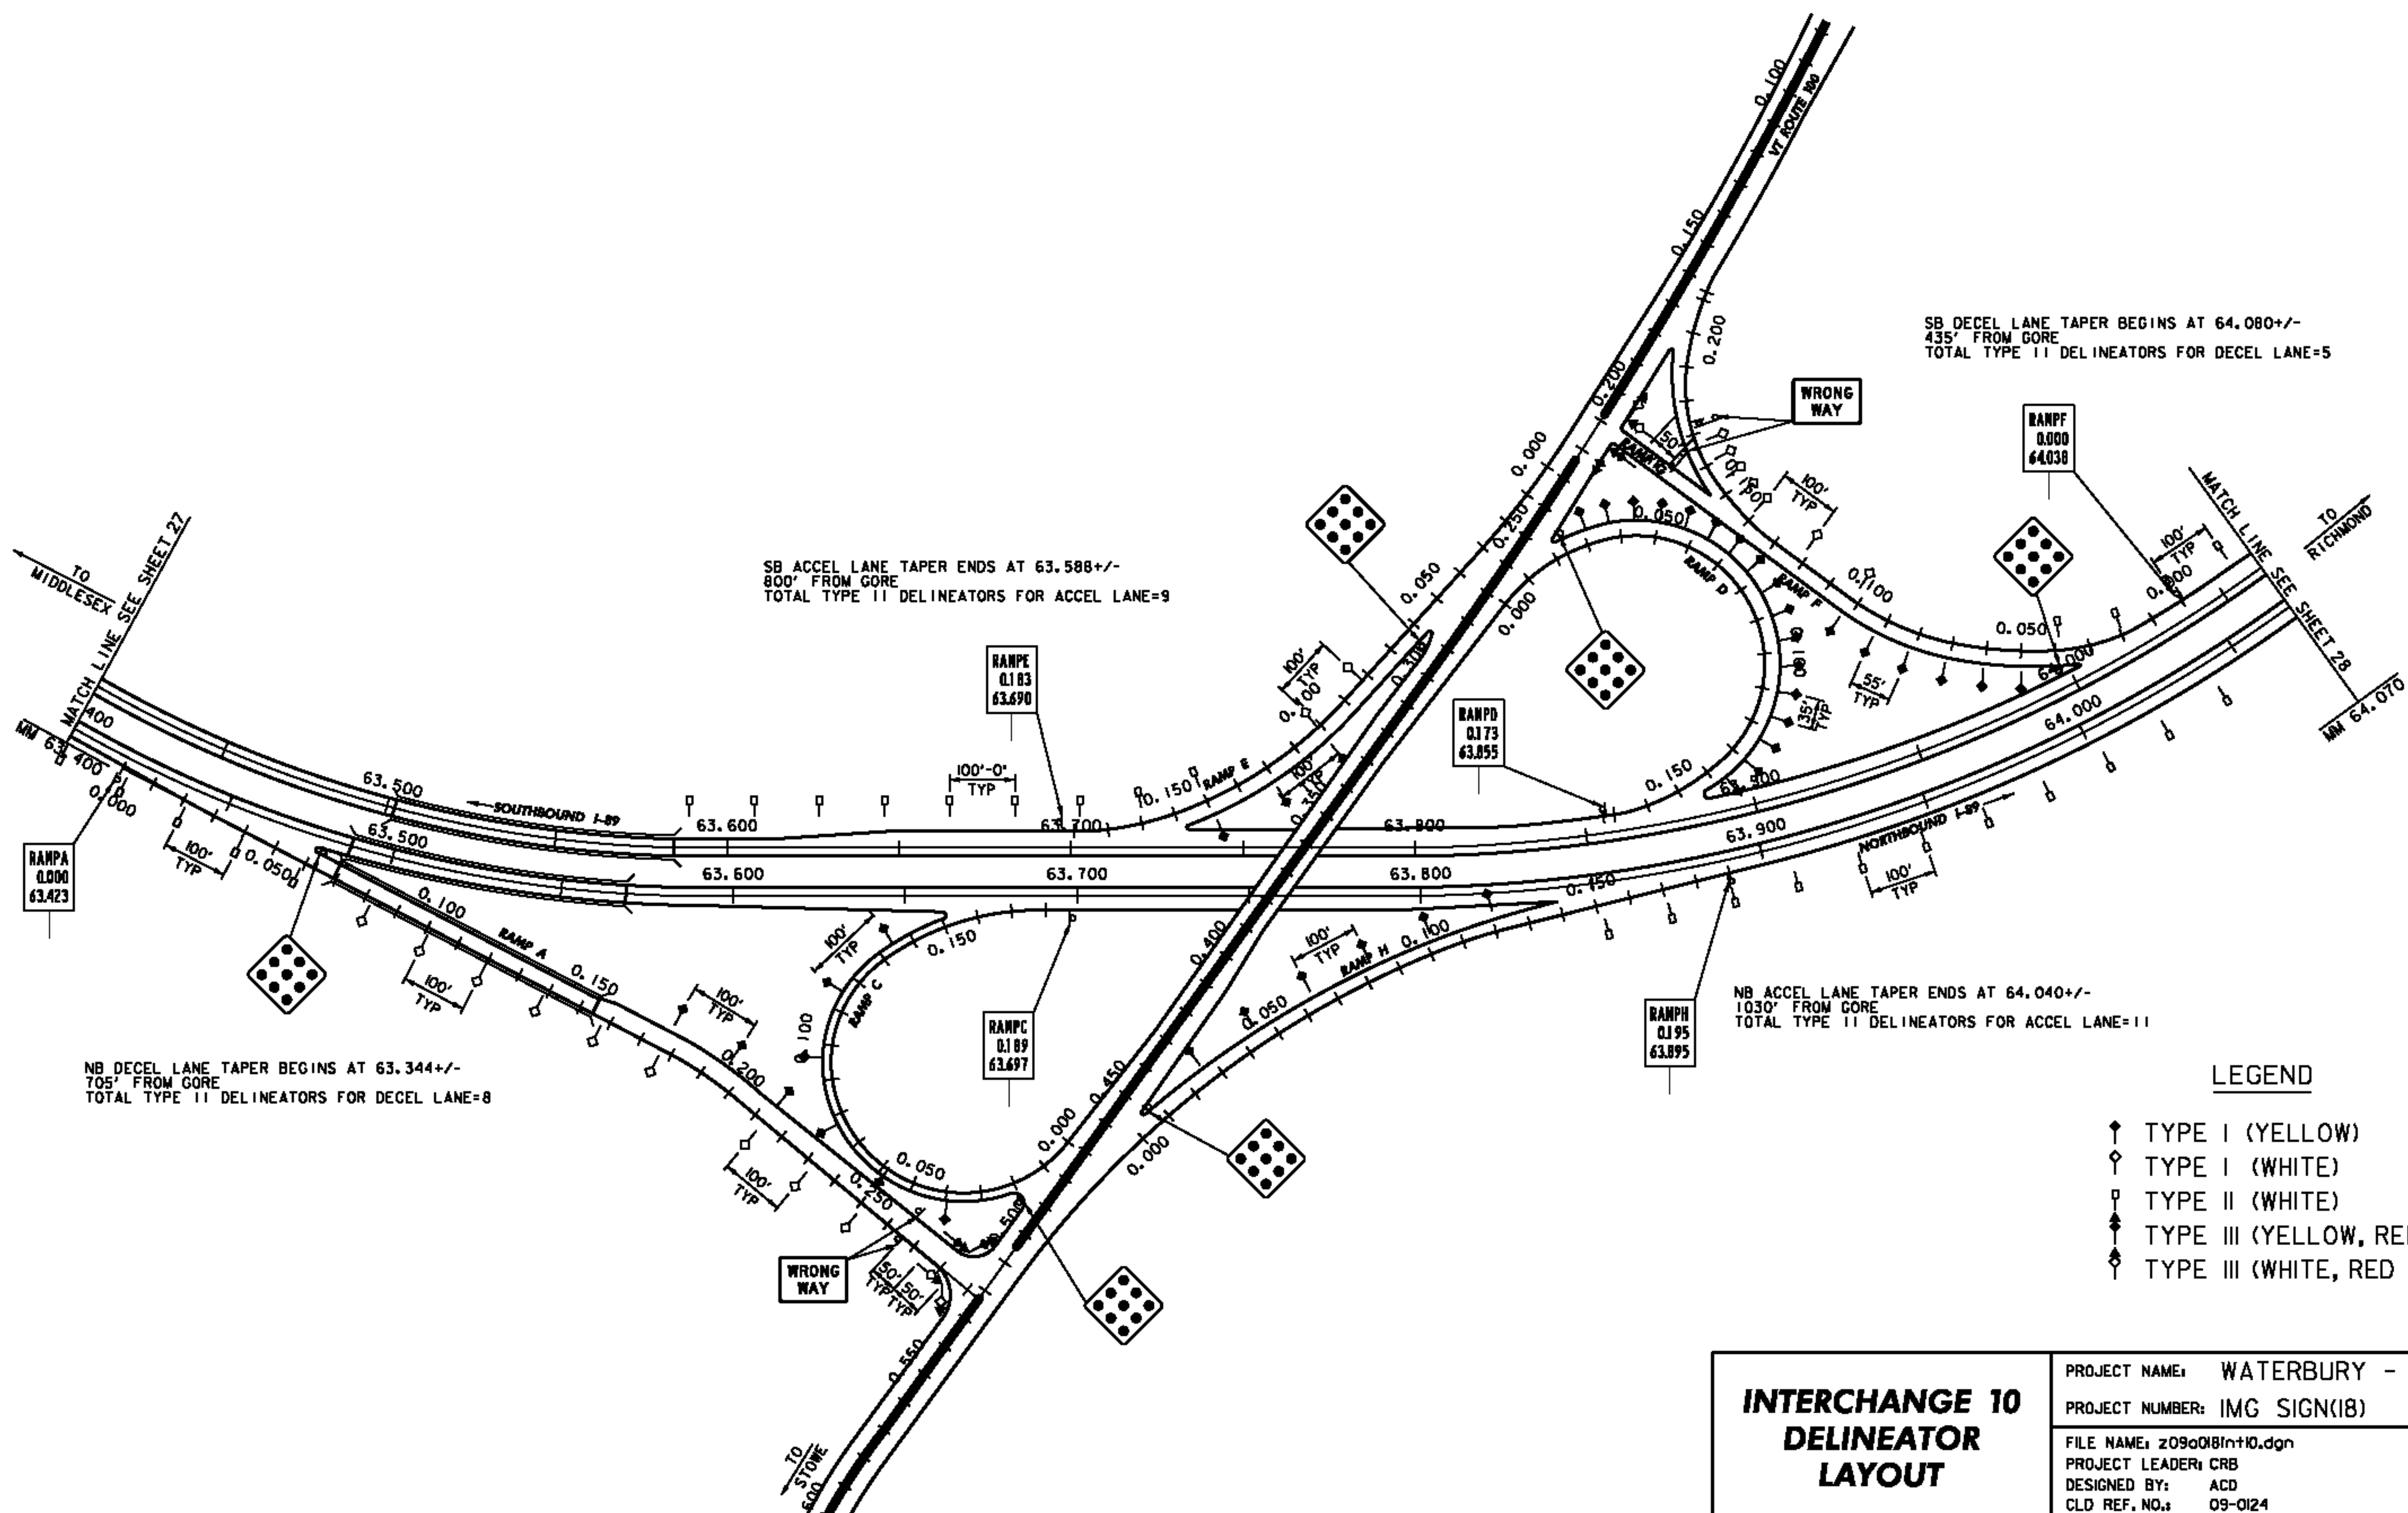

LEGEND

- ↑ TYPE I (YELLOW)
- ◇ TYPE I (WHITE)
- TYPE II (WHITE)
- ◆ TYPE III (YELLOW, RED ON BACK)
- ◊ TYPE III (WHITE, RED ON BACK)

**INTERCHANGE 10
DELINEATOR
LAYOUT**

| | |
|------------------------------------|-----------------------|
| PROJECT NAME: WATERBURY - WINOOSKI | PLOT DATE: 10/27/2009 |
| PROJECT NUMBER: IMG SIGN(18) | DRAWN BY: JBZ |
| FILE NAME: z09a018Int10.dgn | CHECKED BY: BDB |
| PROJECT LEADER: CRB | SHEET 47 OF 174 |
| DESIGNED BY: ACD | |
| CLD REF. NO.: 09-0124 | |