


NOTE  
FOR TYPICAL PLACEMENT OF DELINEATORS  
SEE STANDARDS E-197 AND SHEET 4.

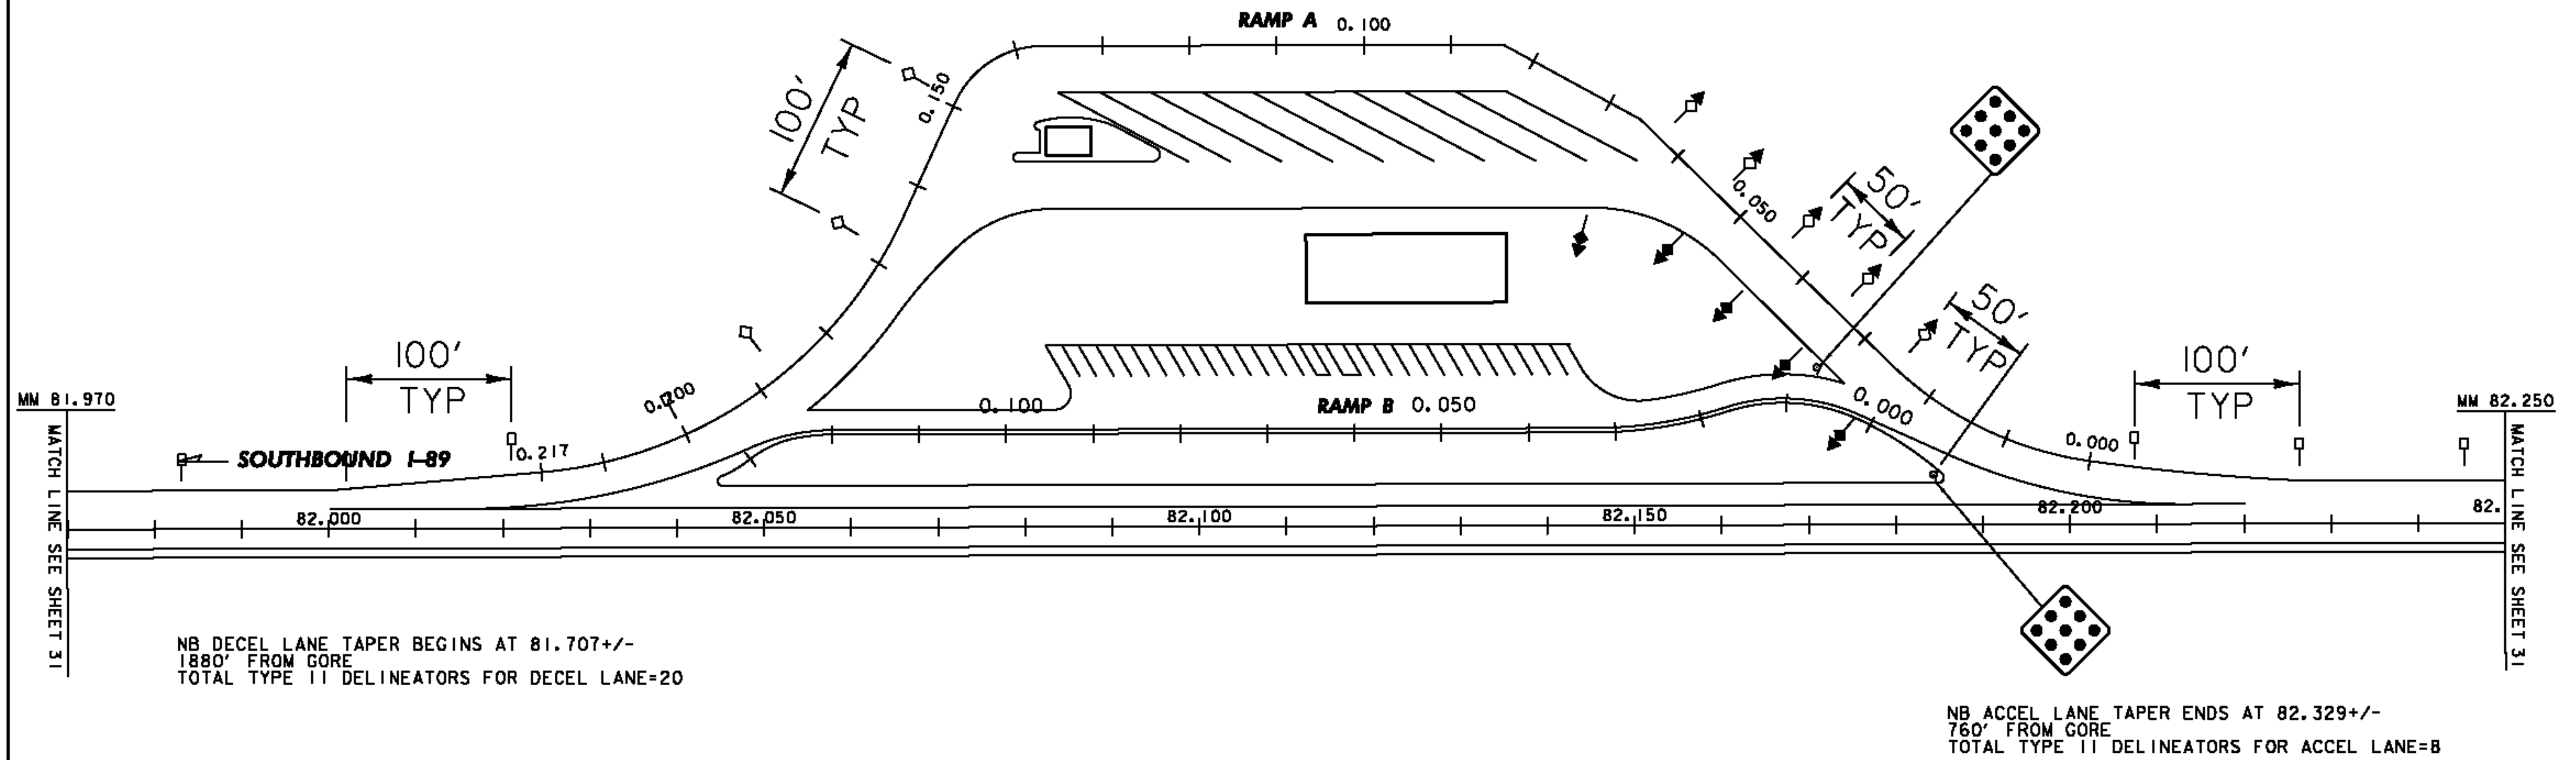

**LEGEND**

- ◆ TYPE I (YELLOW)
- ◇ TYPE I (WHITE)
- TYPE II (WHITE)
- ◆ TYPE III (YELLOW, RED ON BACK)
- ◇ TYPE III (WHITE, RED ON BACK)

**REST AREA  
WILLISTON SB  
DELINEATOR  
LAYOUT  
MM 82.140**

PROJECT NAME: WATERBURY - WINOOSKI	PLOT DATE: 10/27/2009
PROJECT NUMBER: IMG SIGN(18)	DRAWN BY: JBZ
FILE NAME: z09a018rest-SB(82).dgn	CHECKED BY: BDB
PROJECT LEADER: CRB	SHEET 52 OF 174
DESIGNED BY: ACD	
CLD REF. NO.: 09-0124	