


NOTE  
FOR TYPICAL PLACEMENT OF DELINEATORS  
SEE STANDARDS E-197 AND SHEET 4.

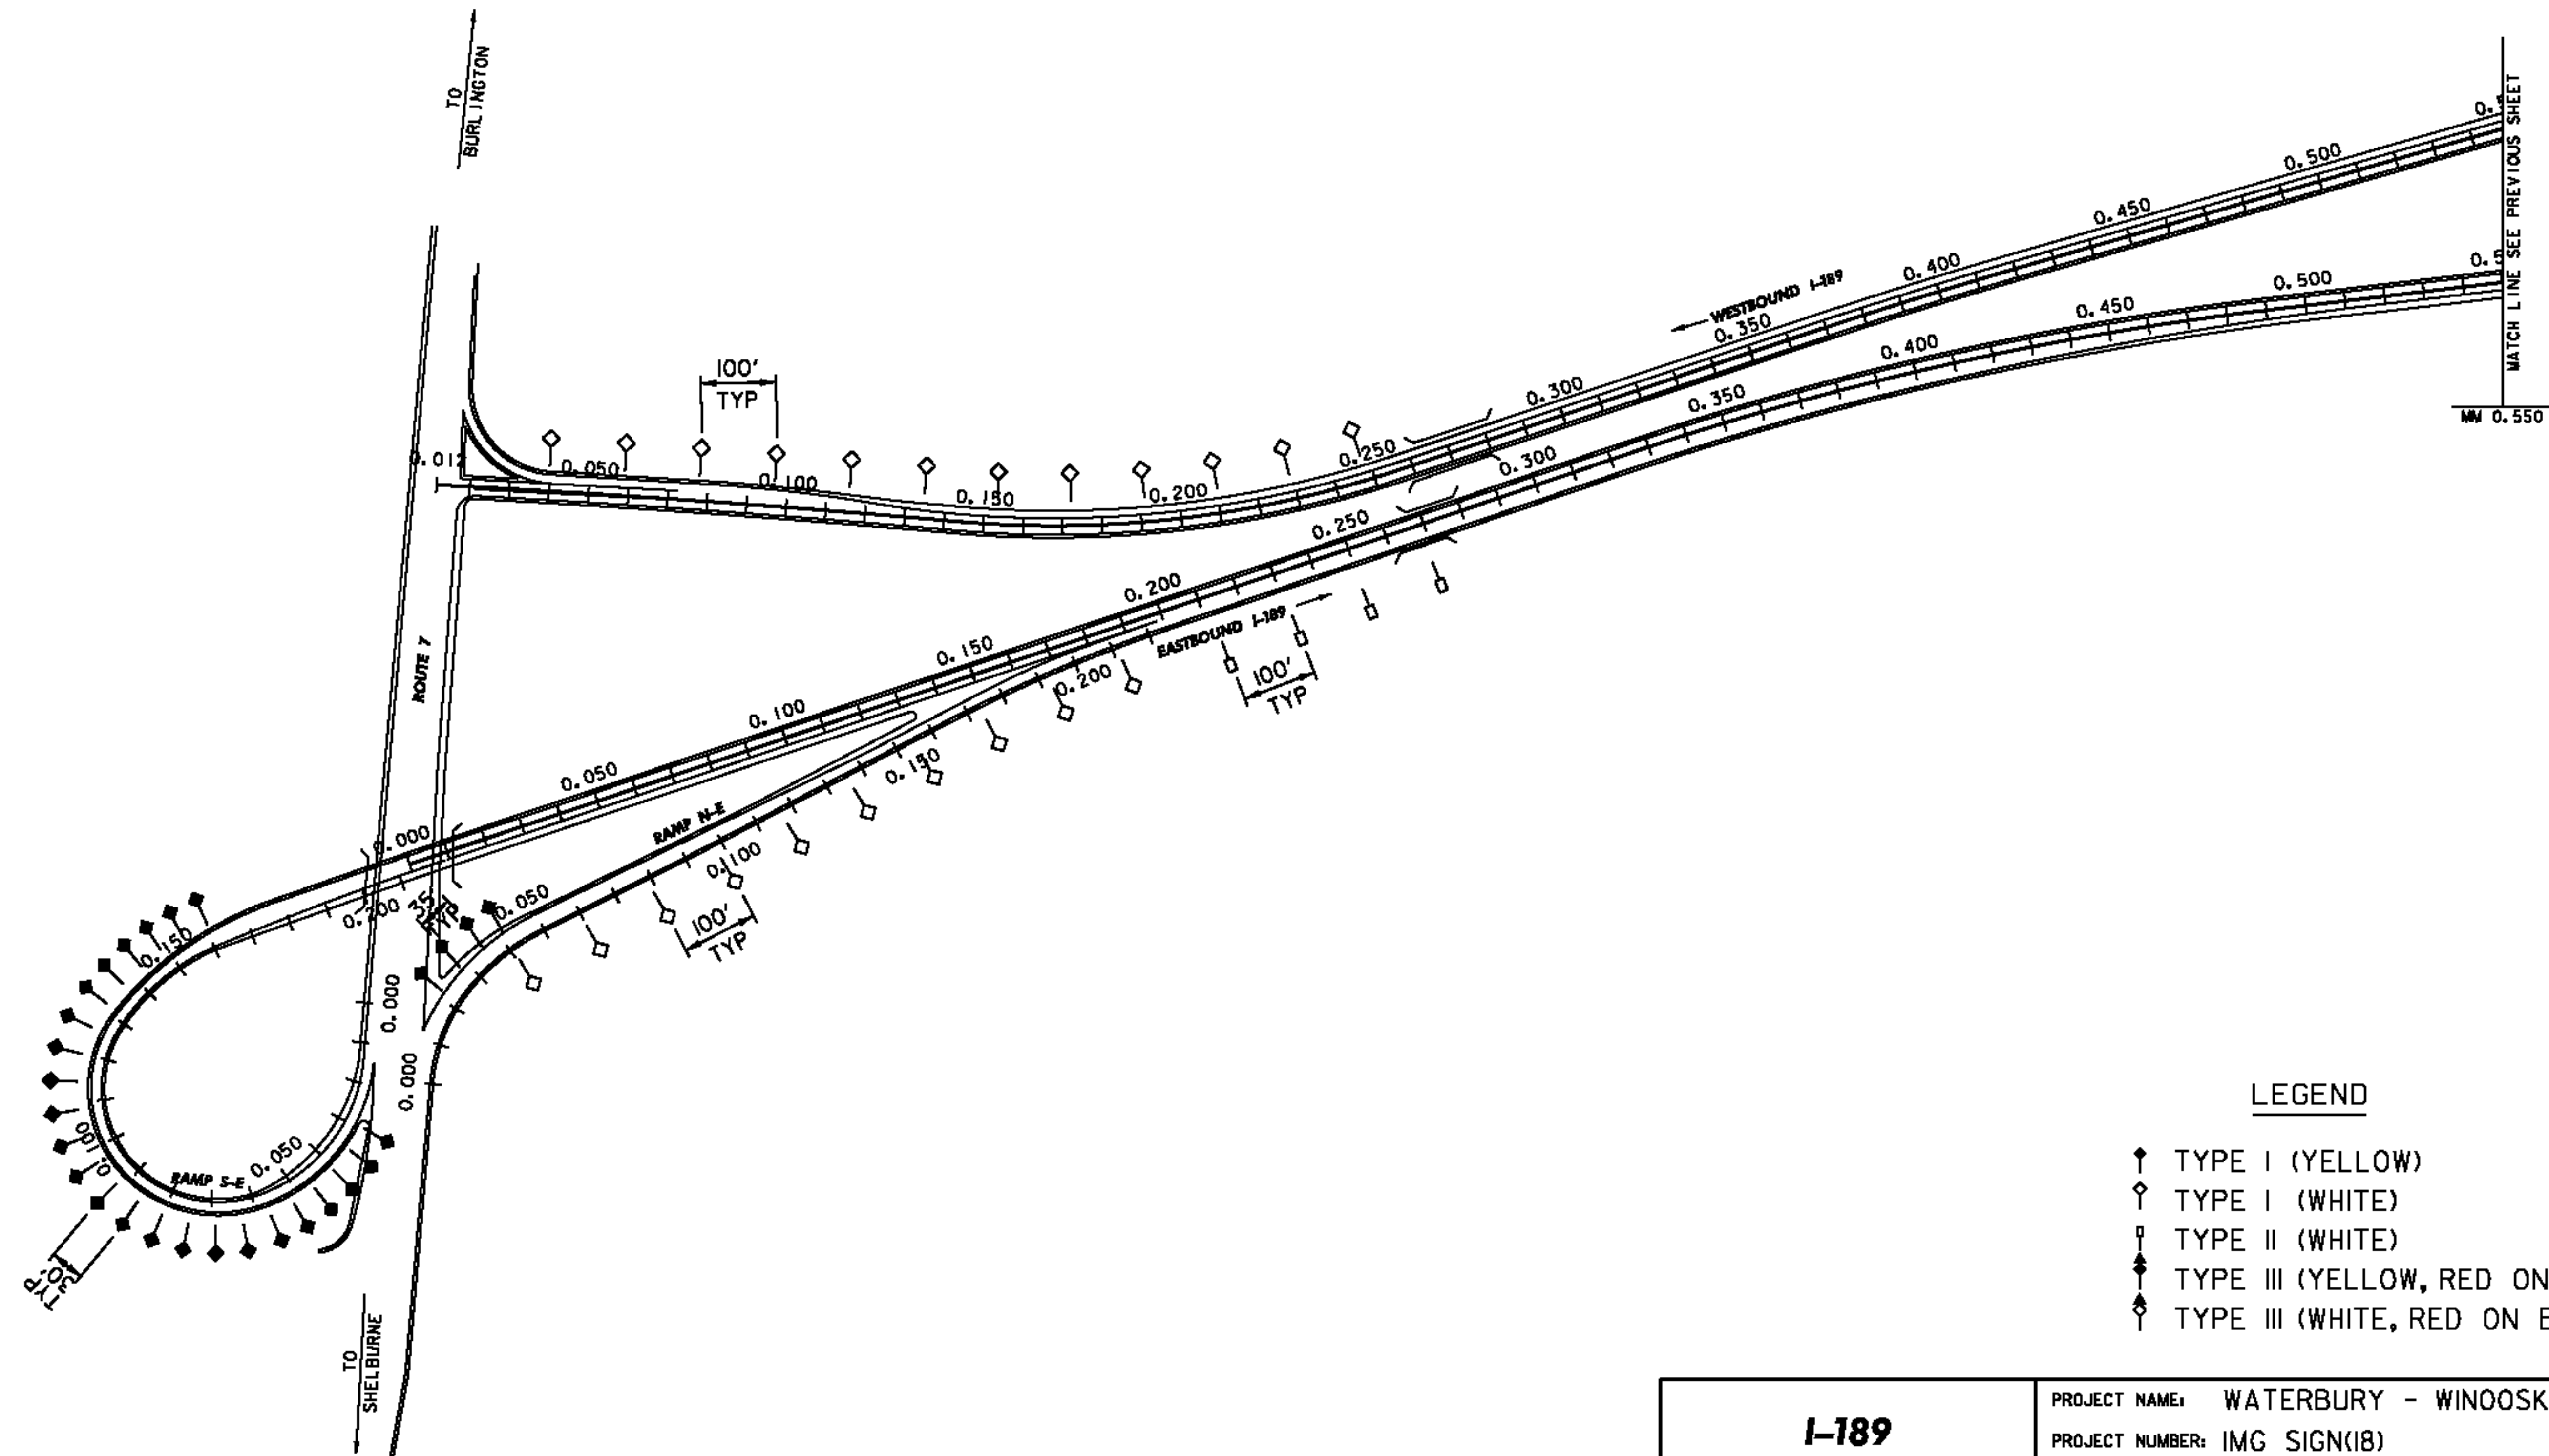

LEGEND

- ◆ TYPE I (YELLOW)
- ◇ TYPE I (WHITE)
- ⊥ TYPE II (WHITE)
- ◆ TYPE III (YELLOW, RED ON BACK)
- ⊥ TYPE III (WHITE, RED ON BACK)

**I-189  
DELINEATOR  
LAYOUT**

PROJECT NAME: WATERBURY - WINOOSKI

PROJECT NUMBER: IMG SIGN(18)

FILE NAME: z09a018int13.dgn

PROJECT LEADER: CRB

DESIGNED BY: ACD

CLD REF. NO.: 09-0124

PLOT DATE: 10/27/2009

DRAWN BY: JBZ

CHECKED BY: BDB

SHEET 56 OF 174