


MODEL: 01

DIMENSIONS FOR CRITICAL OFFSETS OR CLEARANCES SHOWN FOR CONVENIENCE, REFER TO STANDARD SHEET E-120 FOR PLACEMENT GUIDELINES.

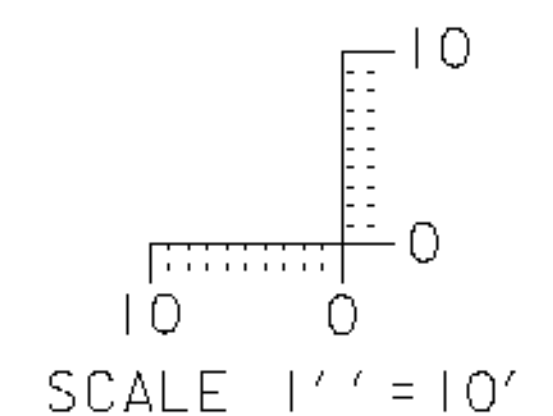

CROSS SECTION SHEET 1

PROJECT NAME: WATERBURY - WINOOSKI
 PROJECT NUMBER: IMG SIGN(18)
 FILE NAME: z09a018xs.dgn
 PROJECT LEADER: CRB
 DESIGNED BY: JBZ
 CLD REF. NO.: 09-0124
 PLOT DATE: 10/27/2009
 DRAWN BY: JBZ
 CHECKED BY: BDB
 SHEET 154 OF 174