
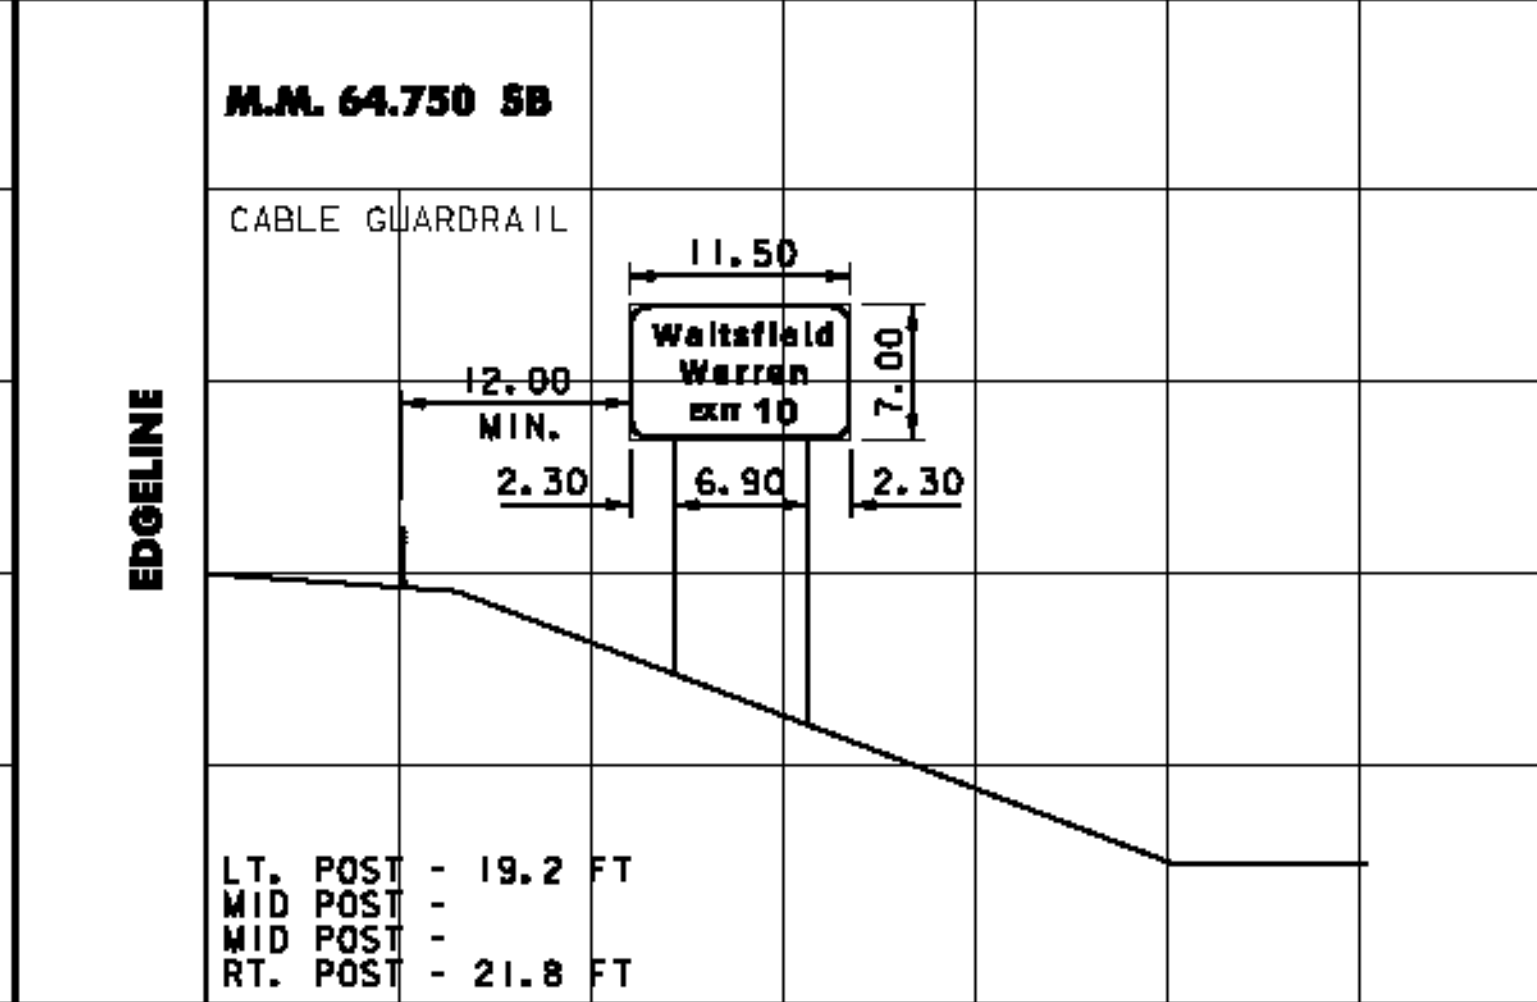
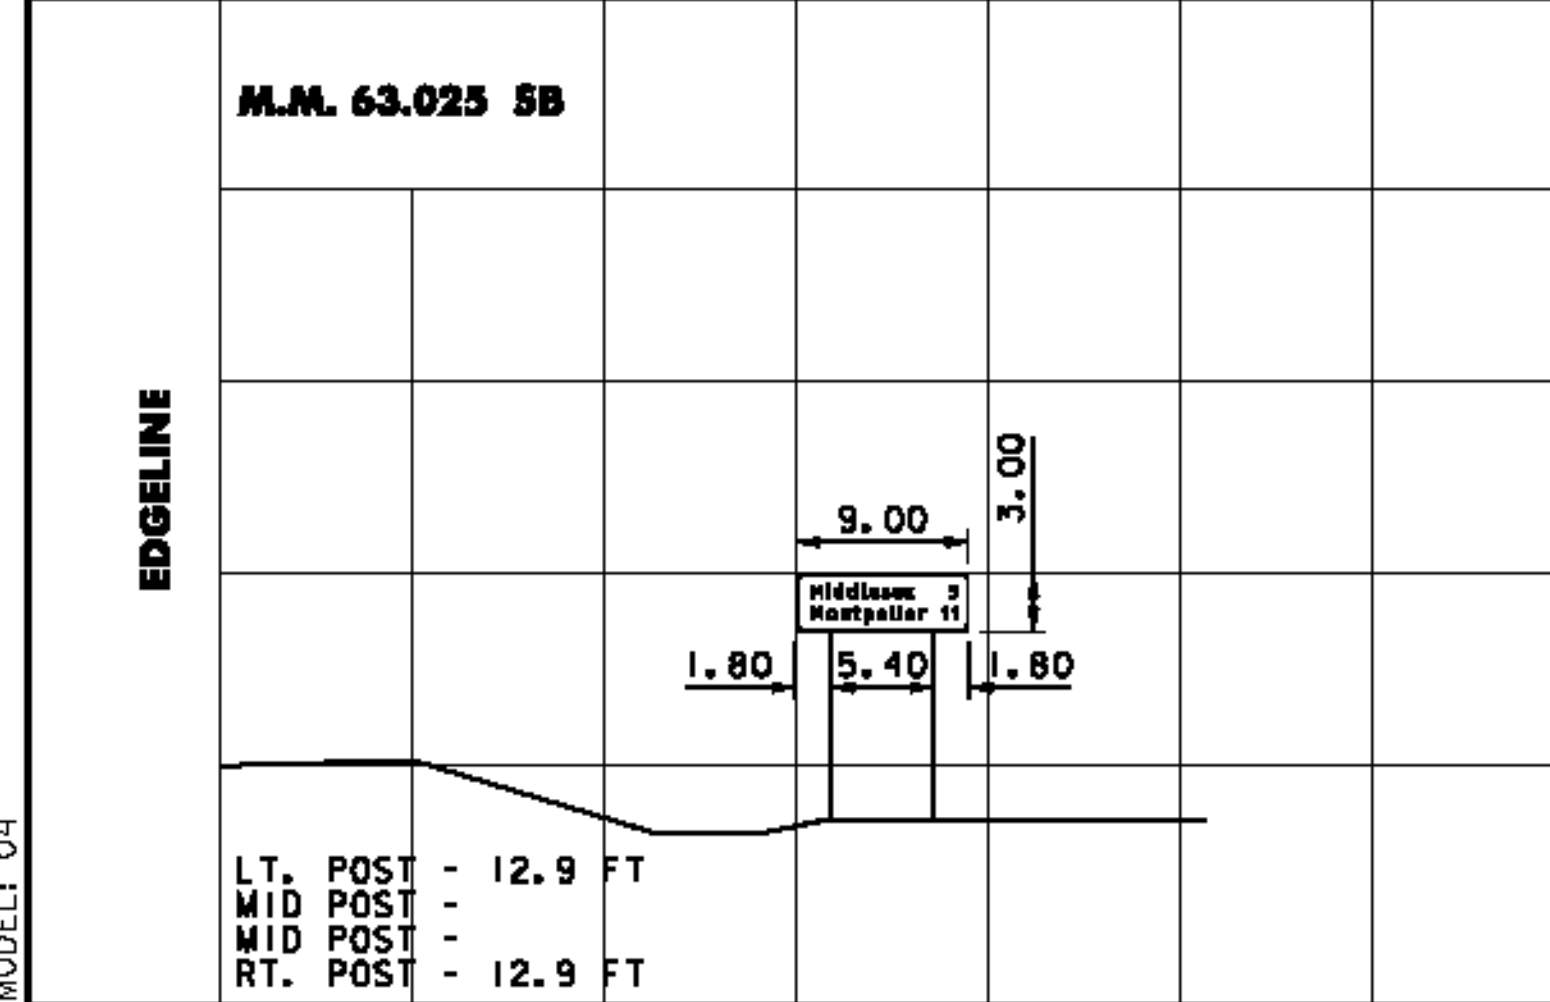
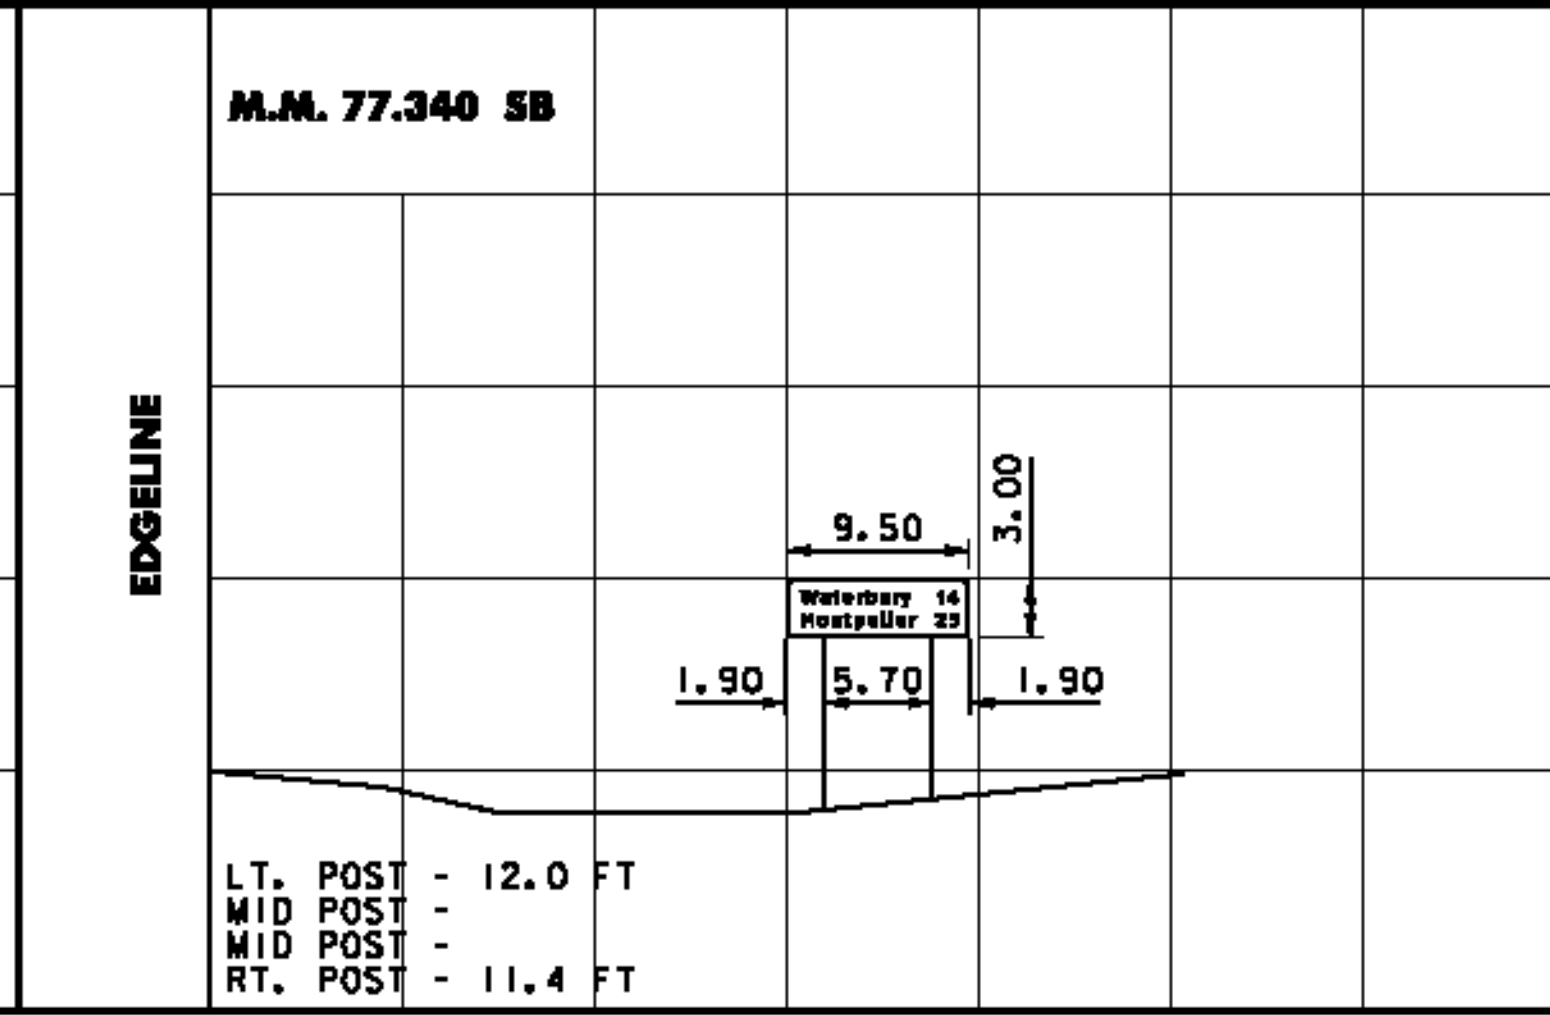
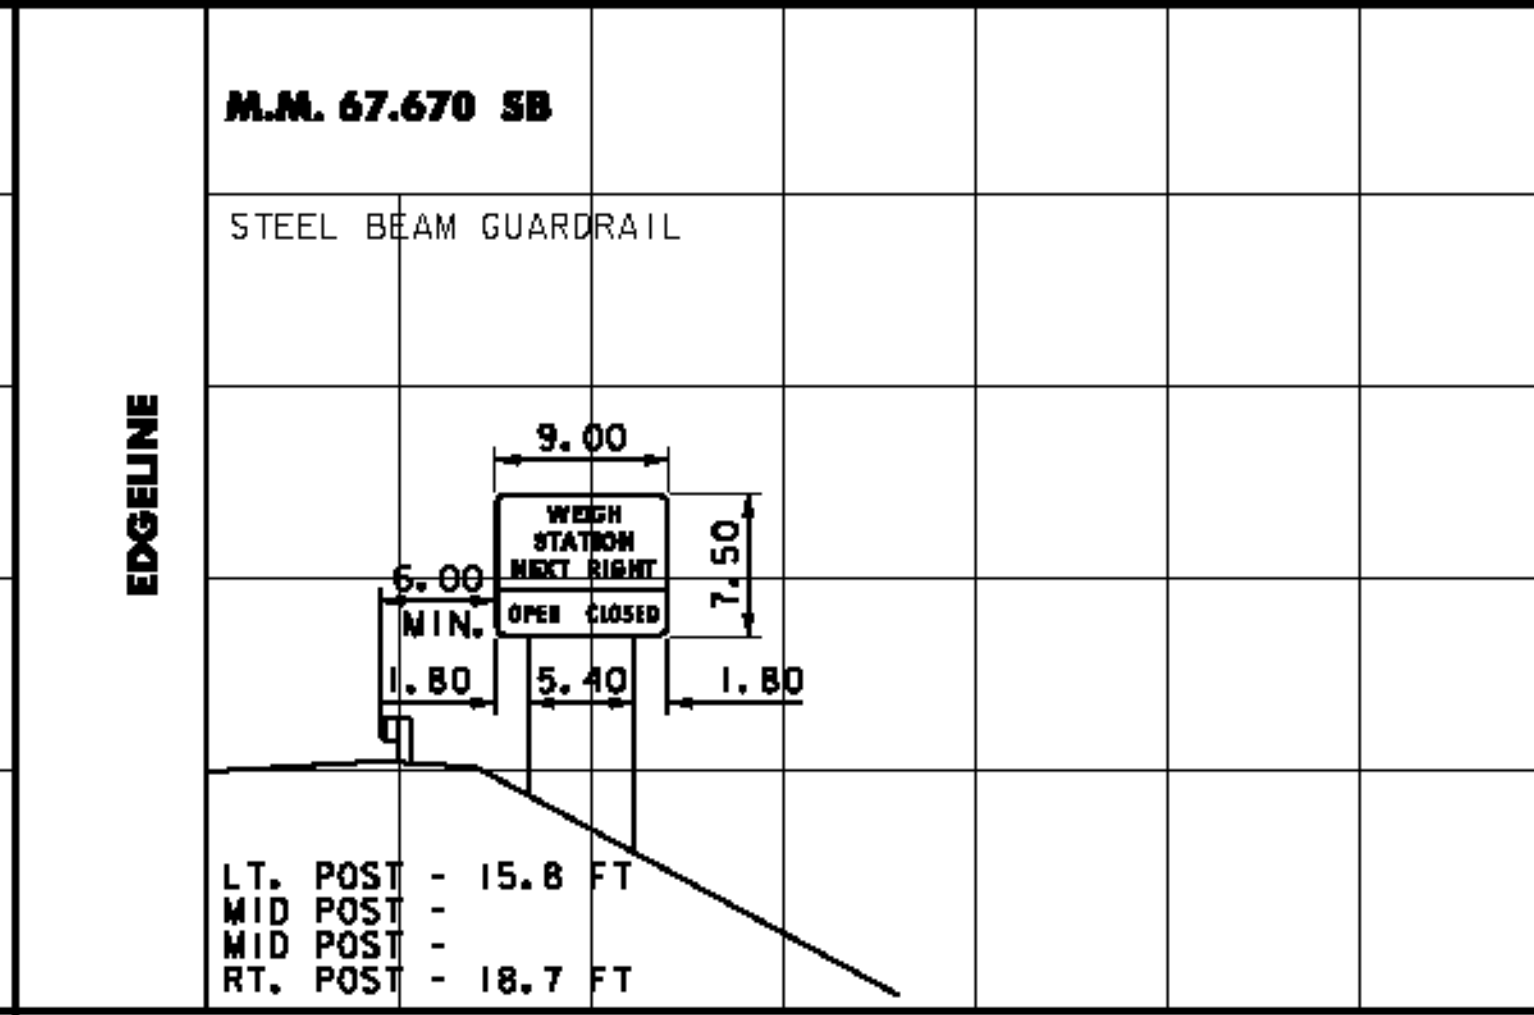
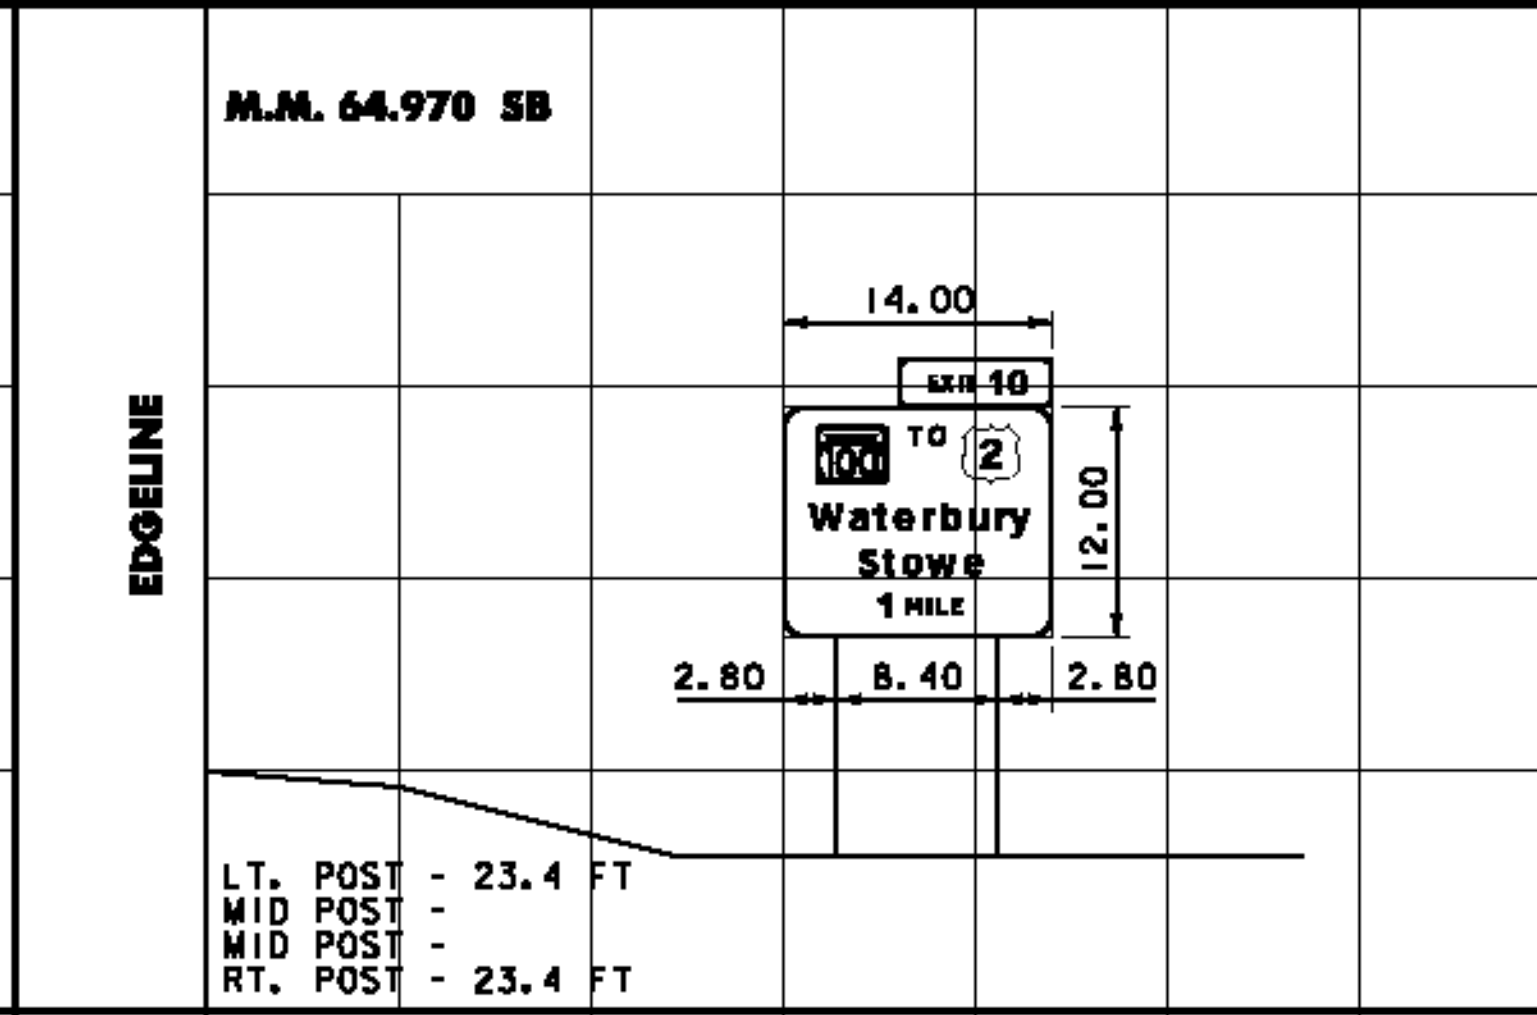
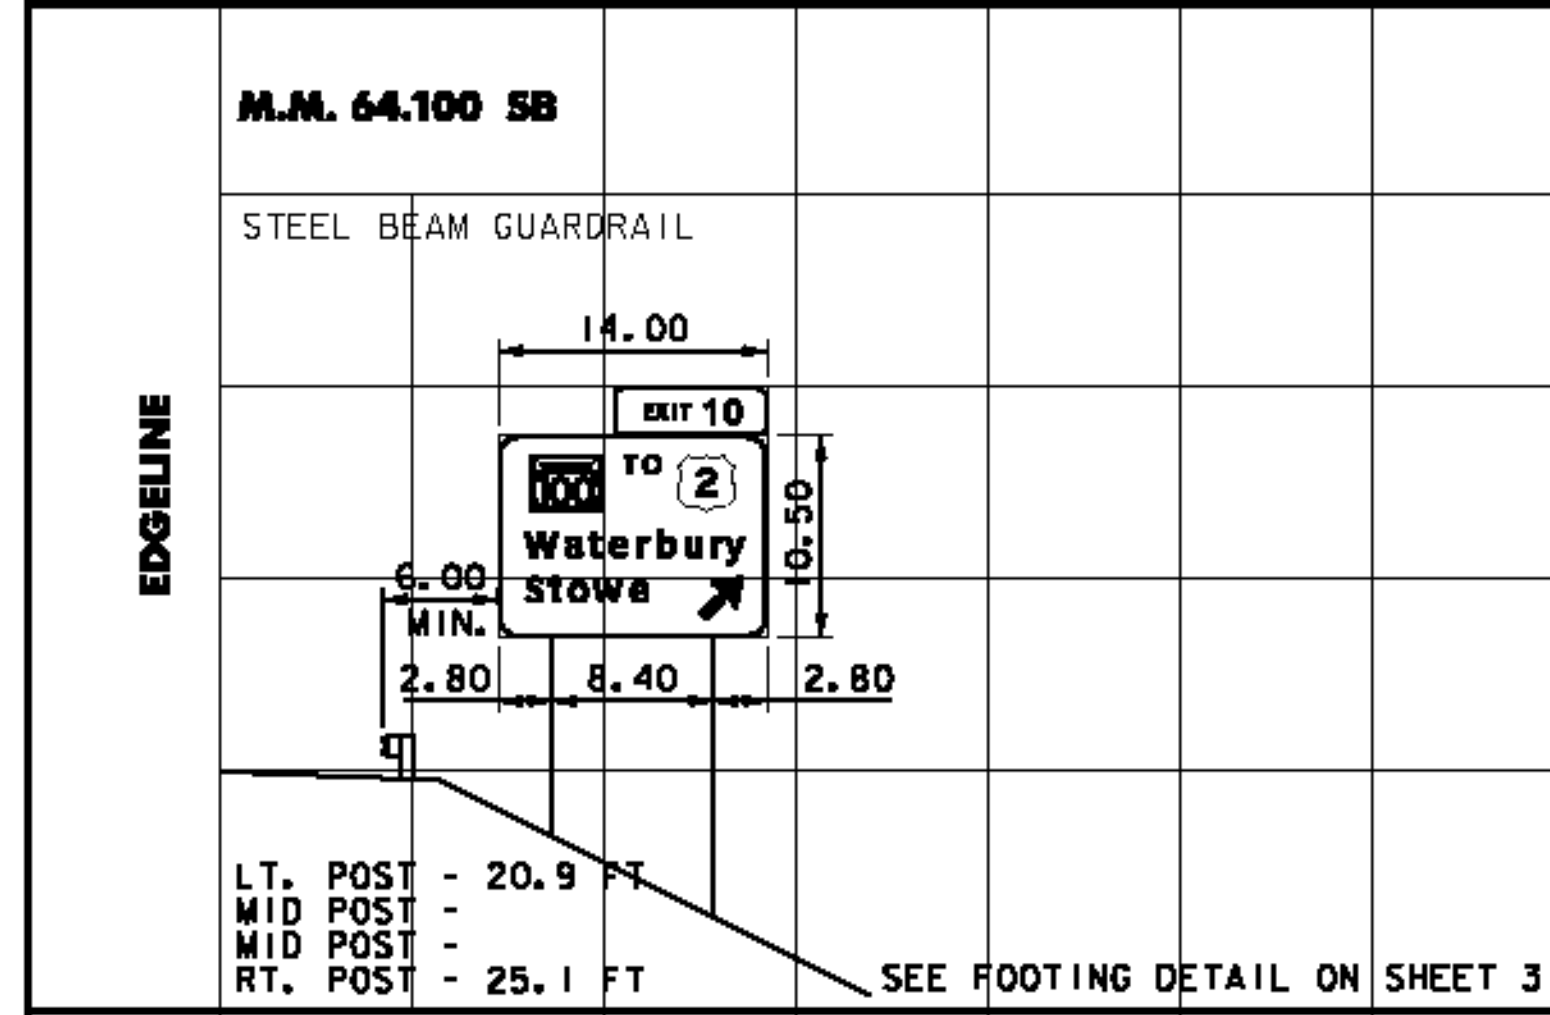
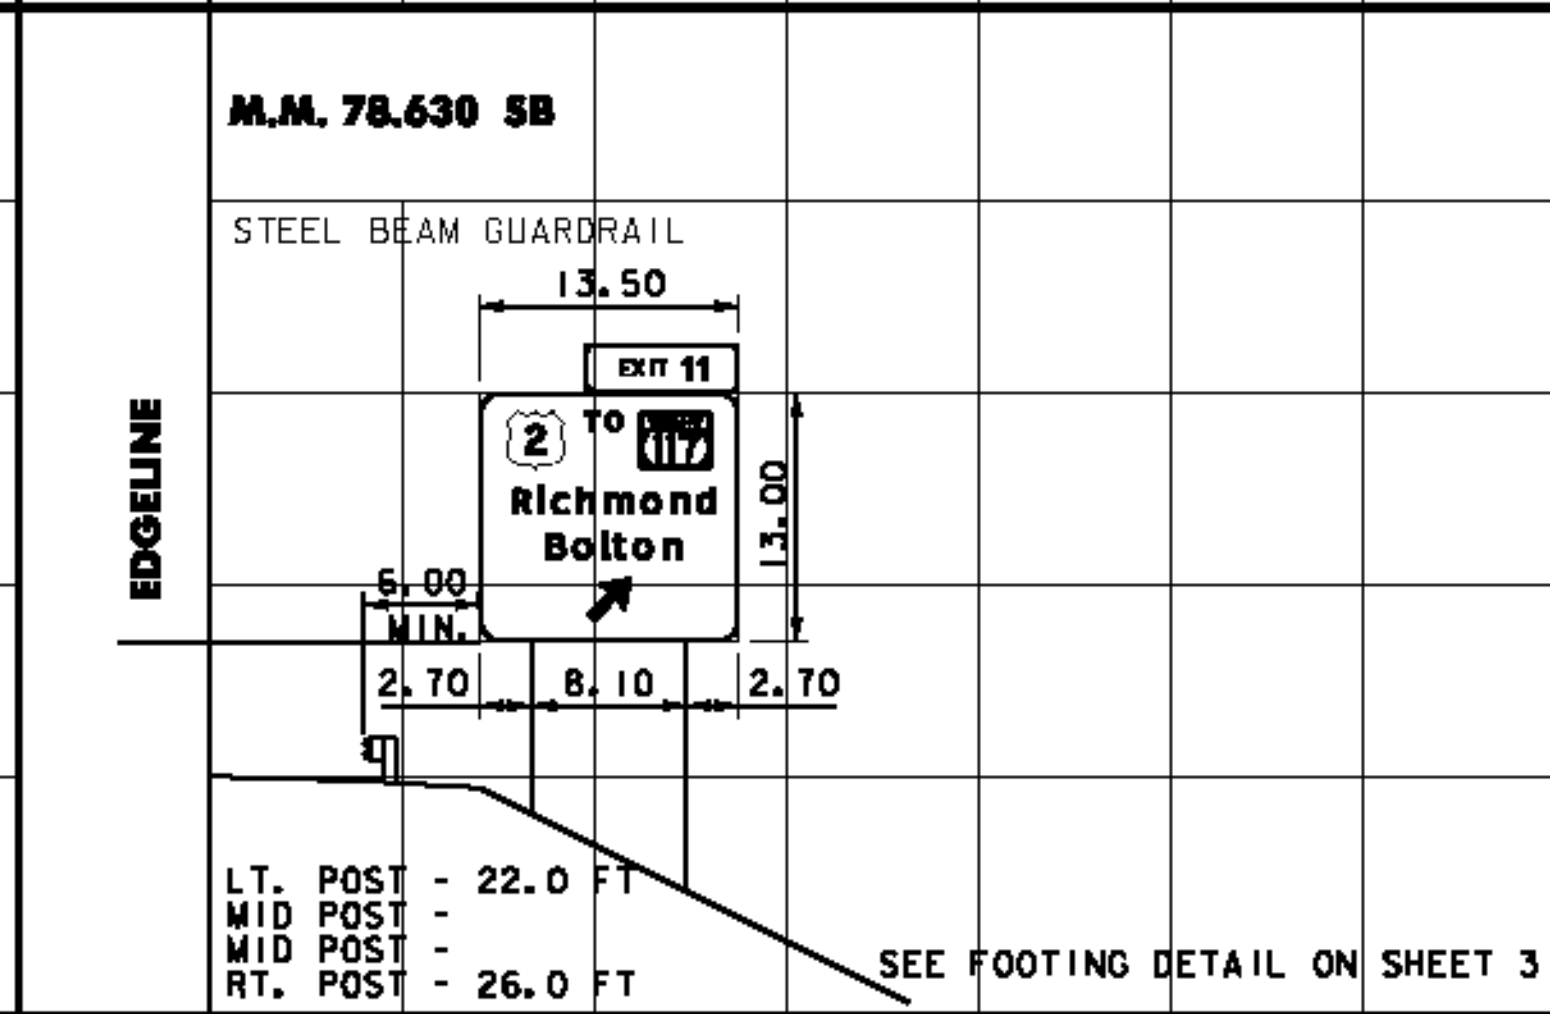
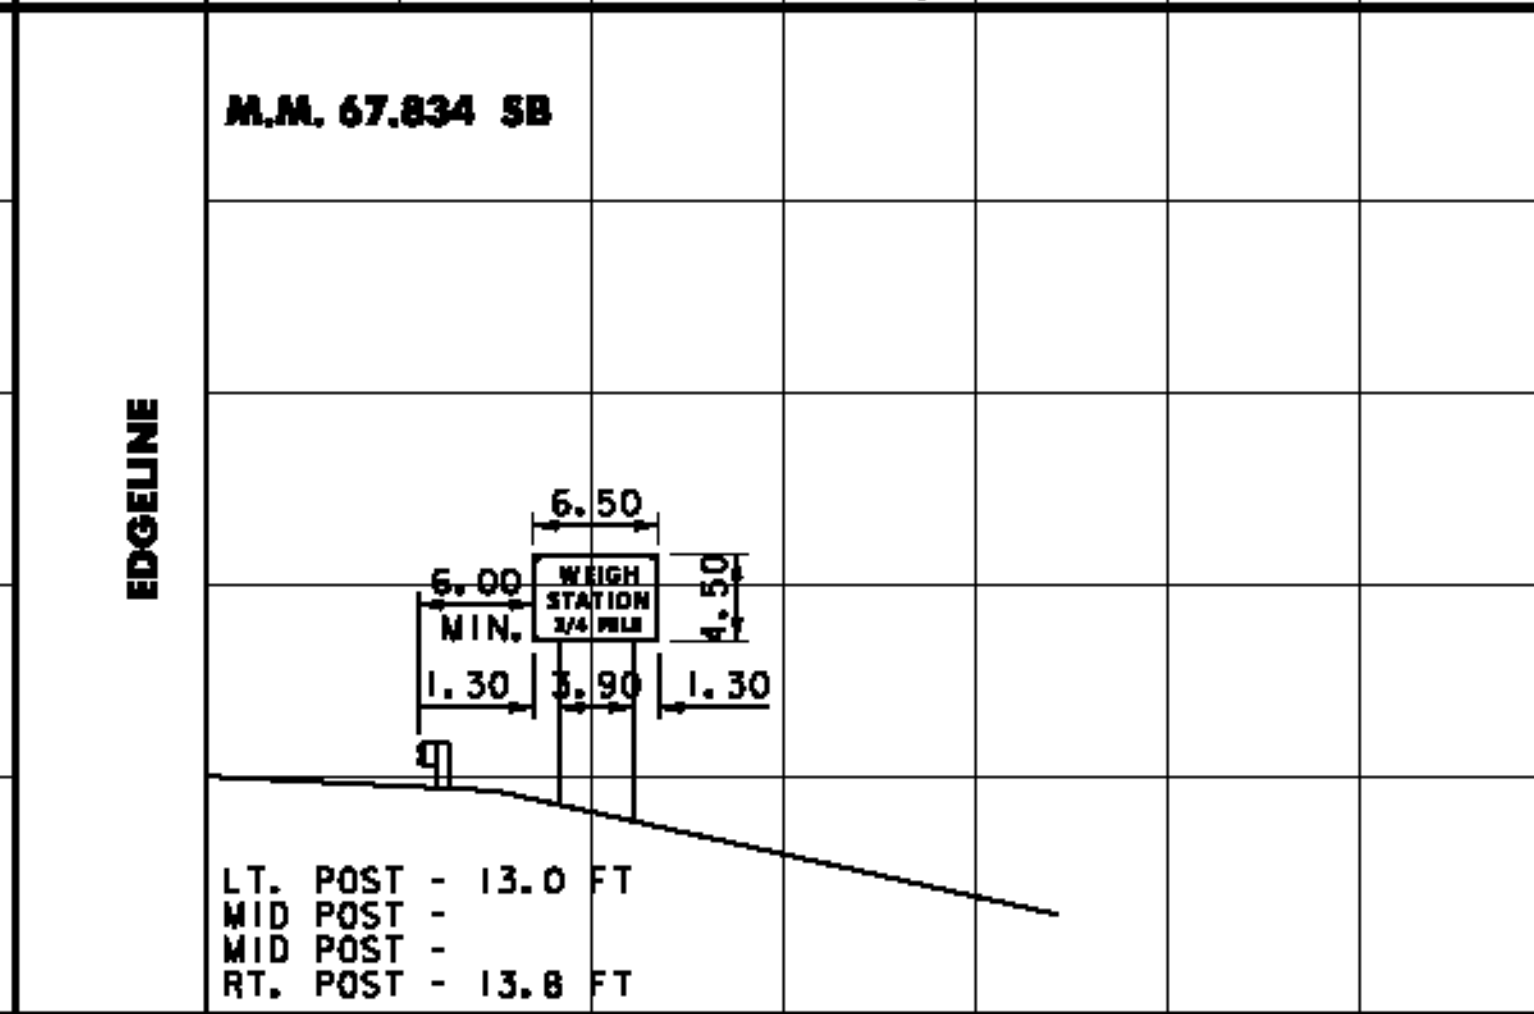
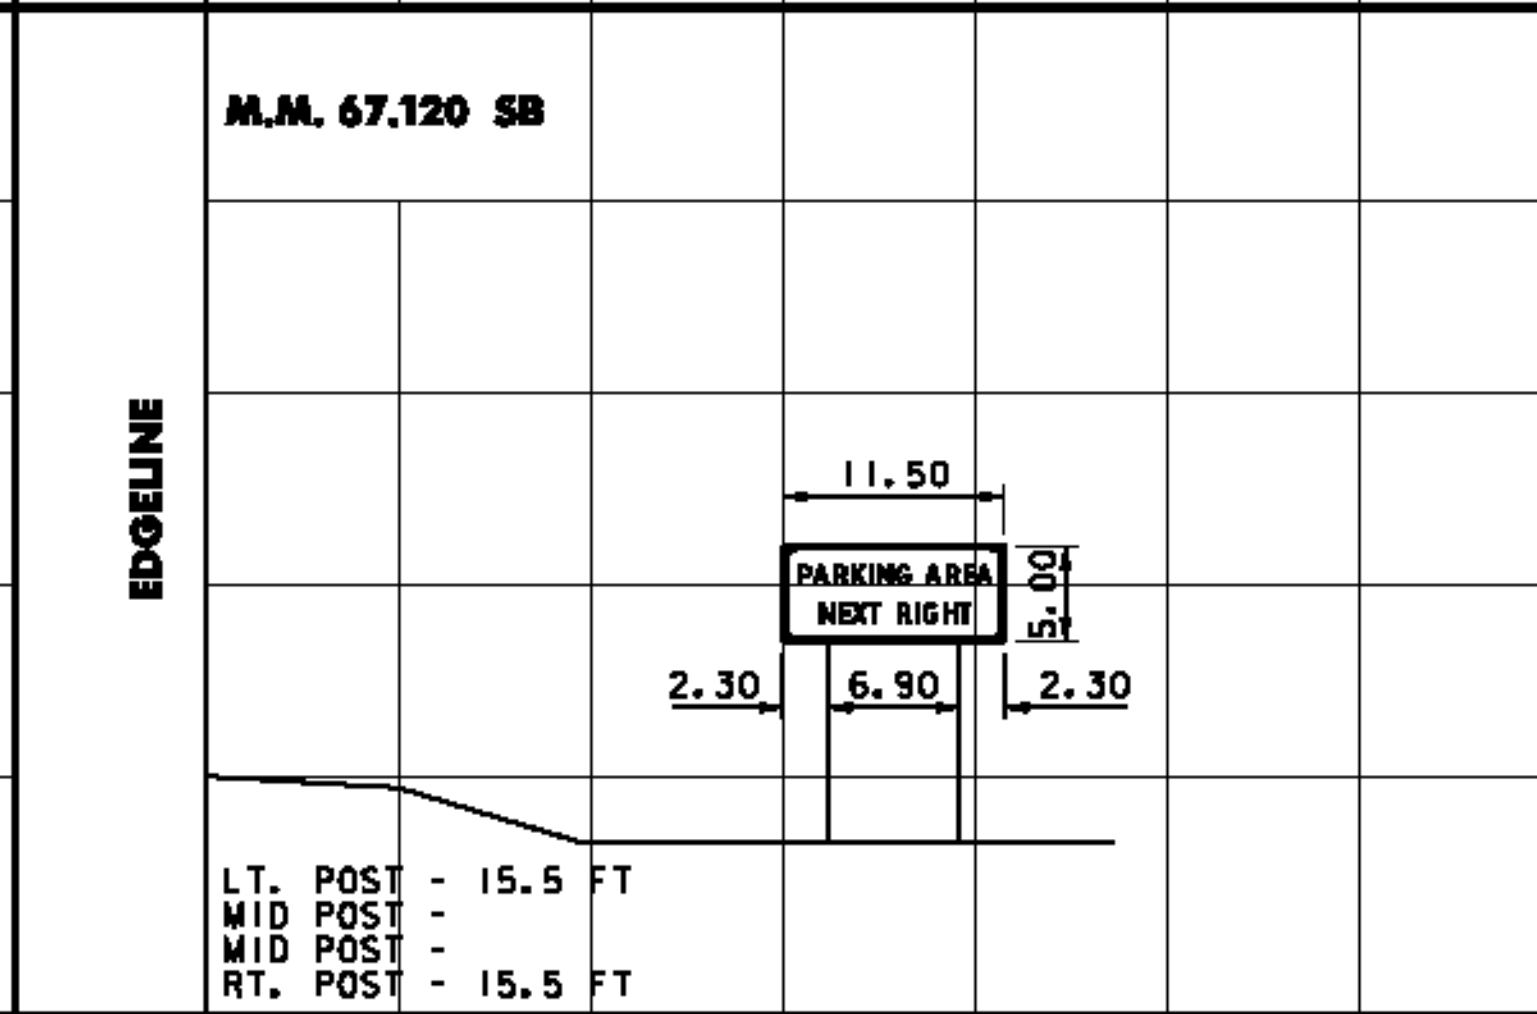
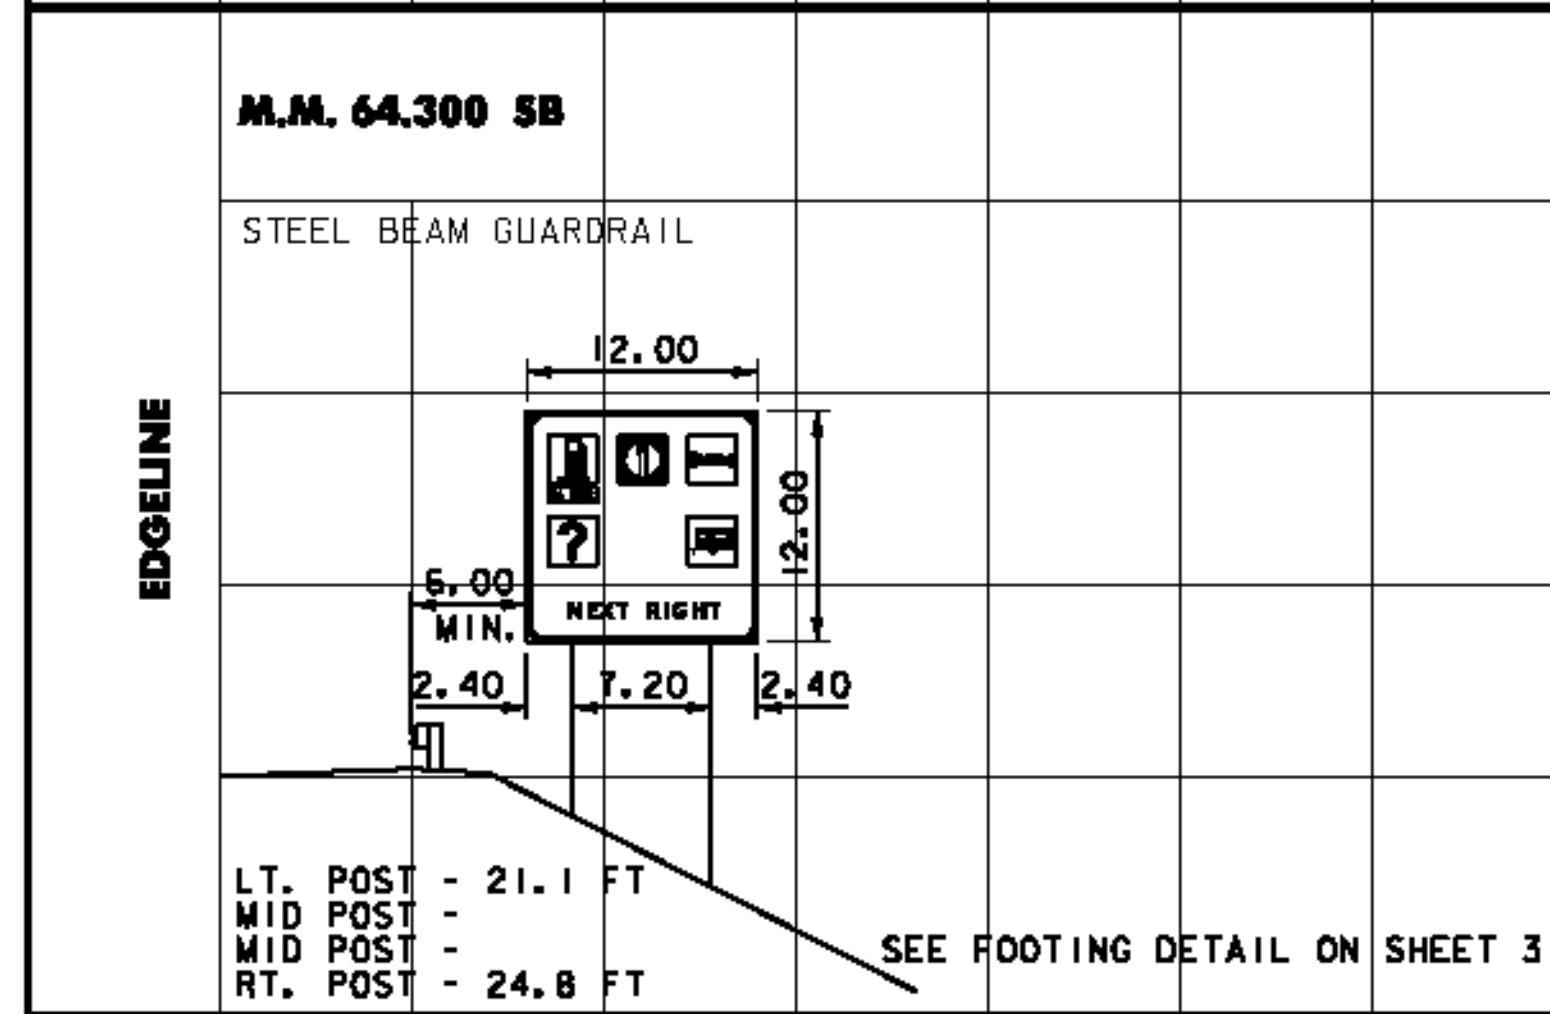
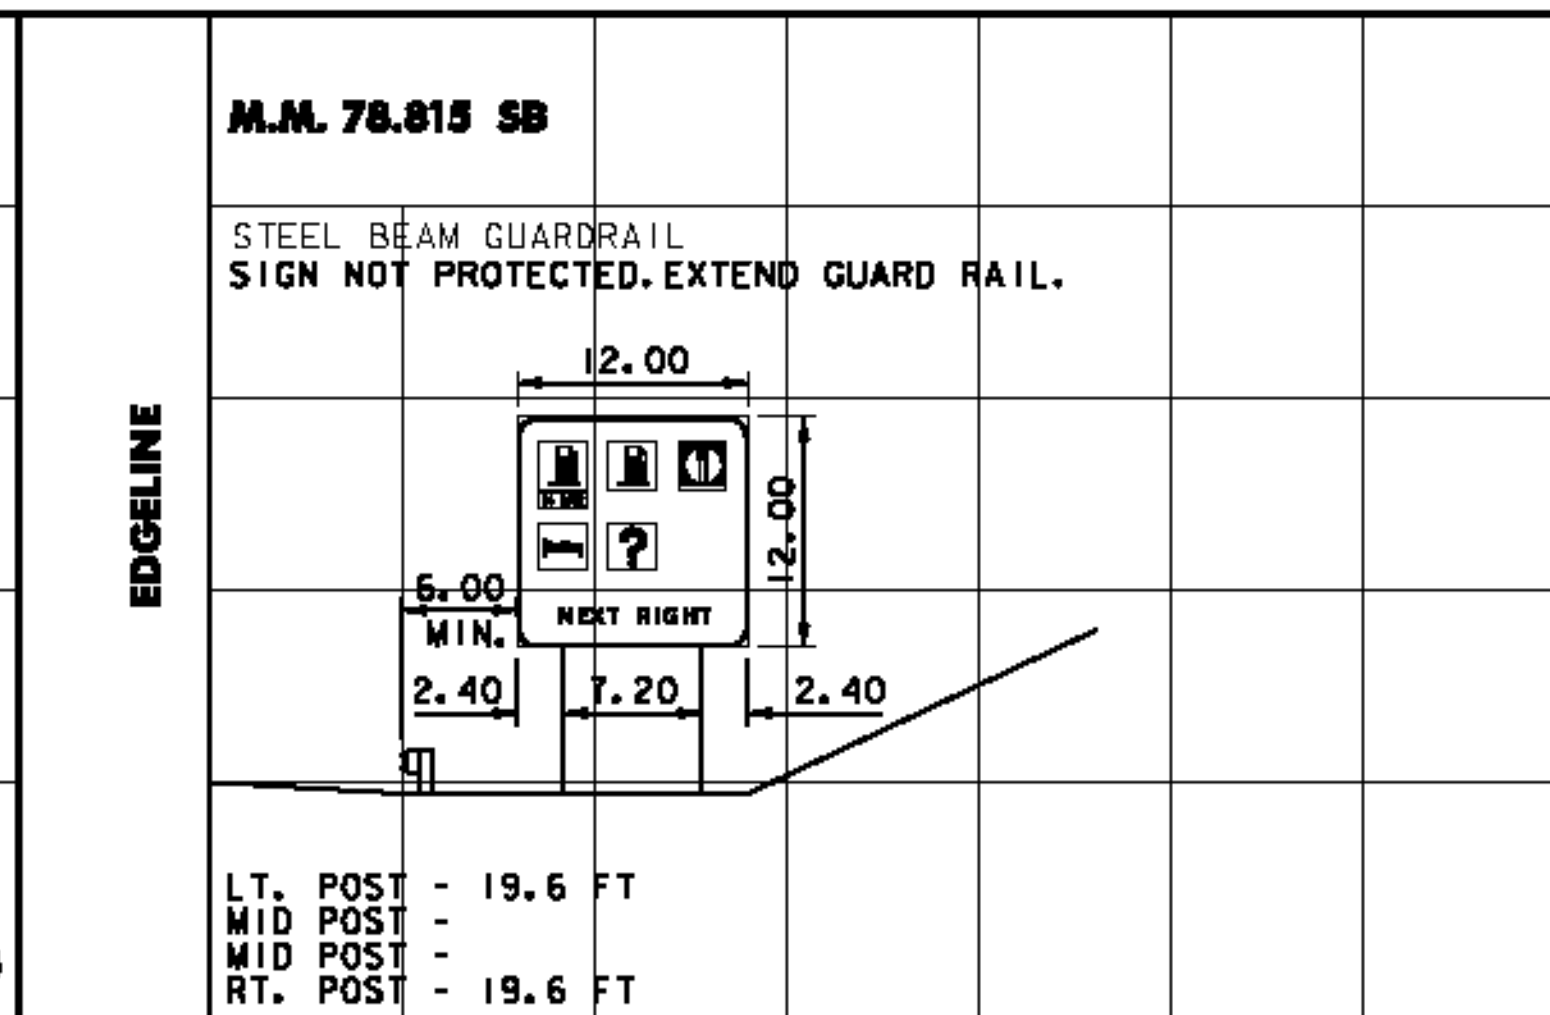
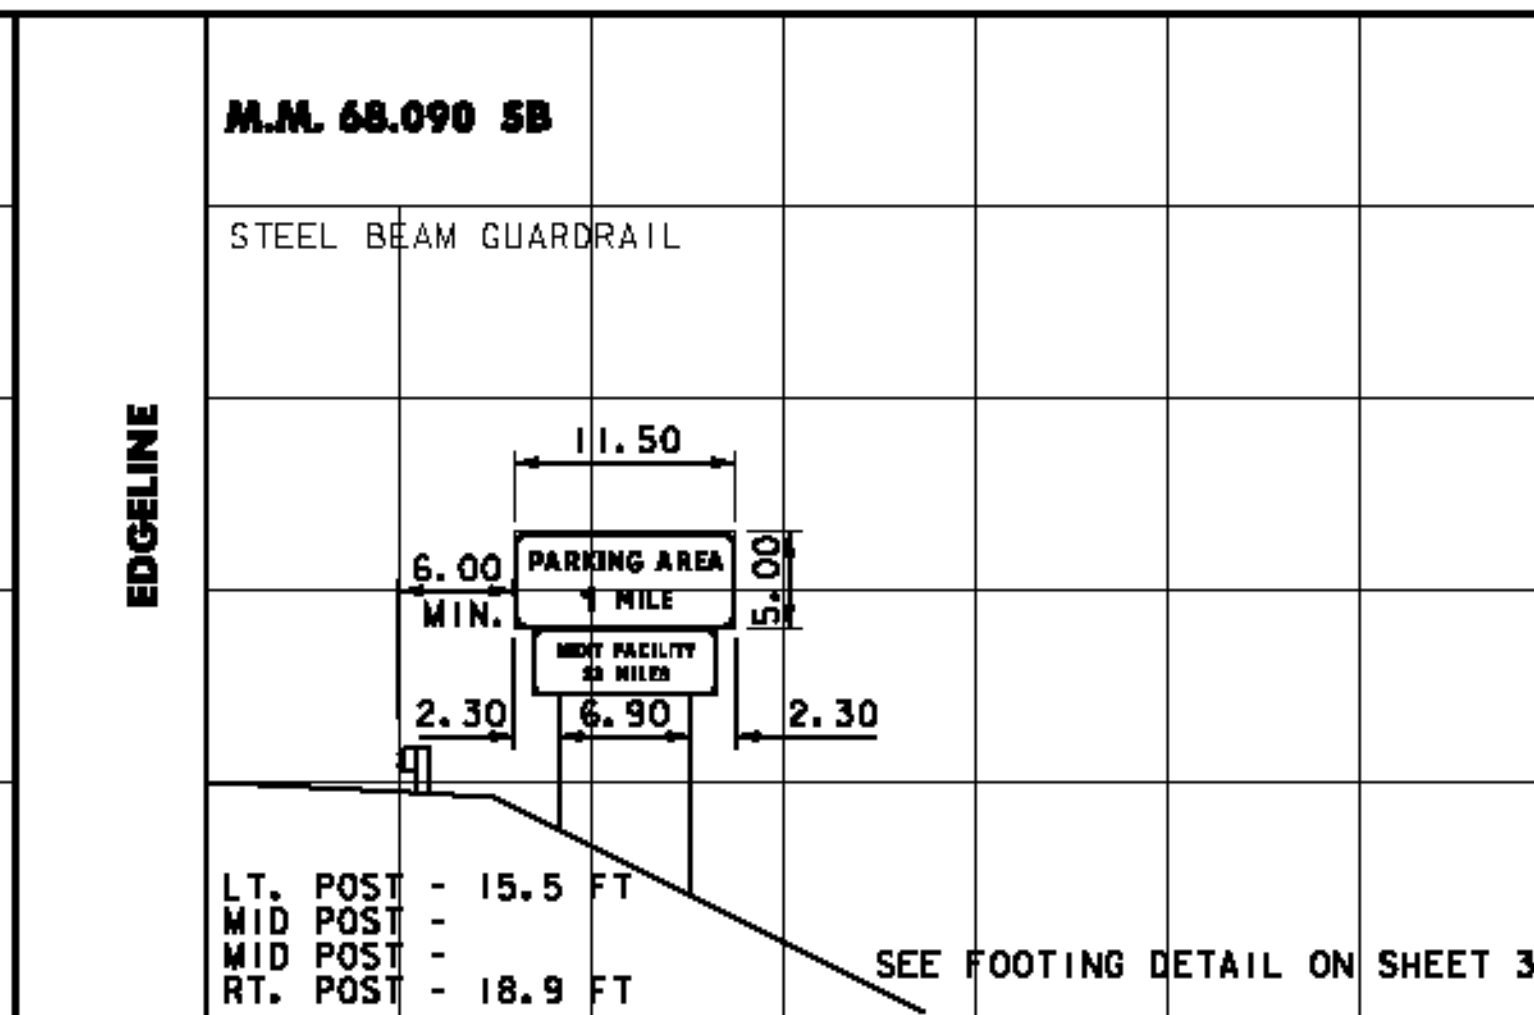
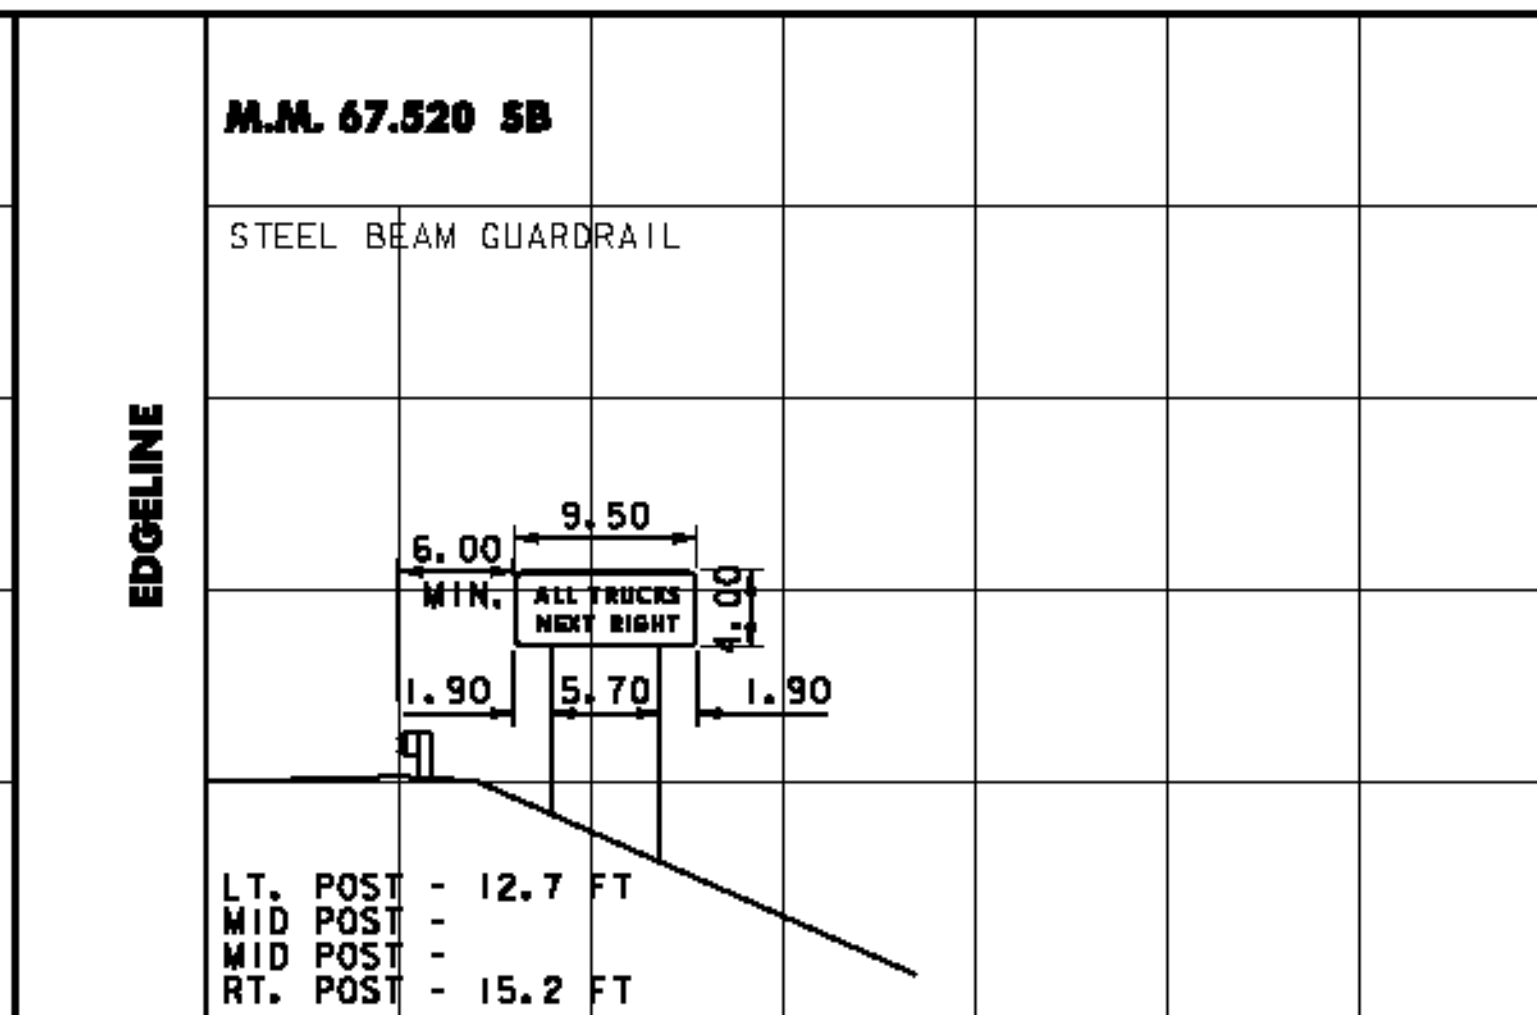


MODEL: 04

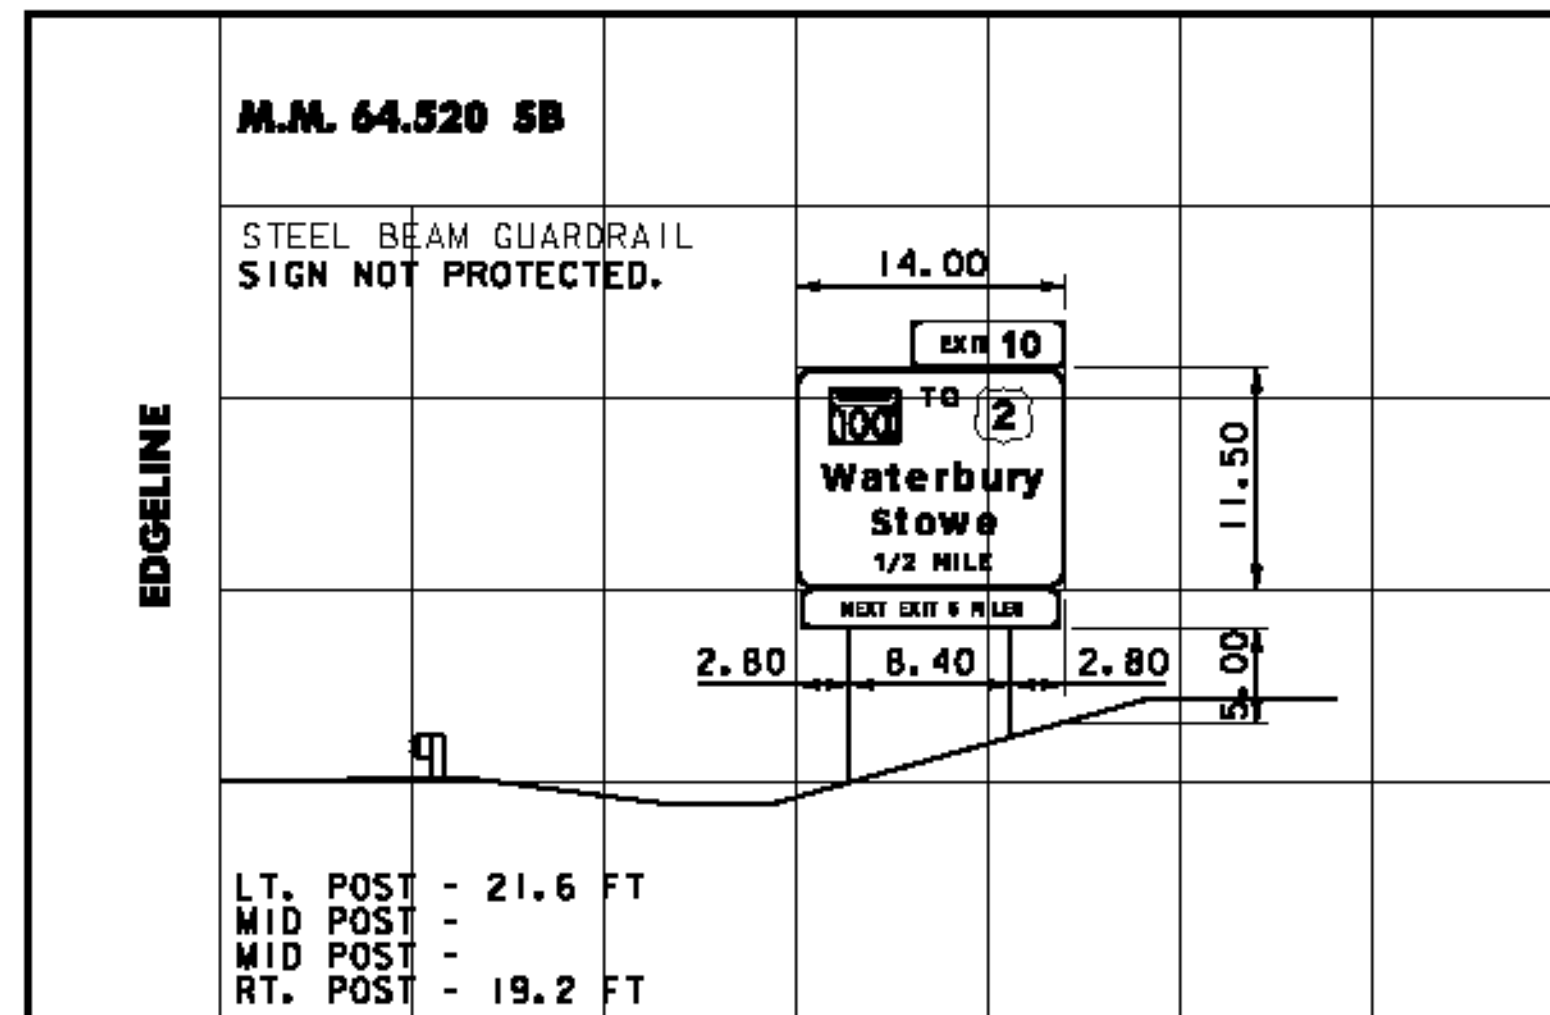

DIMENSIONS FOR CRITICAL OFFSETS OR CLEARANCES SHOWN FOR CONVENIENCE, REFER TO STANDARD SHEET E-120 FOR PLACEMENT GUIDELINES.

SCALE 1" = 10'

CROSS SECTION SHEET 4

PROJECT NAME: WATERBURY - WINOOSKI
PROJECT NUMBER: IMG SIGN(18)
FILE NAME: z09a018xs.dgn
PROJECT LEADER: CRB
DESIGNED BY: JBZ
CLD REF. NO.: 09-0124

PLOT DATE: 10/27/2009
DRAWN BY: JBZ
CHECKED BY: BDB
SHEET 157 OF 174