


DIMENSIONS FOR CRITICAL OFFSETS OR CLEARANCES SHOWN FOR CONVENIENCE, REFER TO STANDARD SHEET E-120 FOR PLACEMENT GUIDELINES.

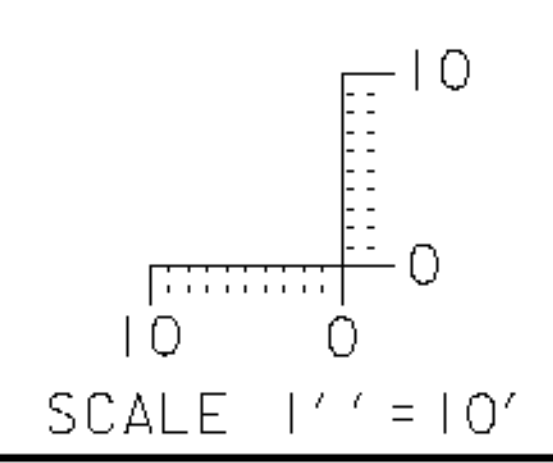

**CROSS SECTION SHEET 5**

PROJECT NAME: WATERBURY - WINOOSKI	PLOT DATE: 10/27/2009
PROJECT NUMBER: IMG SIGN(18)	DRAWN BY: JBZ
FILE NAME: z09a018xs.dgn	CHECKED BY: BDB
DESIGNED BY: JBZ	SHEET 158 OF 174
CLD REF. NO.: 09-0124	