
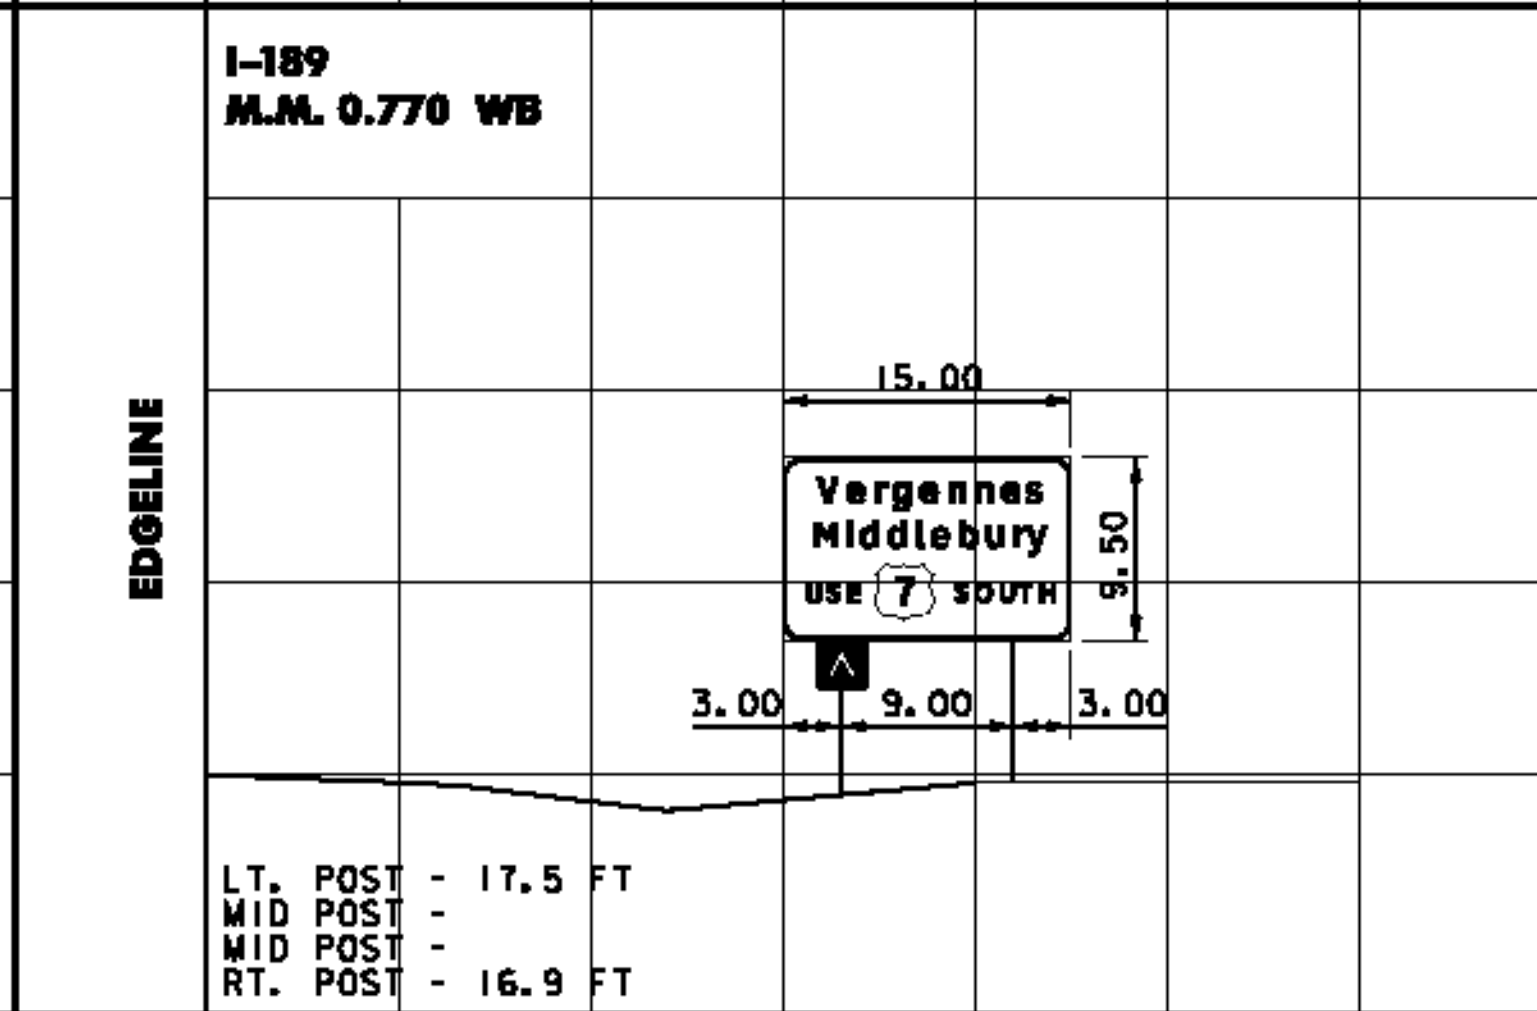
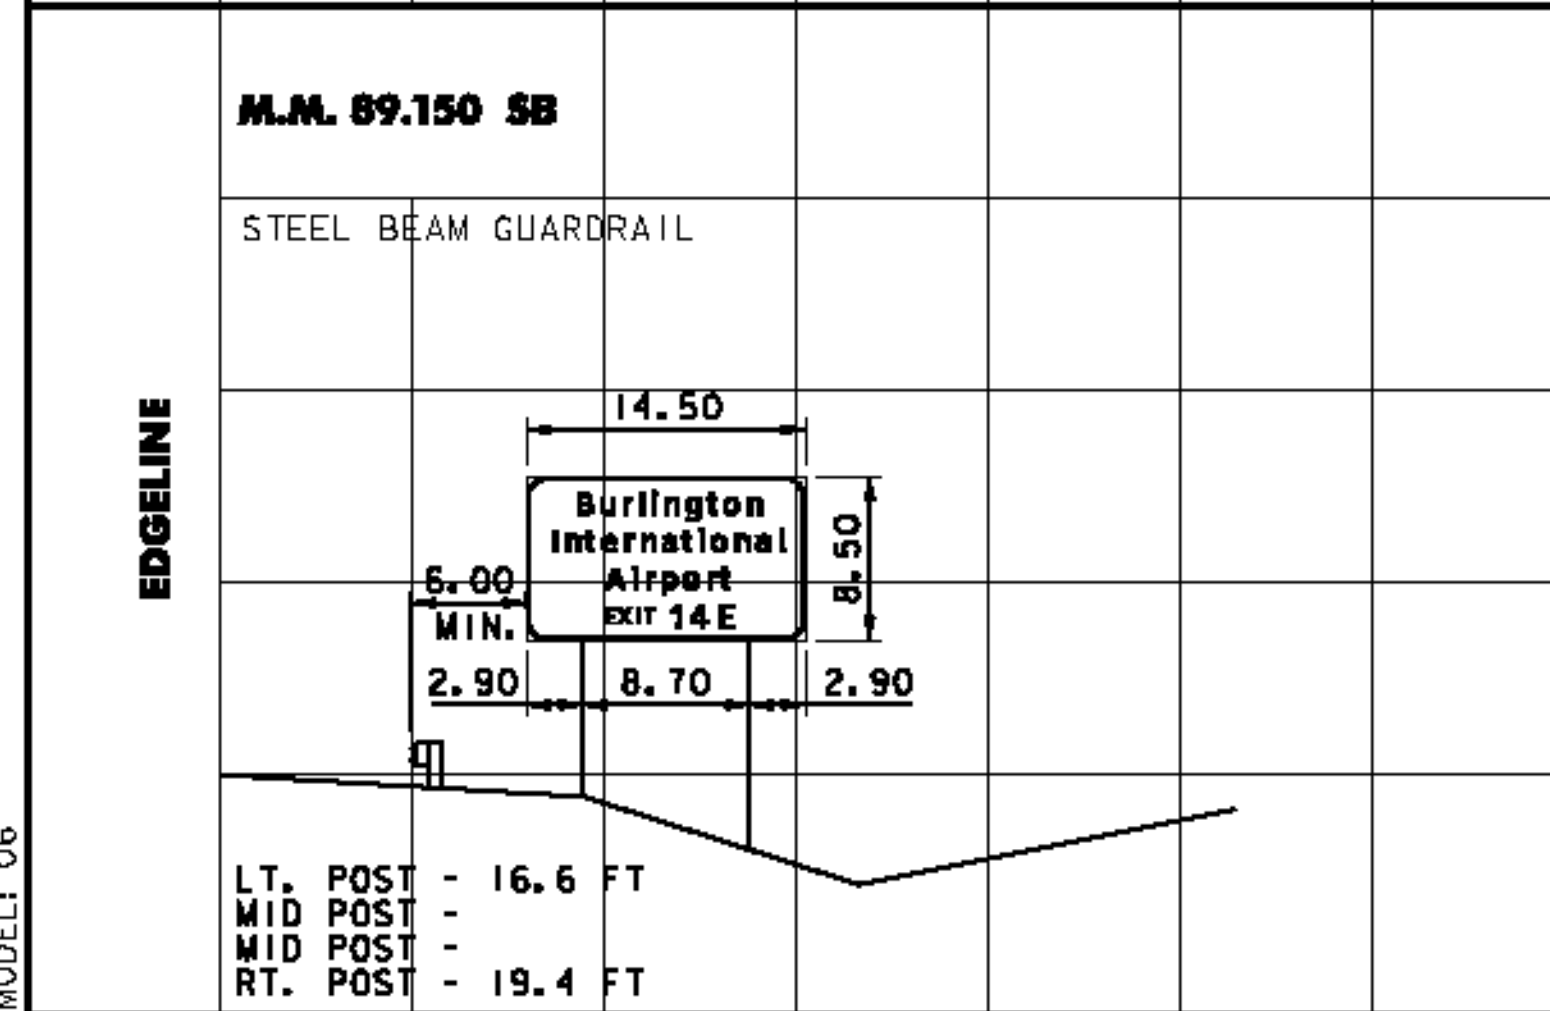
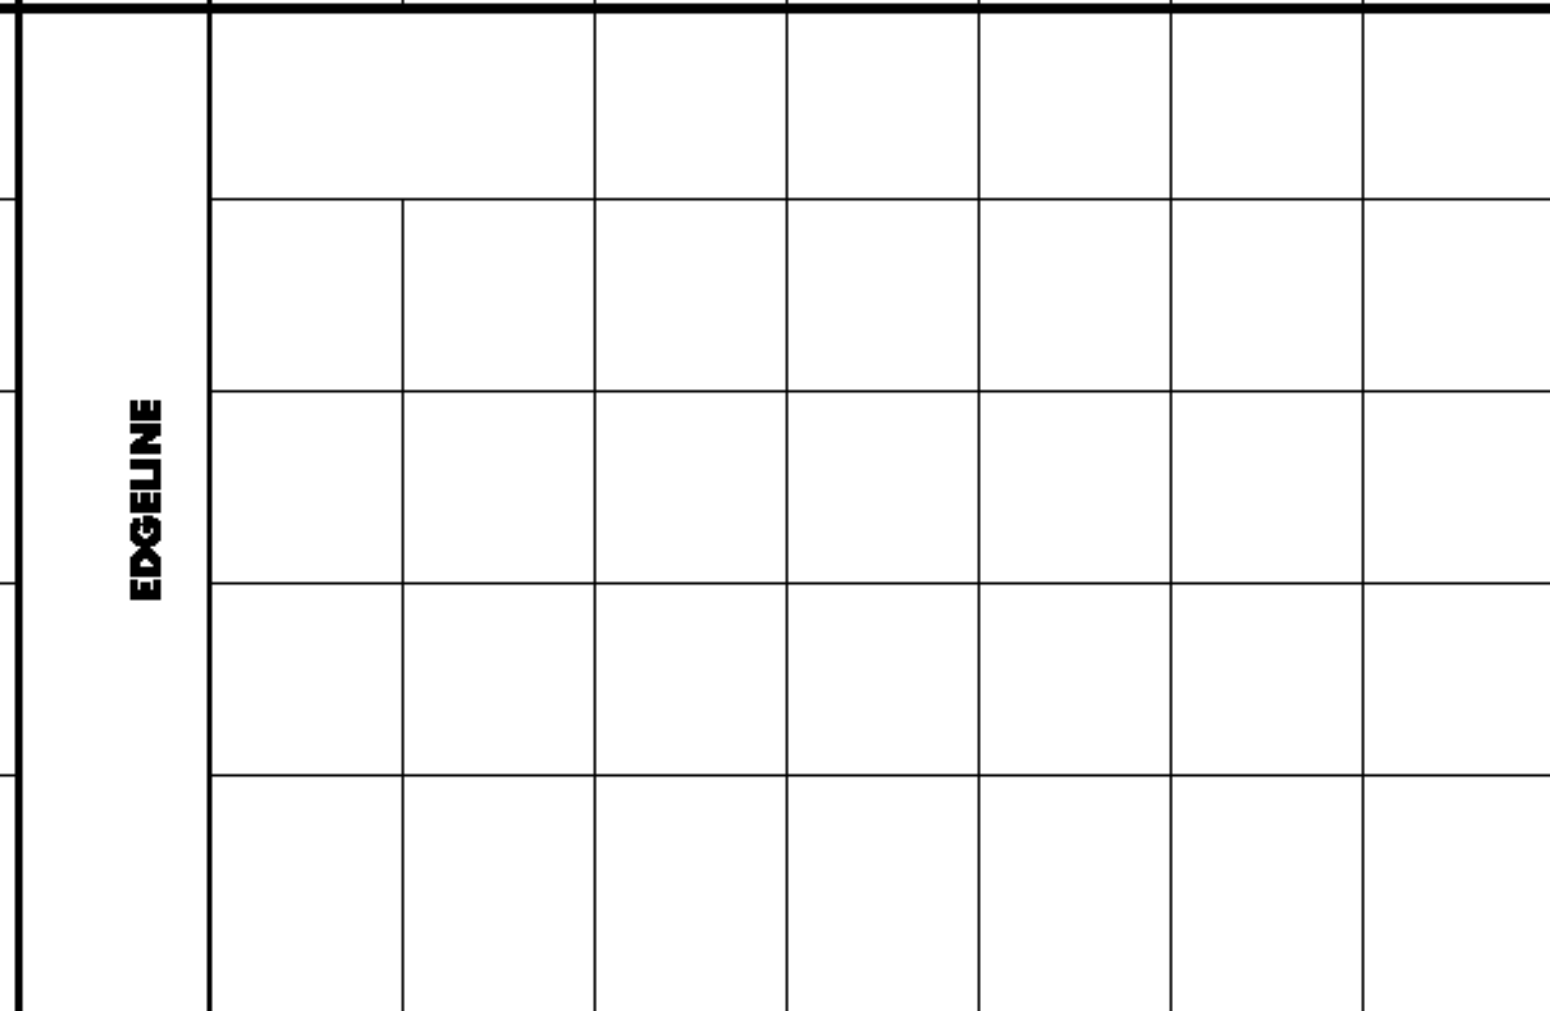
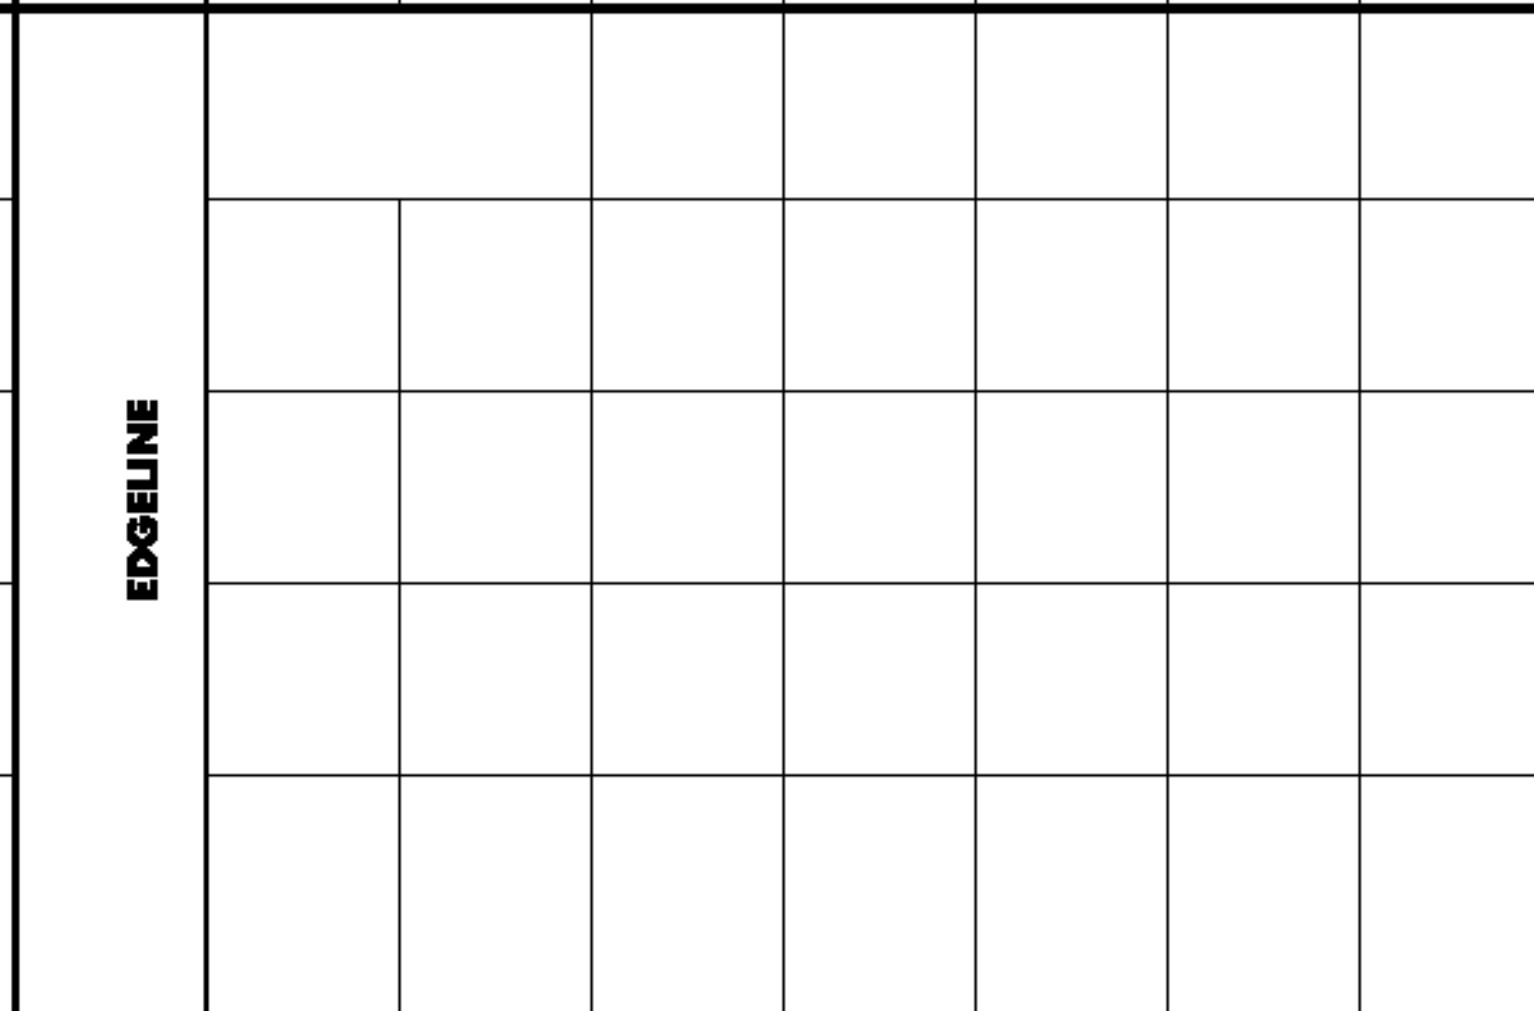
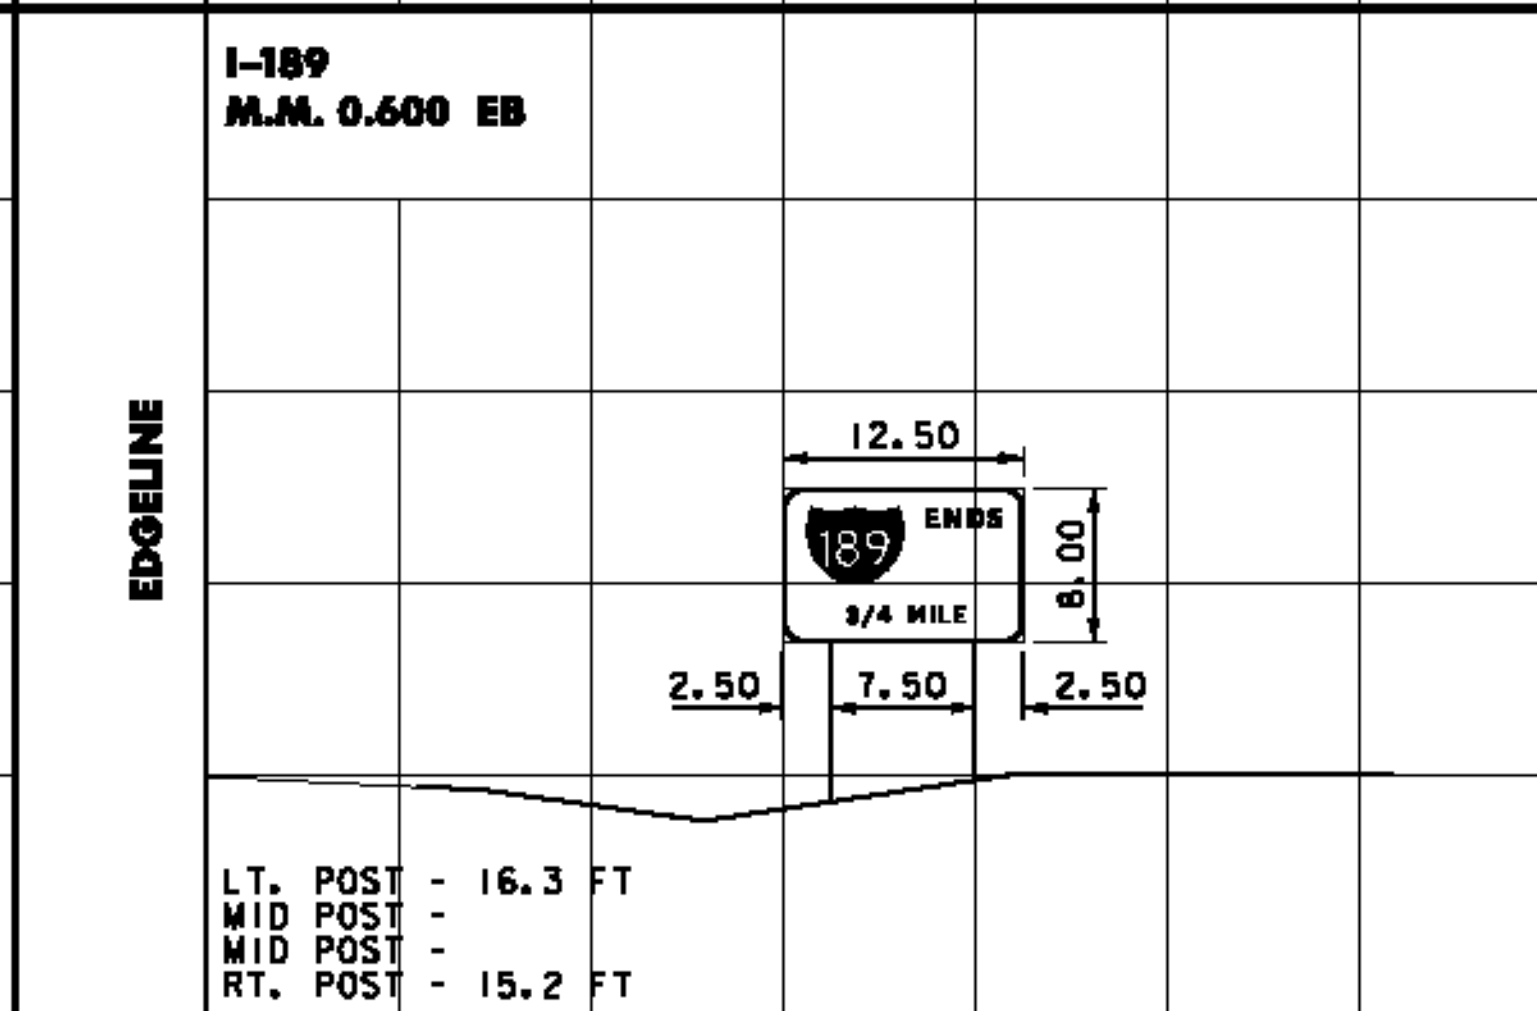
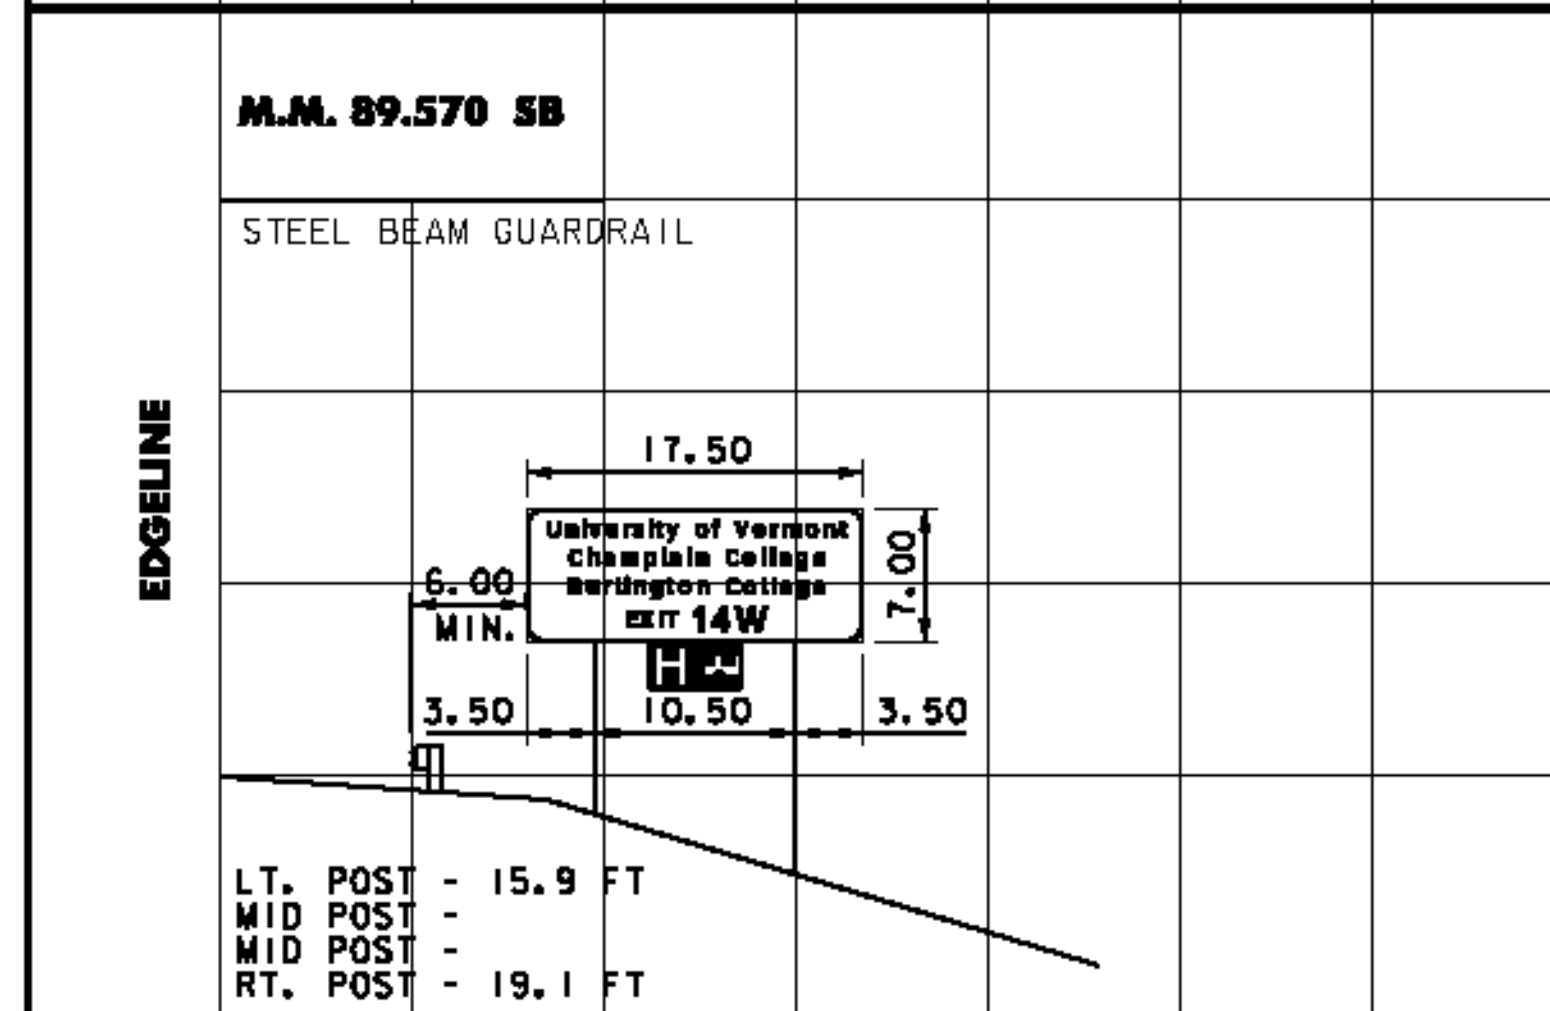
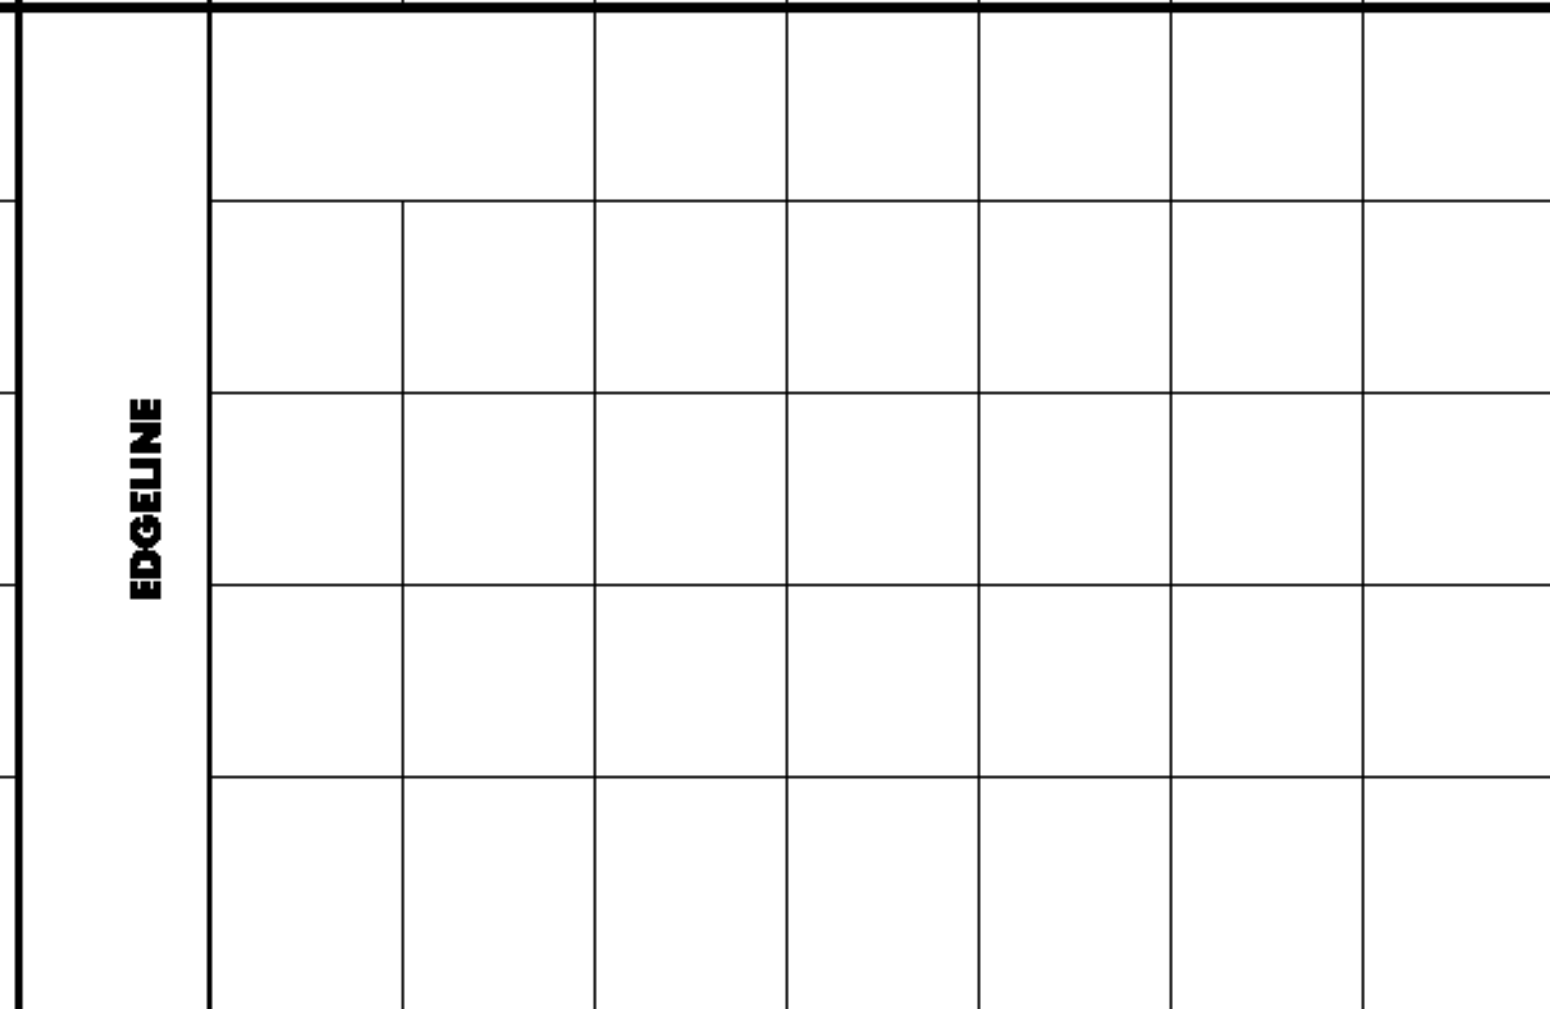
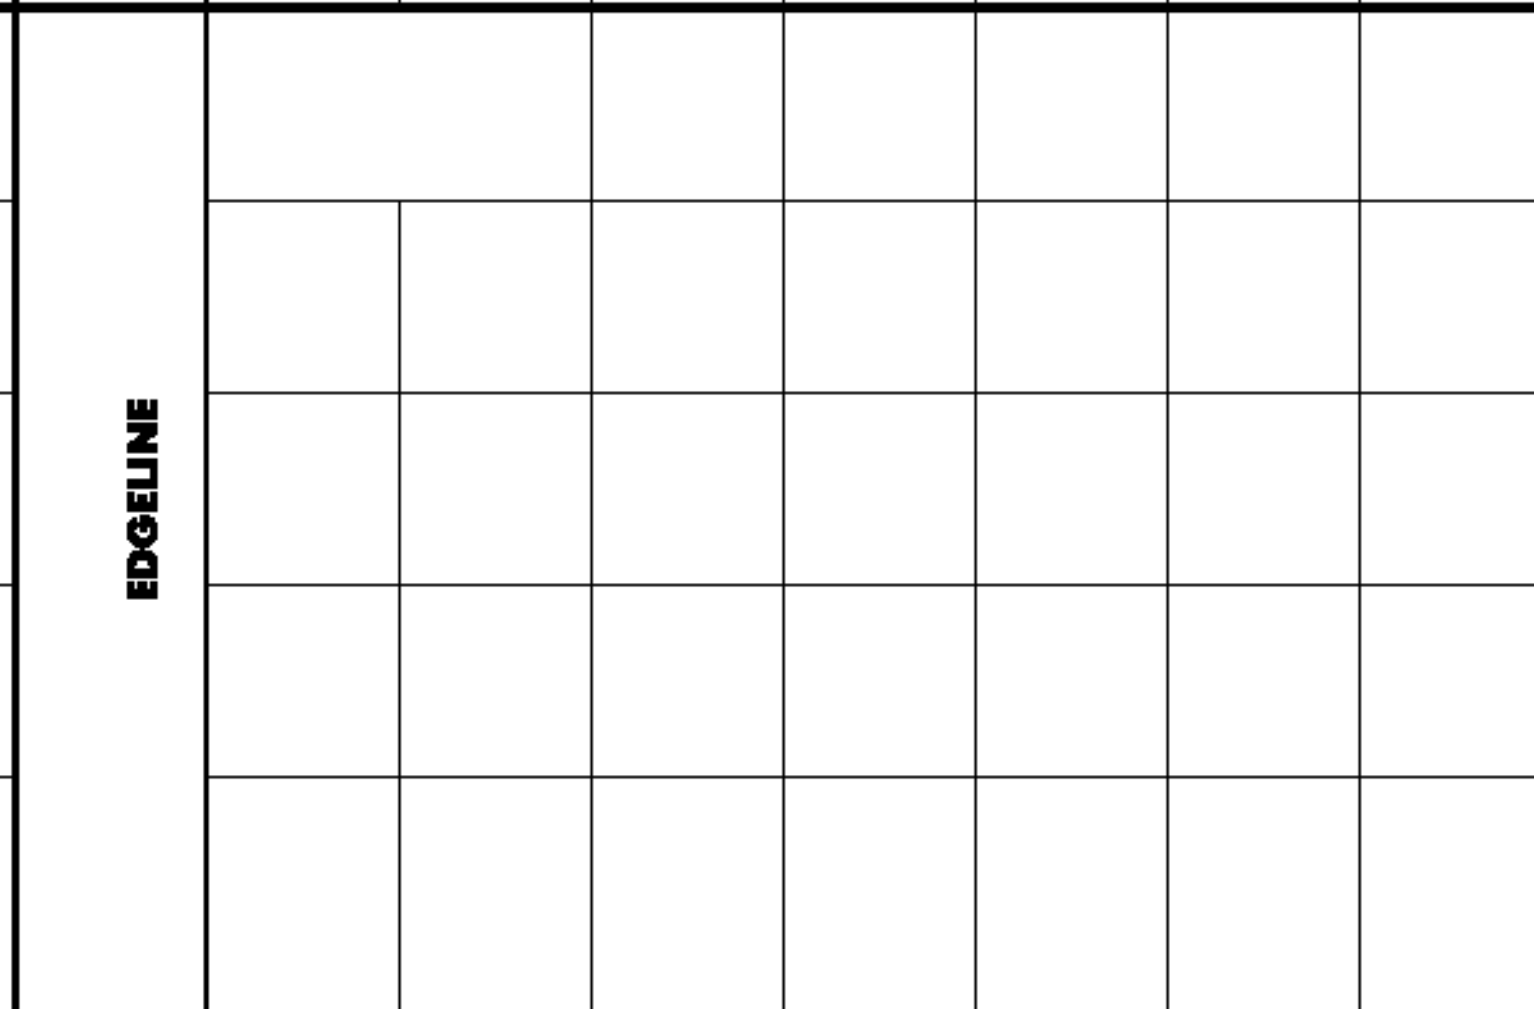
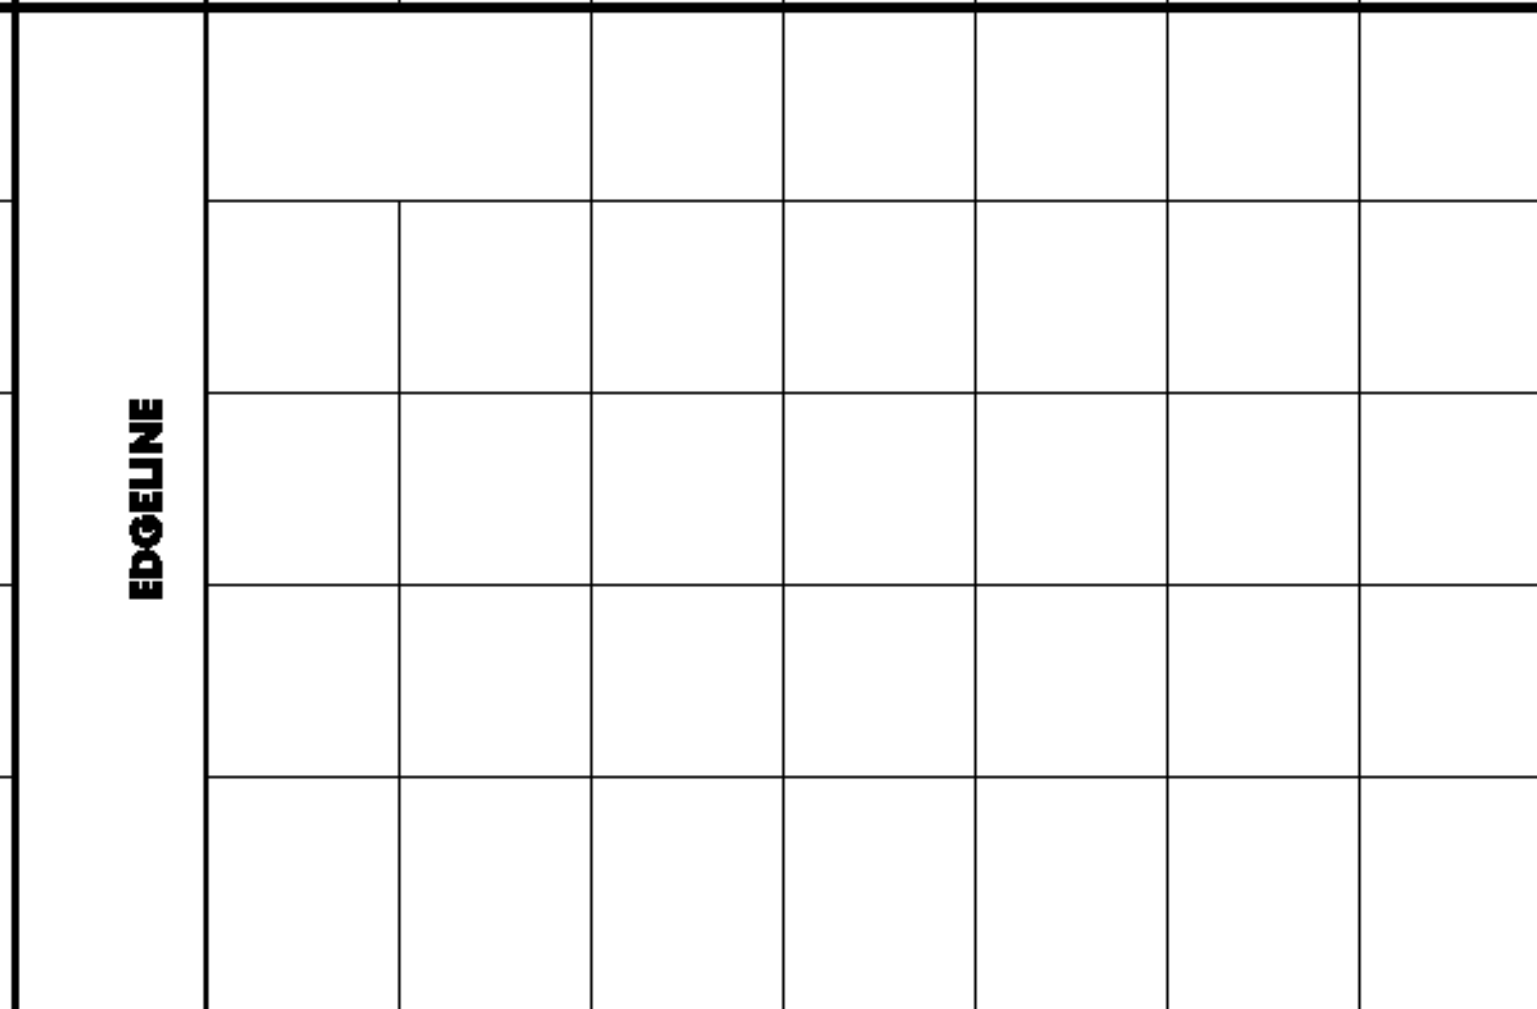
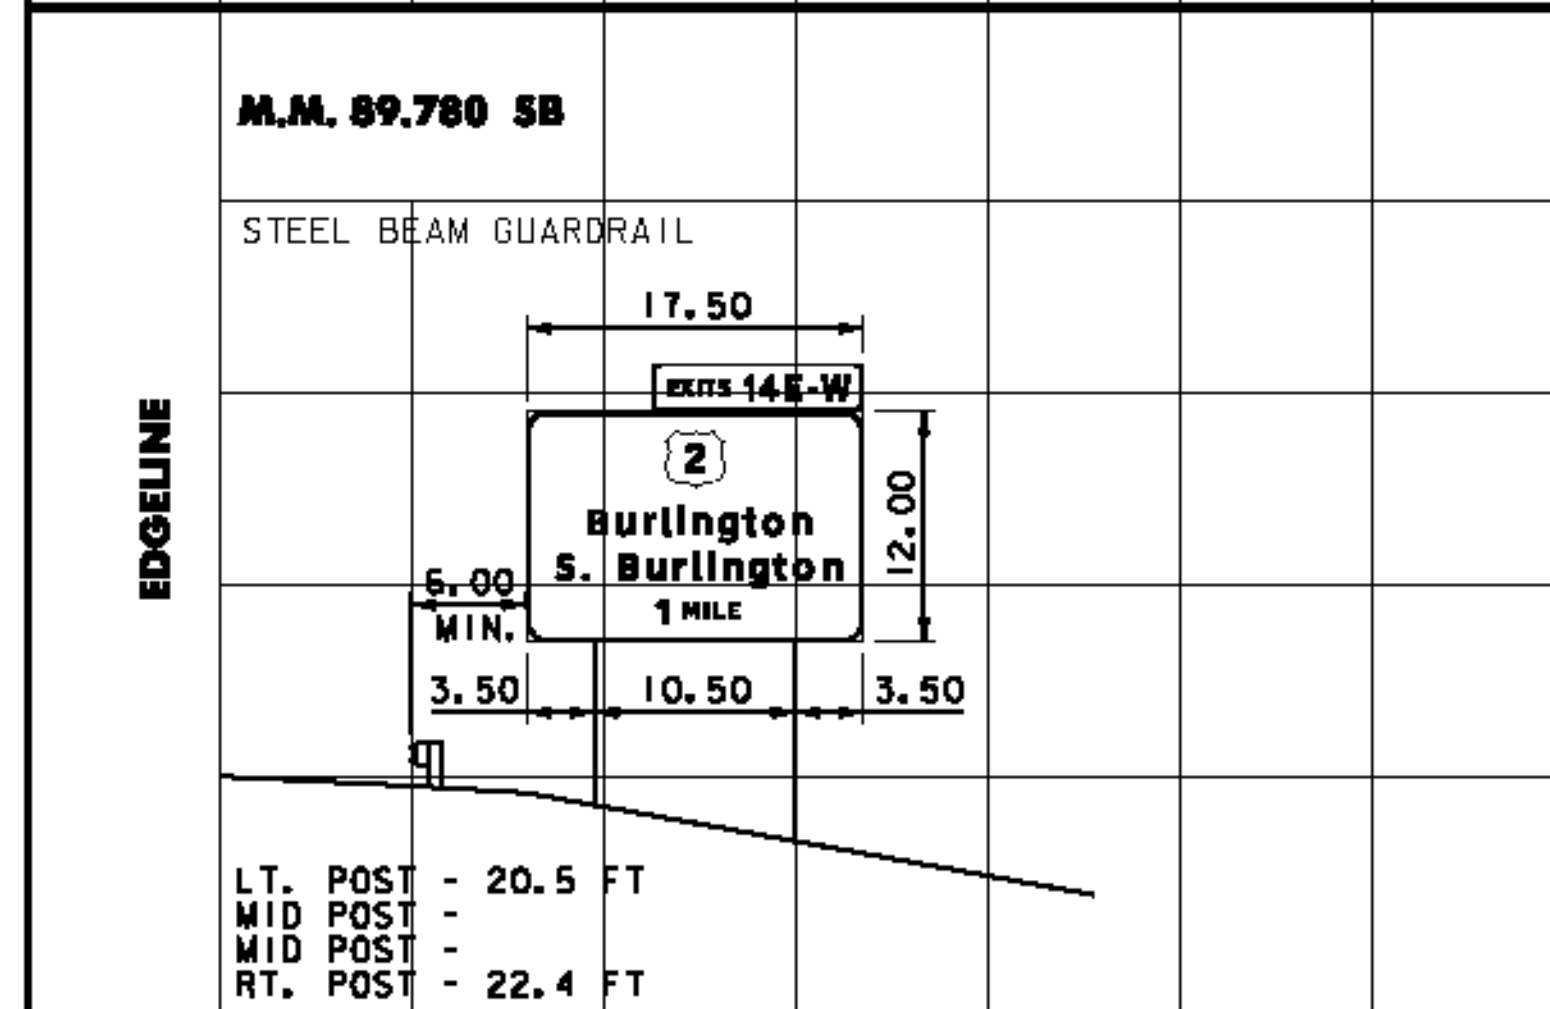
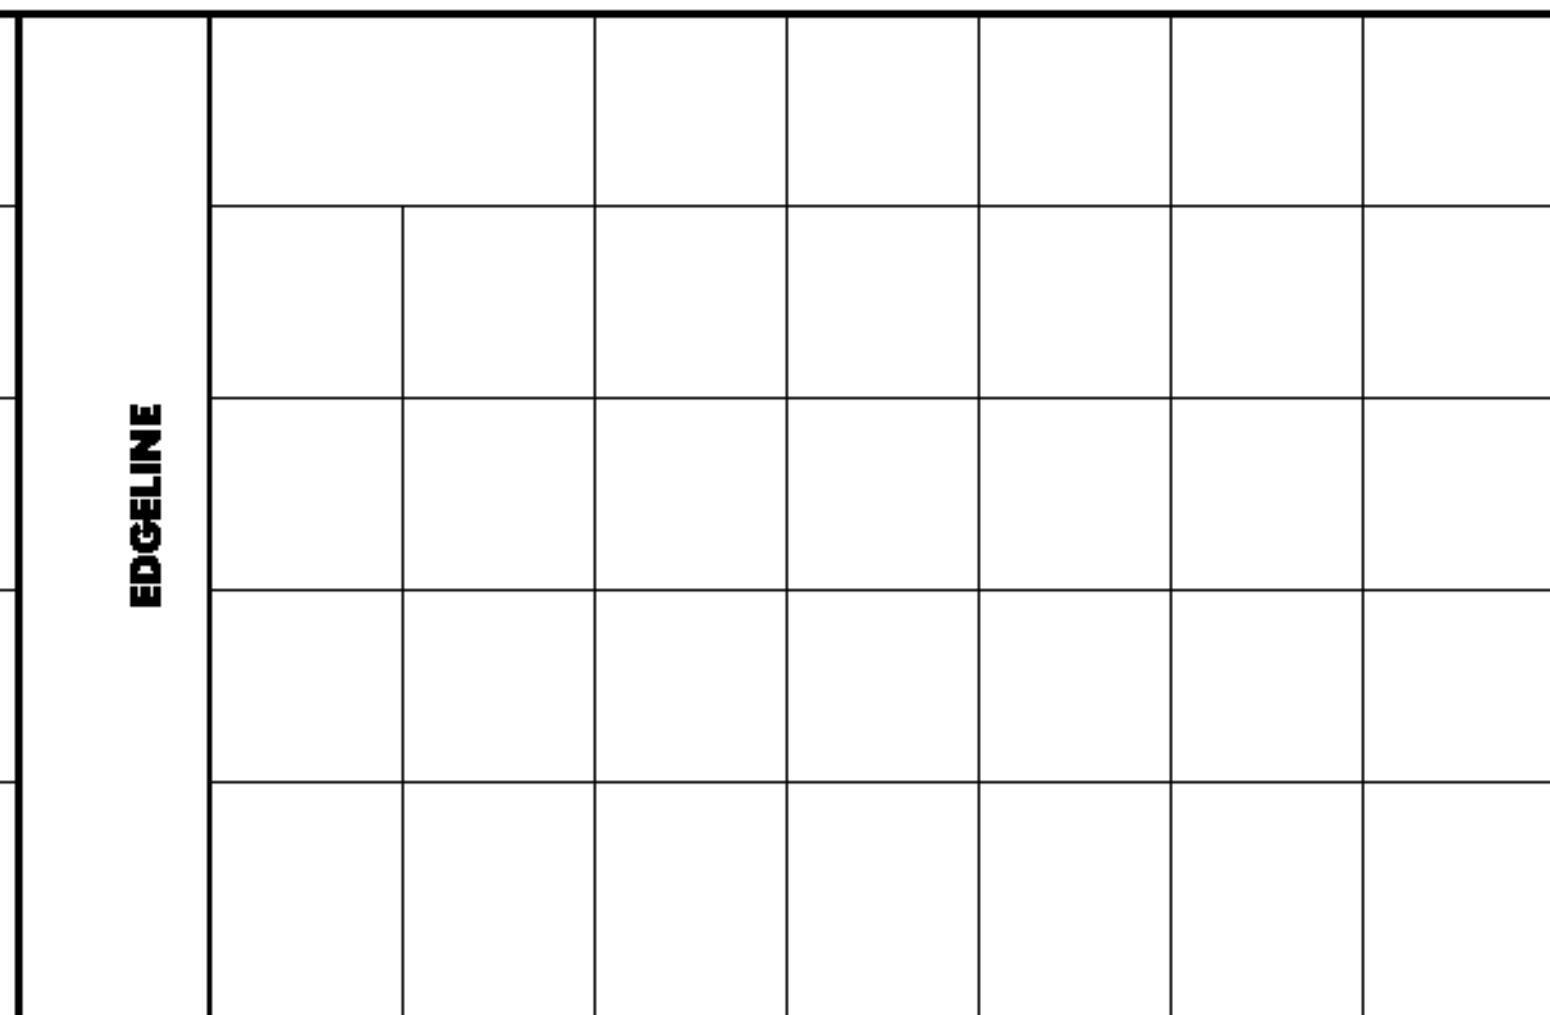
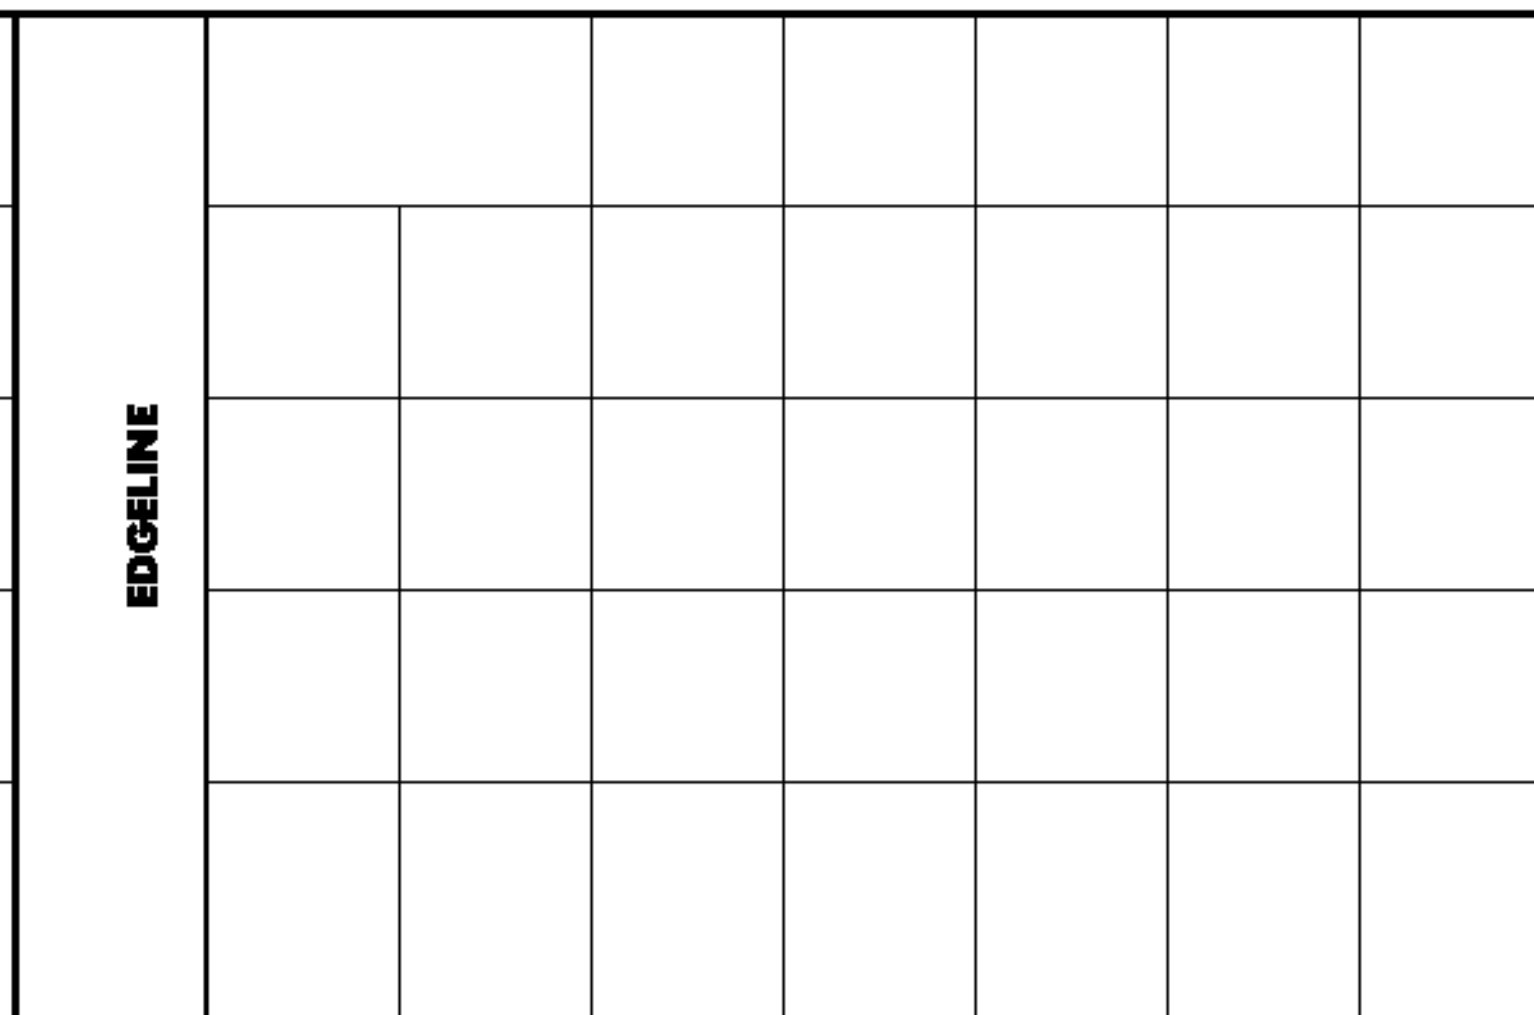
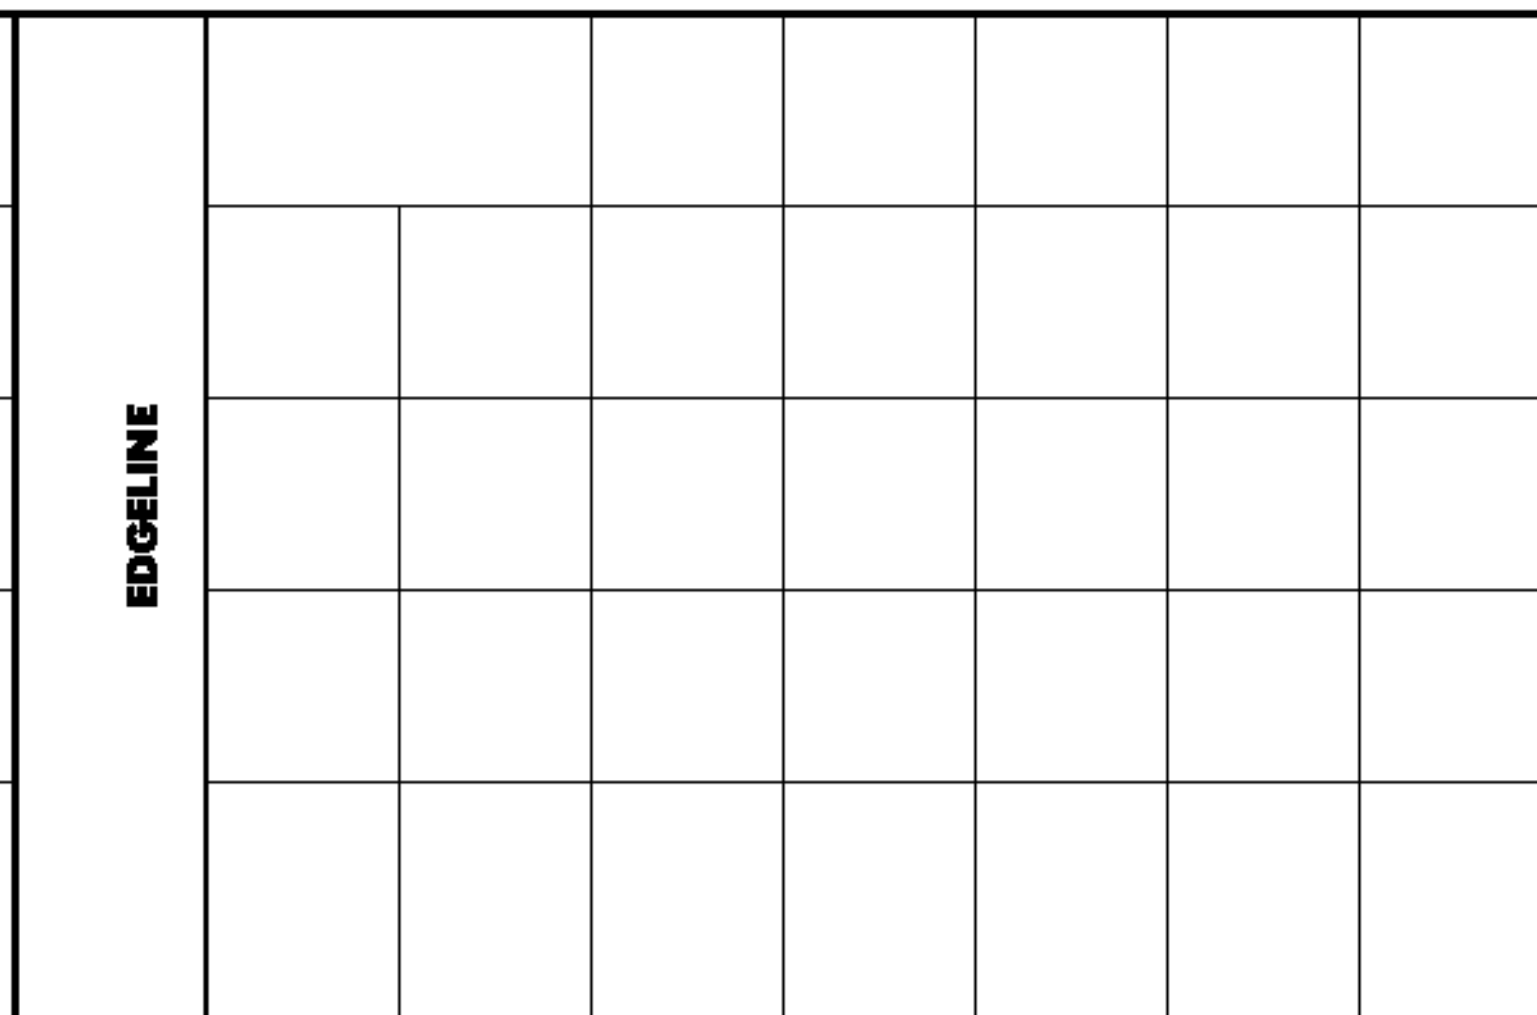


MODEL: 06

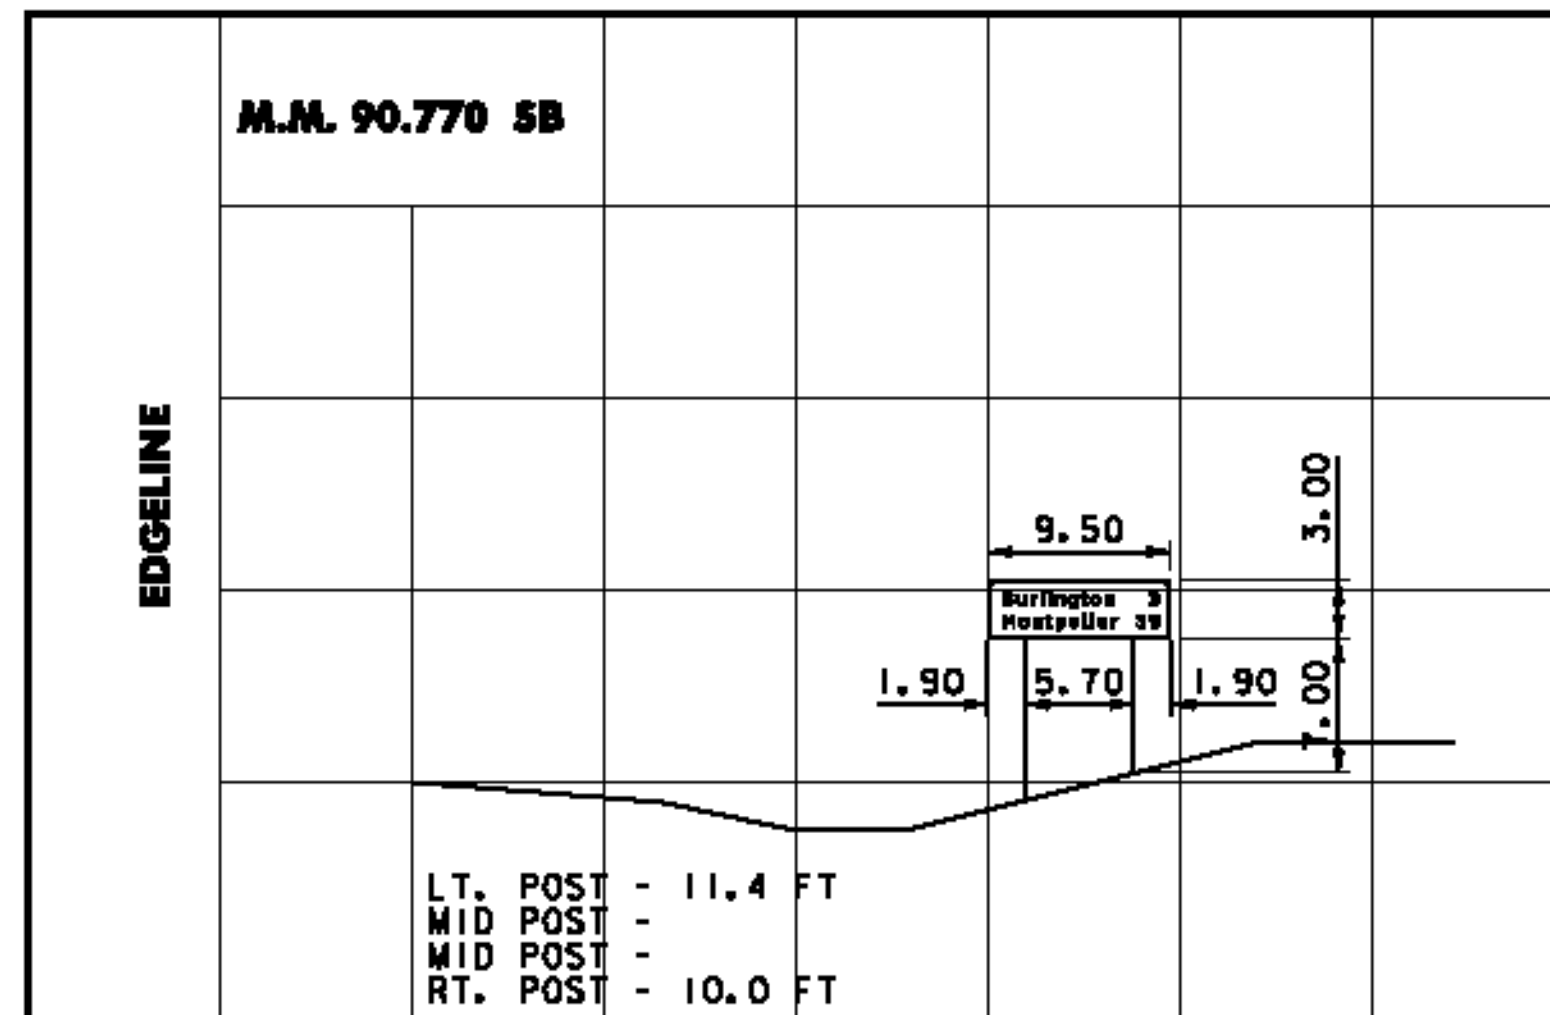

DIMENSIONS FOR CRITICAL OFFSETS OR CLEARANCES SHOWN FOR CONVENIENCE, REFER TO STANDARD SHEET E-120 FOR PLACEMENT GUIDELINES.

**CROSS SECTION
SHEET 6**

PROJECT NAME: WATERBURY - WINOOSKI
PROJECT NUMBER: IMG SIGN(18)
FILE NAME: z09a018xs.dgn
PROJECT LEADER: CRB
DESIGNED BY: JBZ
CLD REF. NO.: 09-0124

PLOT DATE: 10/27/2009
DRAWN BY: JBZ
CHECKED BY: BDB
SHEET 159 OF 174