


**BEGIN APPROACH
IMG SIGN(19)
(MM 21.000)**


**BEGIN PROJECT
IMG SIGN(19)
(MM 22.000)**

REMOVING SIGNS

NB- TYPE A: 12
TYPE B: 5
BRIDGE PLAQUE: 7
SB- TYPE A: 12
TYPE B: 5
BRIDGE PLAQUE: 5

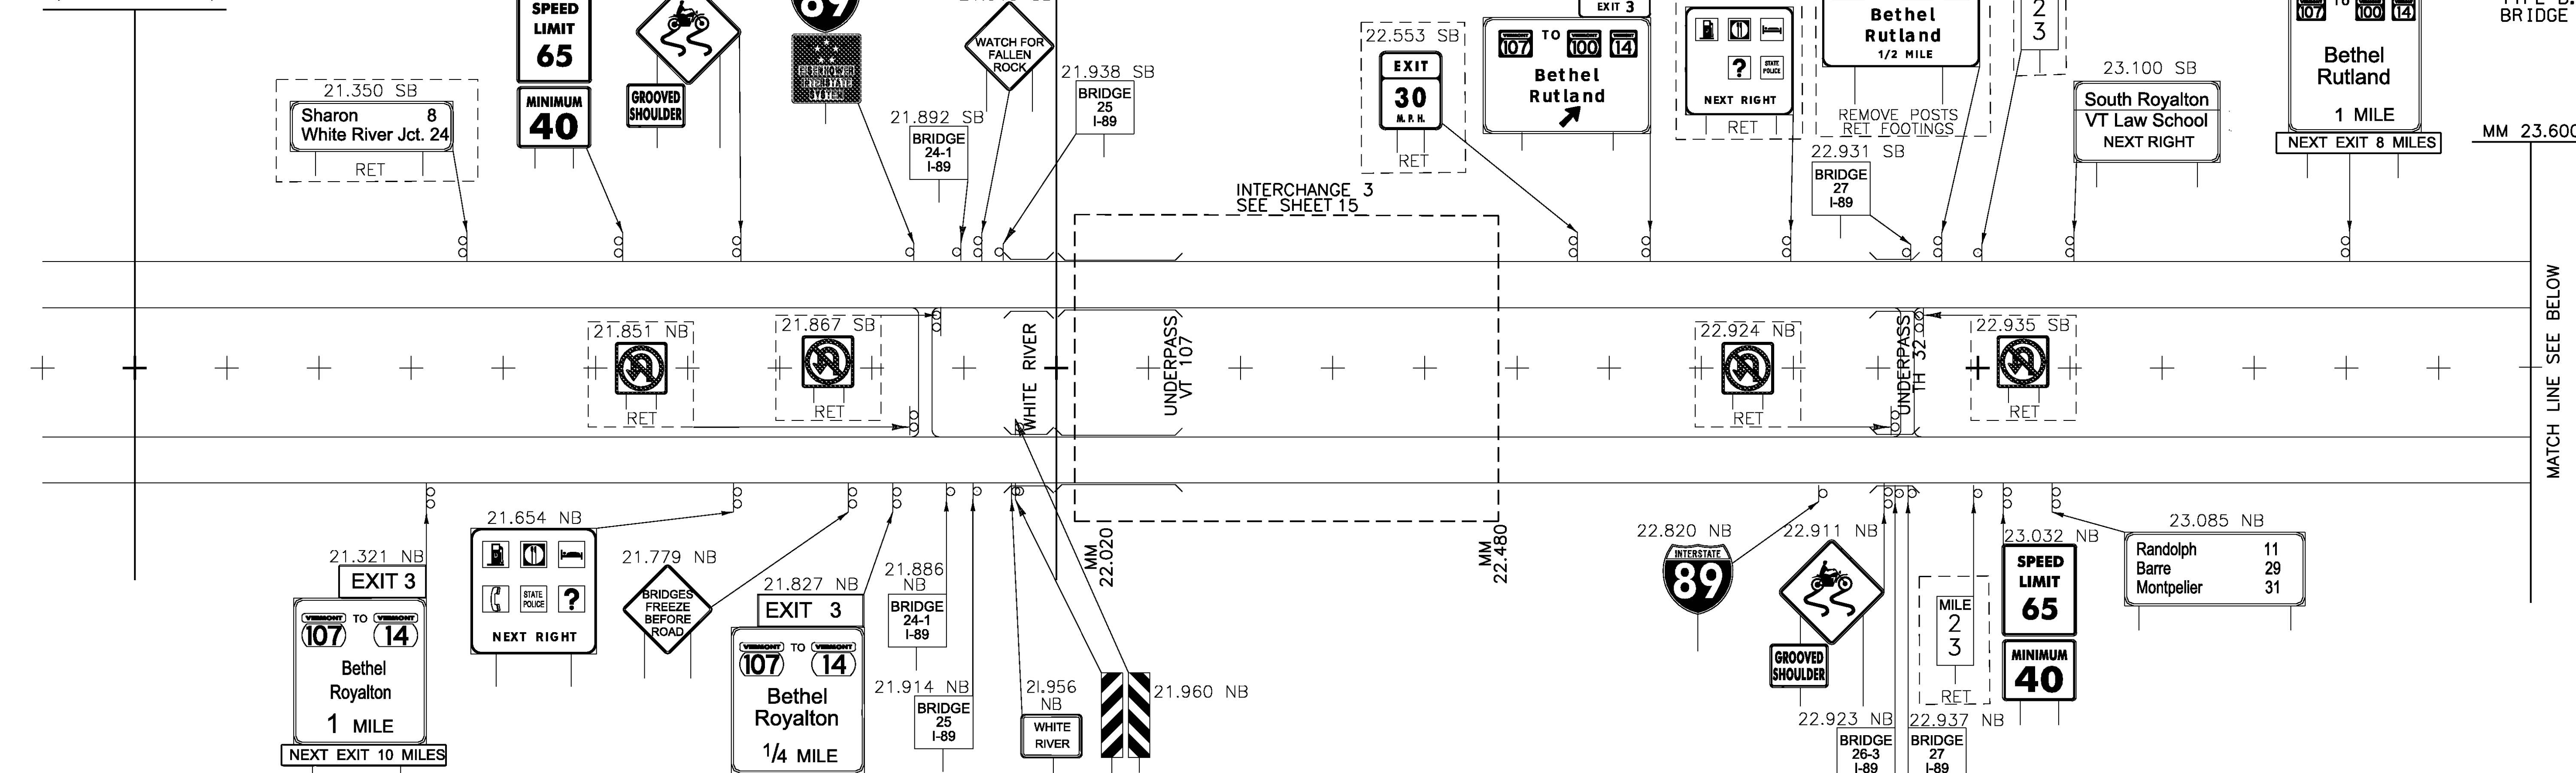

MATCH LINE SEE BELOW

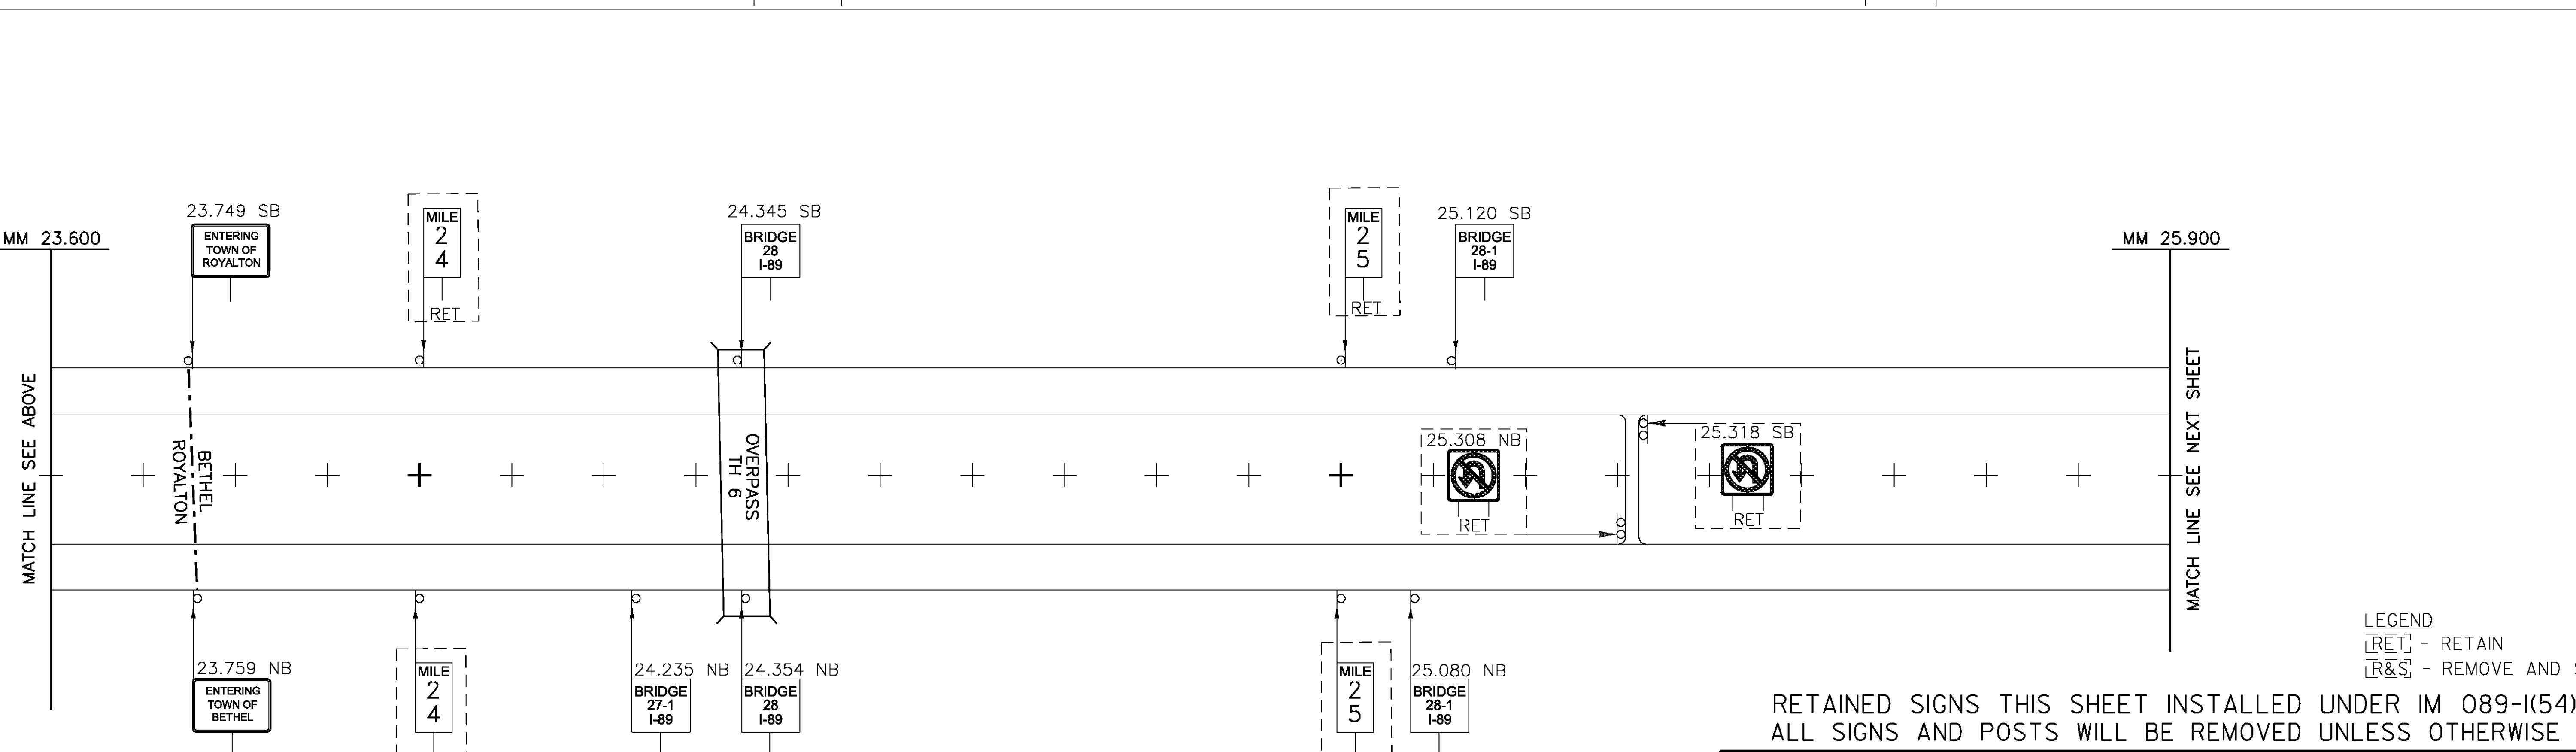

MATCH LINE SEE NEXT SHEET

LEGEND
[RET] - RETAIN
[R&S] - REMOVE AND SALVAGE

RETAINED SIGNS THIS SHEET INSTALLED UNDER IM 089-I(54)
ALL SIGNS AND POSTS WILL BE REMOVED UNLESS OTHERWISE NOTED

EXISTING SIGNS MAINLINE (1) 22.000 - 25.900	PROJECT NAME: ROYALTON-MIDDLESEX	
	PROJECT NUMBER: IMG SIGN(19)	
FILE NAME: z09a020mainline.dgn	PLOT DATE: 8/12/2009	
PROJECT LEADER: CRB	DRAWN BY: JBZ	
DESIGNED BY: BDB	CHECKED BY: DAM	
CLD REF. NO.: 09-0106	SHEET 7 OF 163	

MODEL: 01-Exist