
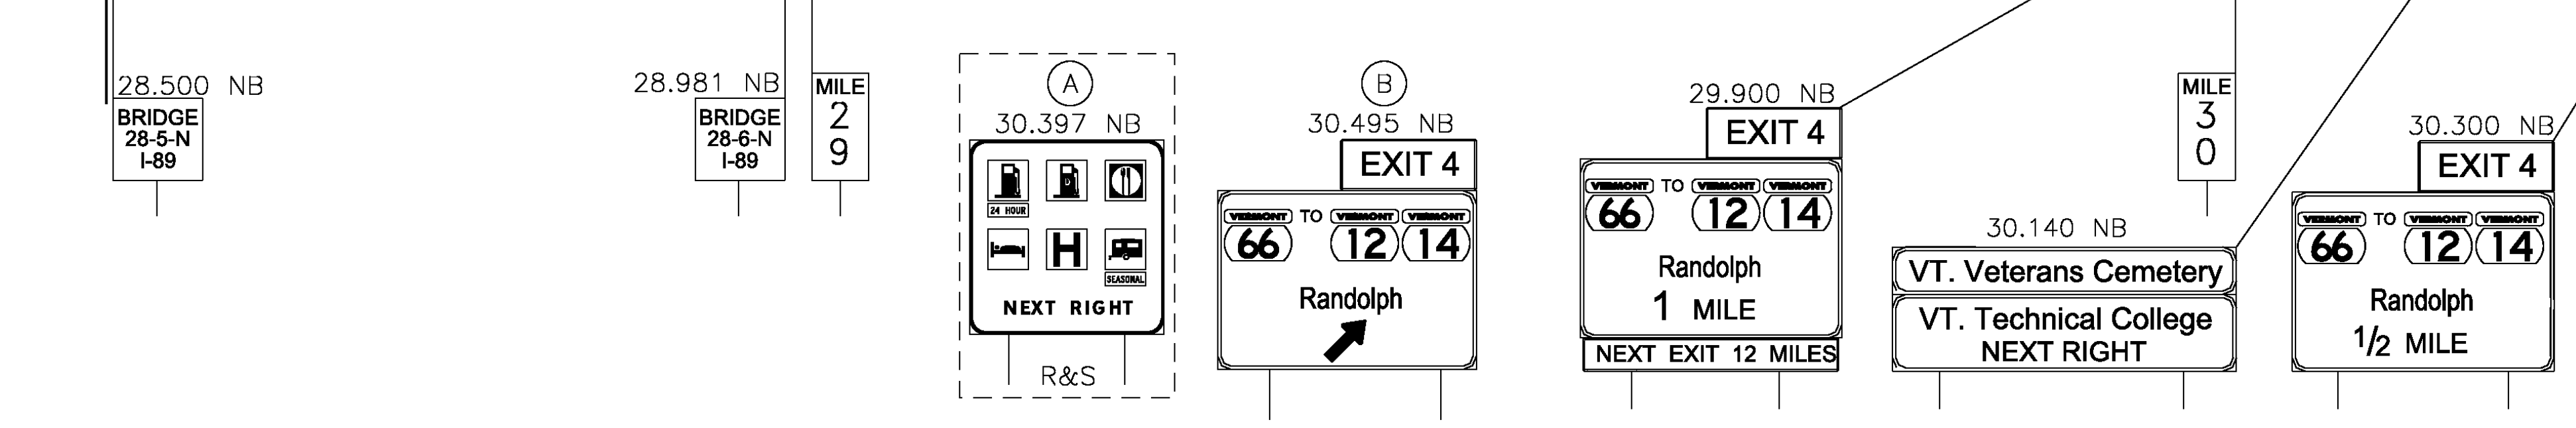
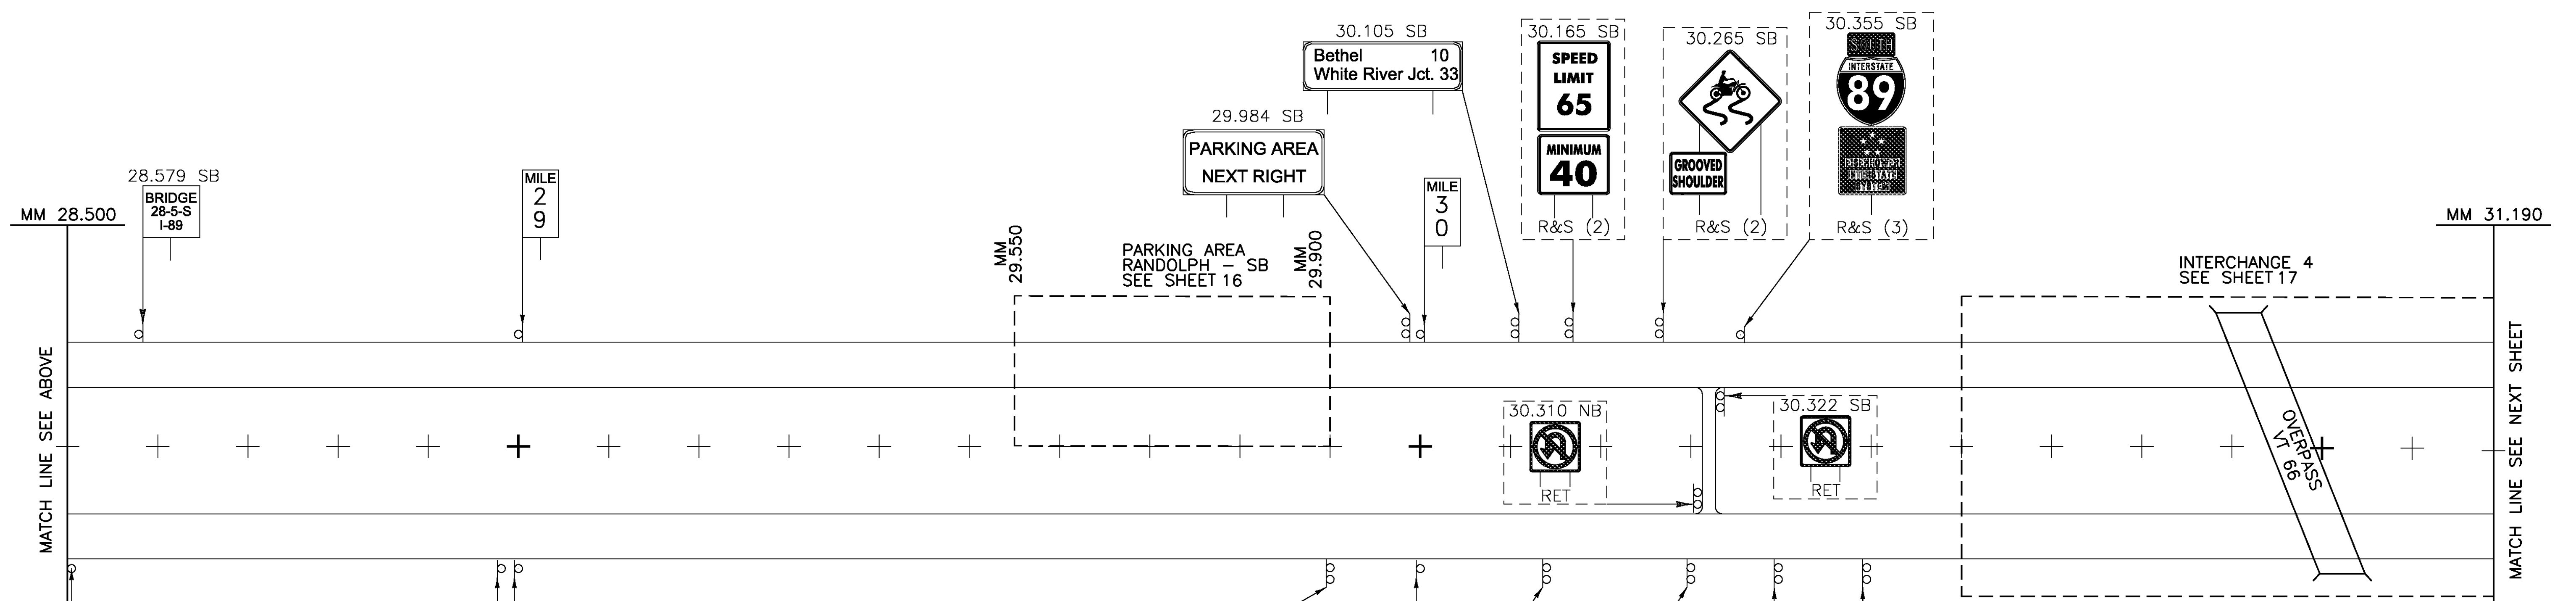


REMOVING SIGNS  
 NB- TYPE A: 9  
 TYPE B: 8  
 BRIDGE PLAQUE: 4  
 SB- TYPE A: 13  
 TYPE B: 2  
 BRIDGE PLAQUE: 1

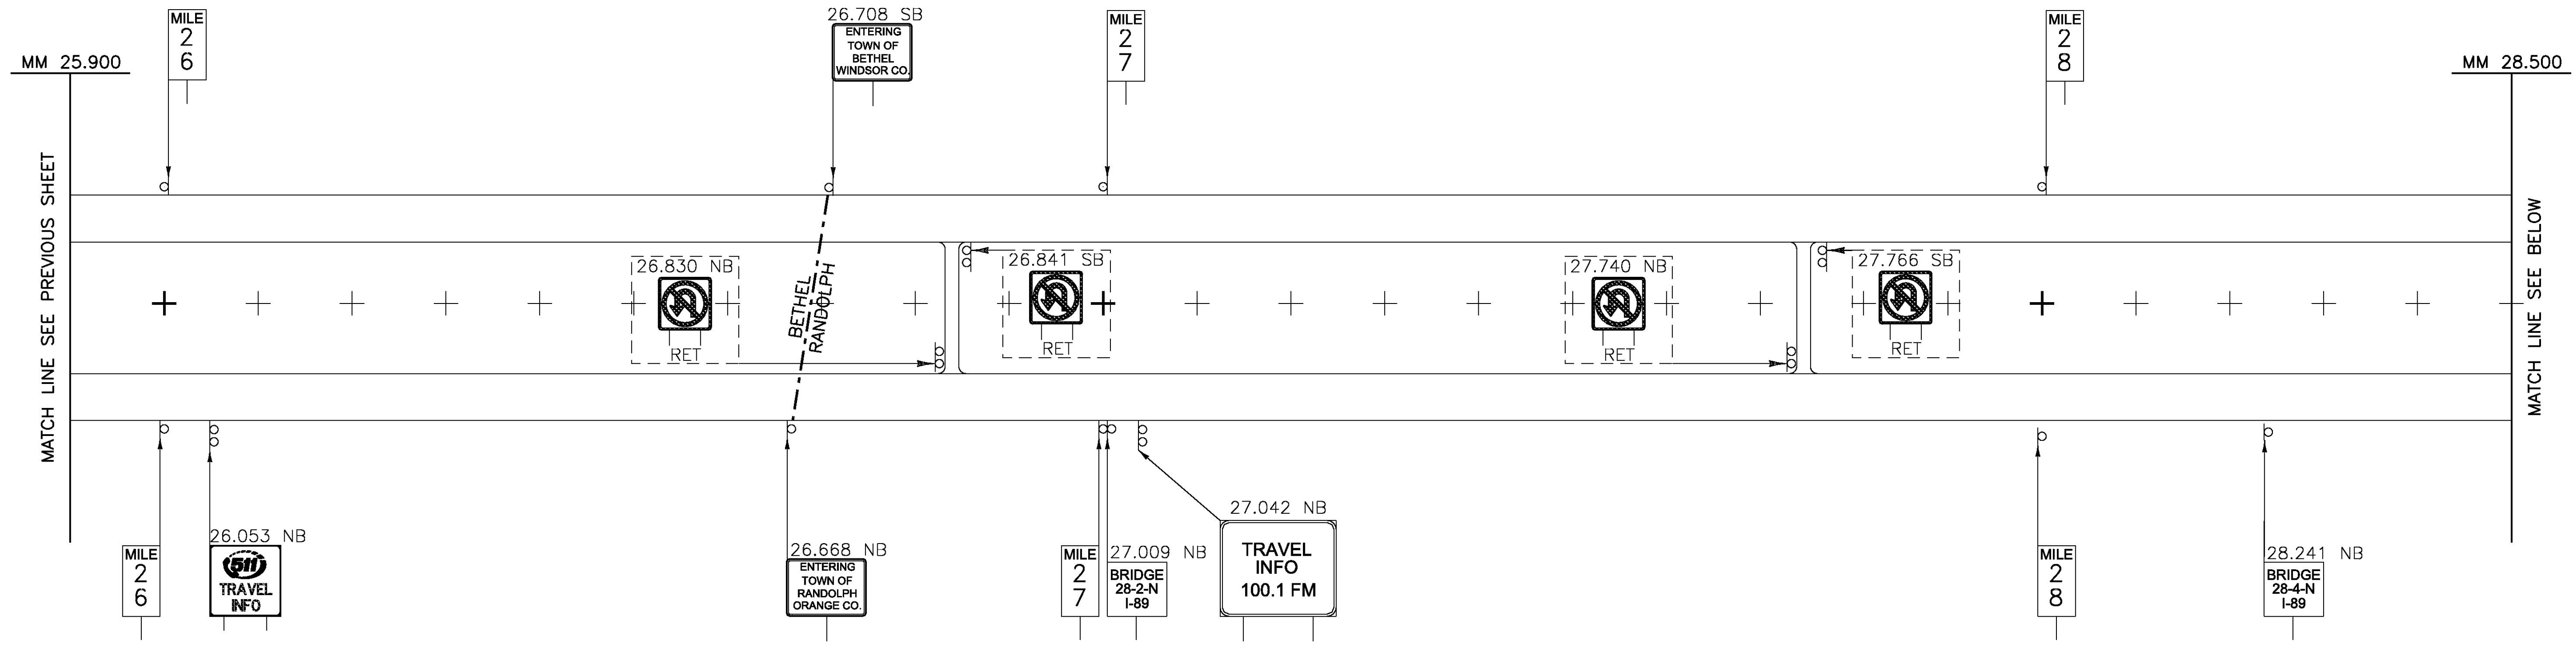

LEGEND  
 [RET] - RETAIN  
 [R&S] - REMOVE AND SALVAGE

ALL SIGNS AND POSTS WILL BE REMOVED UNLESS OTHERWISE NOTED

**EXISTING SIGNS MAINLINE (2) 25.900 - 31.190**

PROJECT NAME: ROYALTON-MIDDLESEX	FILE NAME: z09a020mainline.dgn	PLOT DATE: 8/12/2009
PROJECT NUMBER: IMG SIGN(19)	PROJECT LEADER: CRB	DRAWN BY: JBZ
DESIGNED BY: BDB	CLD REF. NO.: 09-0106	CHECKED BY: DAM
		SHEET 8 OF 163

MODEL: 02-Exist