


REMOVING SIGNS
 TYPE A: 11
 TYPE B: 0
 BRIDGE PLAQUE: 0

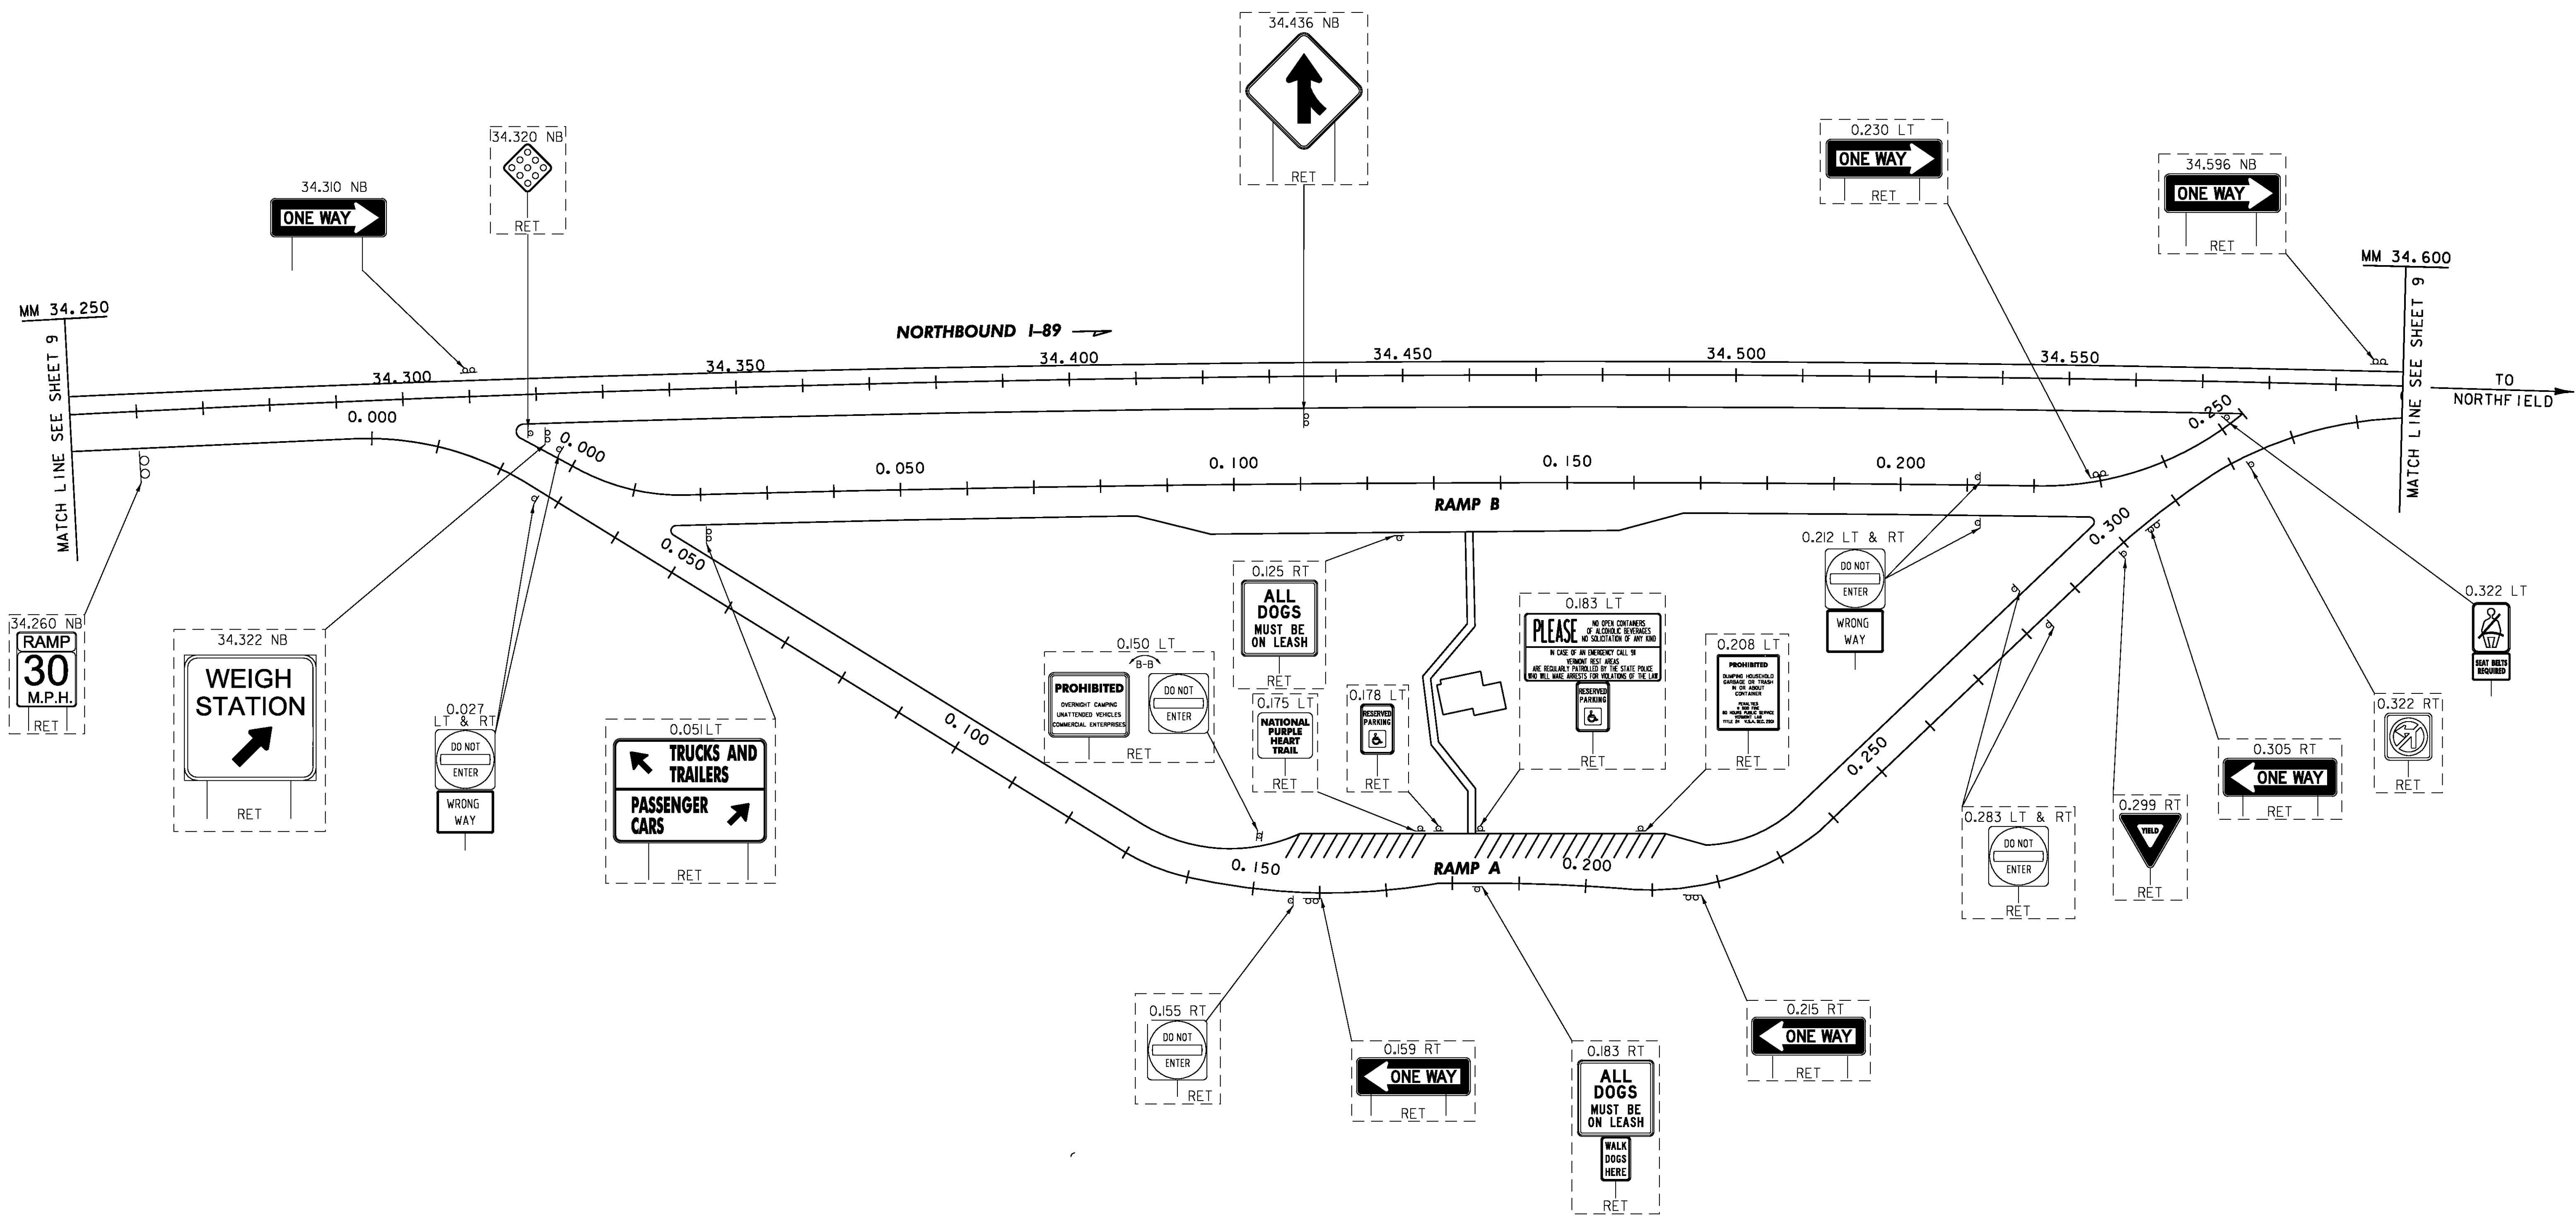

LEGEND
 [RET] - RETAIN
 [R&S] - REMOVE AND SALVAGE

ALL SIGNS AND POSTS WILL BE REMOVED UNLESS OTHERWISE NOTED

**REST AREA
 RANDOLPH - NB
 EXISTING SIGNS
 MM 34.450**

PROJECT NAME: ROYALTON-MIDDLESEX	FILE NAME: z09a020rest-NB(34).dgn	PLOT DATE: 8/12/2009
PROJECT NUMBER: IMG SIGN(19)	PROJECT LEADER: CRB	DRAWN BY: JBZ
DESIGNED BY: BDB	CLD REF. NO.: 09-0106	CHECKED BY: DAM
		SHEET 19 OF 163

MODEL: Exist+