



REMOVING SIGNS  
 TYPE A: 76  
 TYPE B: 4  
 BRIDGE PLAQUE: 2

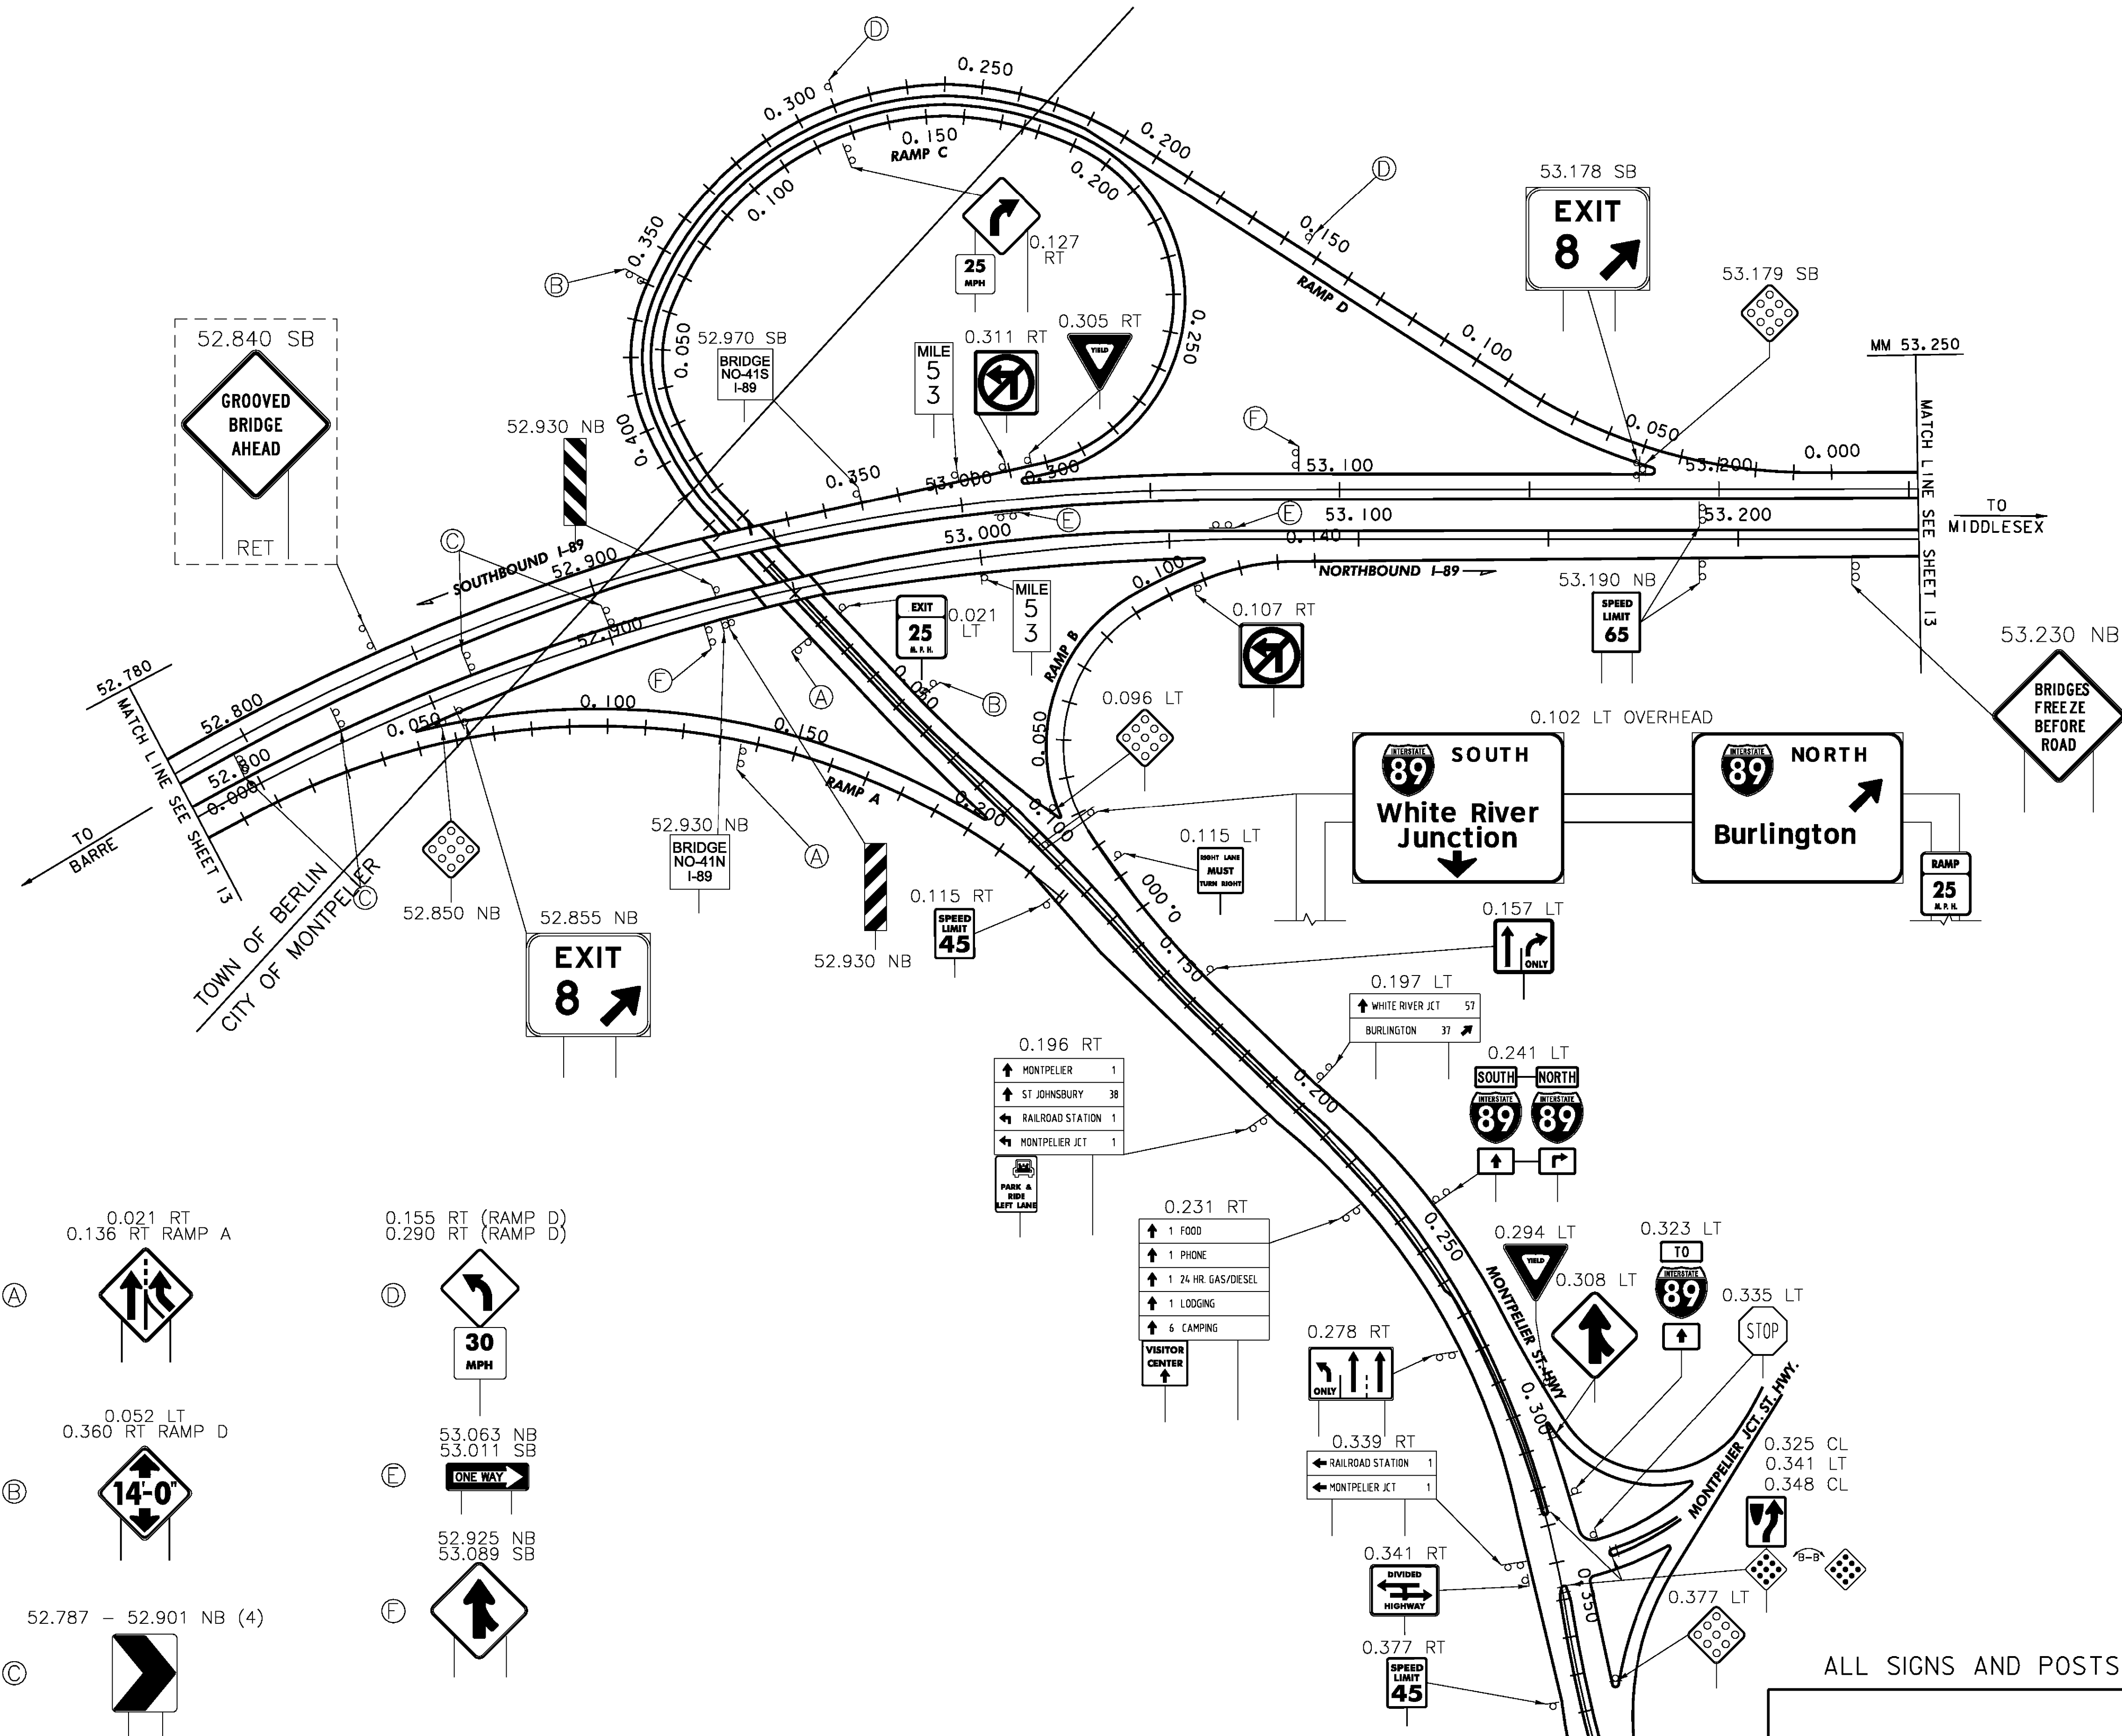

REMOVAL OF 2 SIGNS NOT SHOWN ON PLANS.  
 REPLACED WITH NEW: SEE SHEET 41L 2.0 EACH

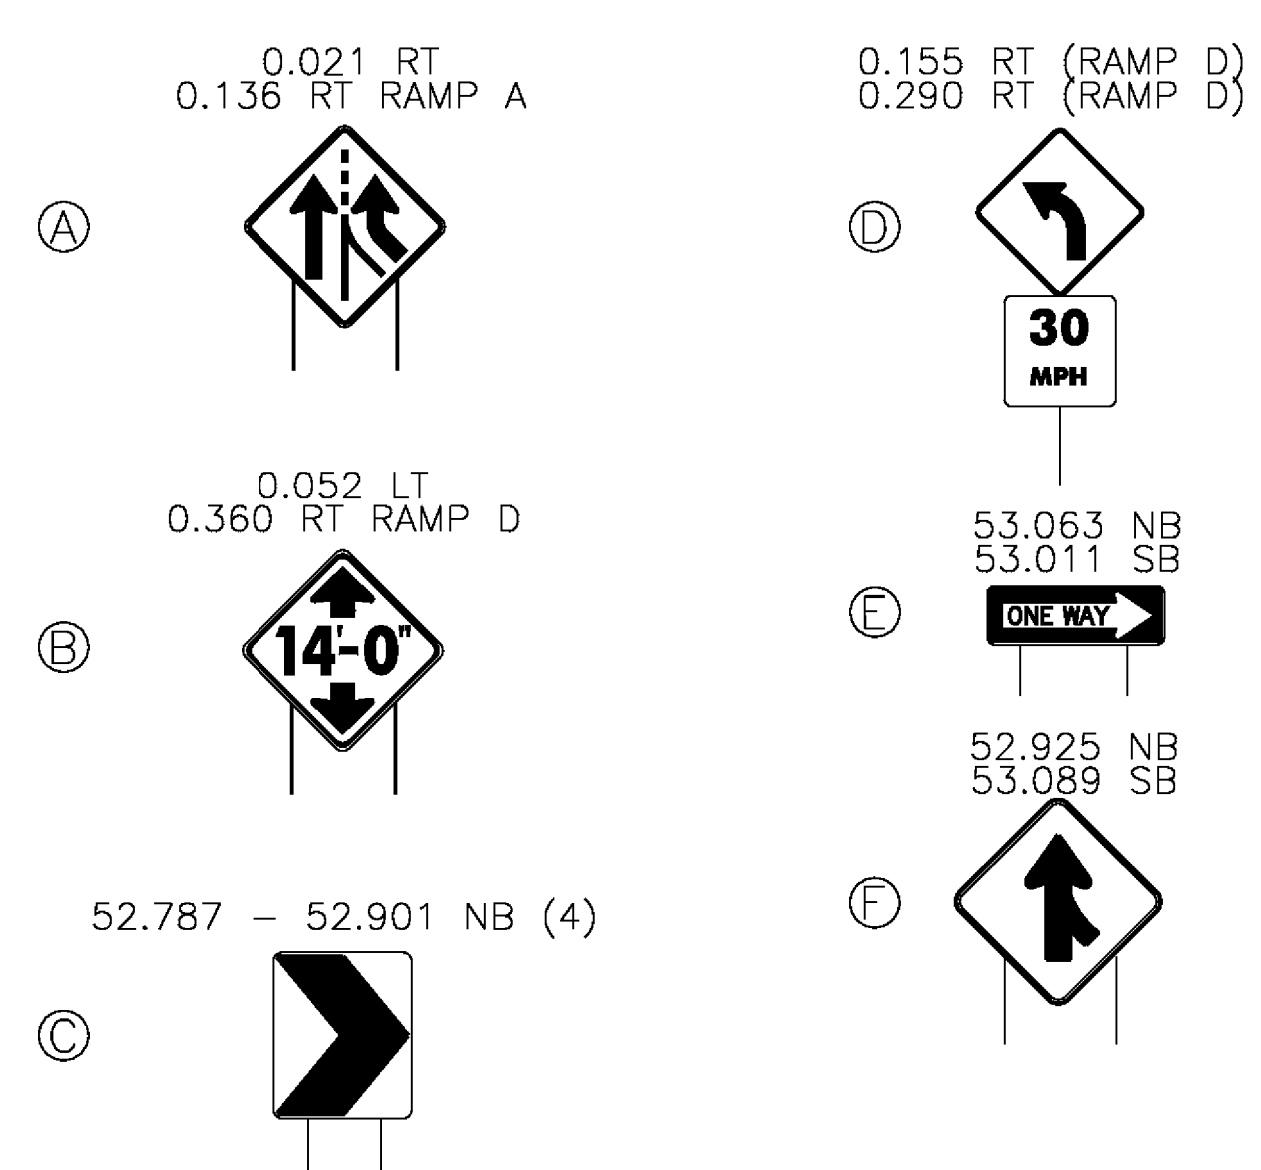

LEGEND  
 [RET] - RETAIN  
 [R&S] - REMOVE AND SALVAGE

ALL SIGNS AND POSTS WILL BE REMOVED UNLESS OTHERWISE NOTED

<h3>INTERCHANGE 8 EXISTING SIGNS</h3>	PROJECT NAME: ROYALTON-MIDDLESEX
	PROJECT NUMBER: IMG SIGN(I9)
	FILE NAME: z09a020in+08.dgn
	CLD REF. NO.: 09-0106
DESIGNED BY: BDB	PLOT DATE: 8/12/2009
PROJECT LEADER: CRB	DRAWN BY: JBZ
CHECKED BY: DAM	SHEET 23 OF 163

MODEL: Exist