
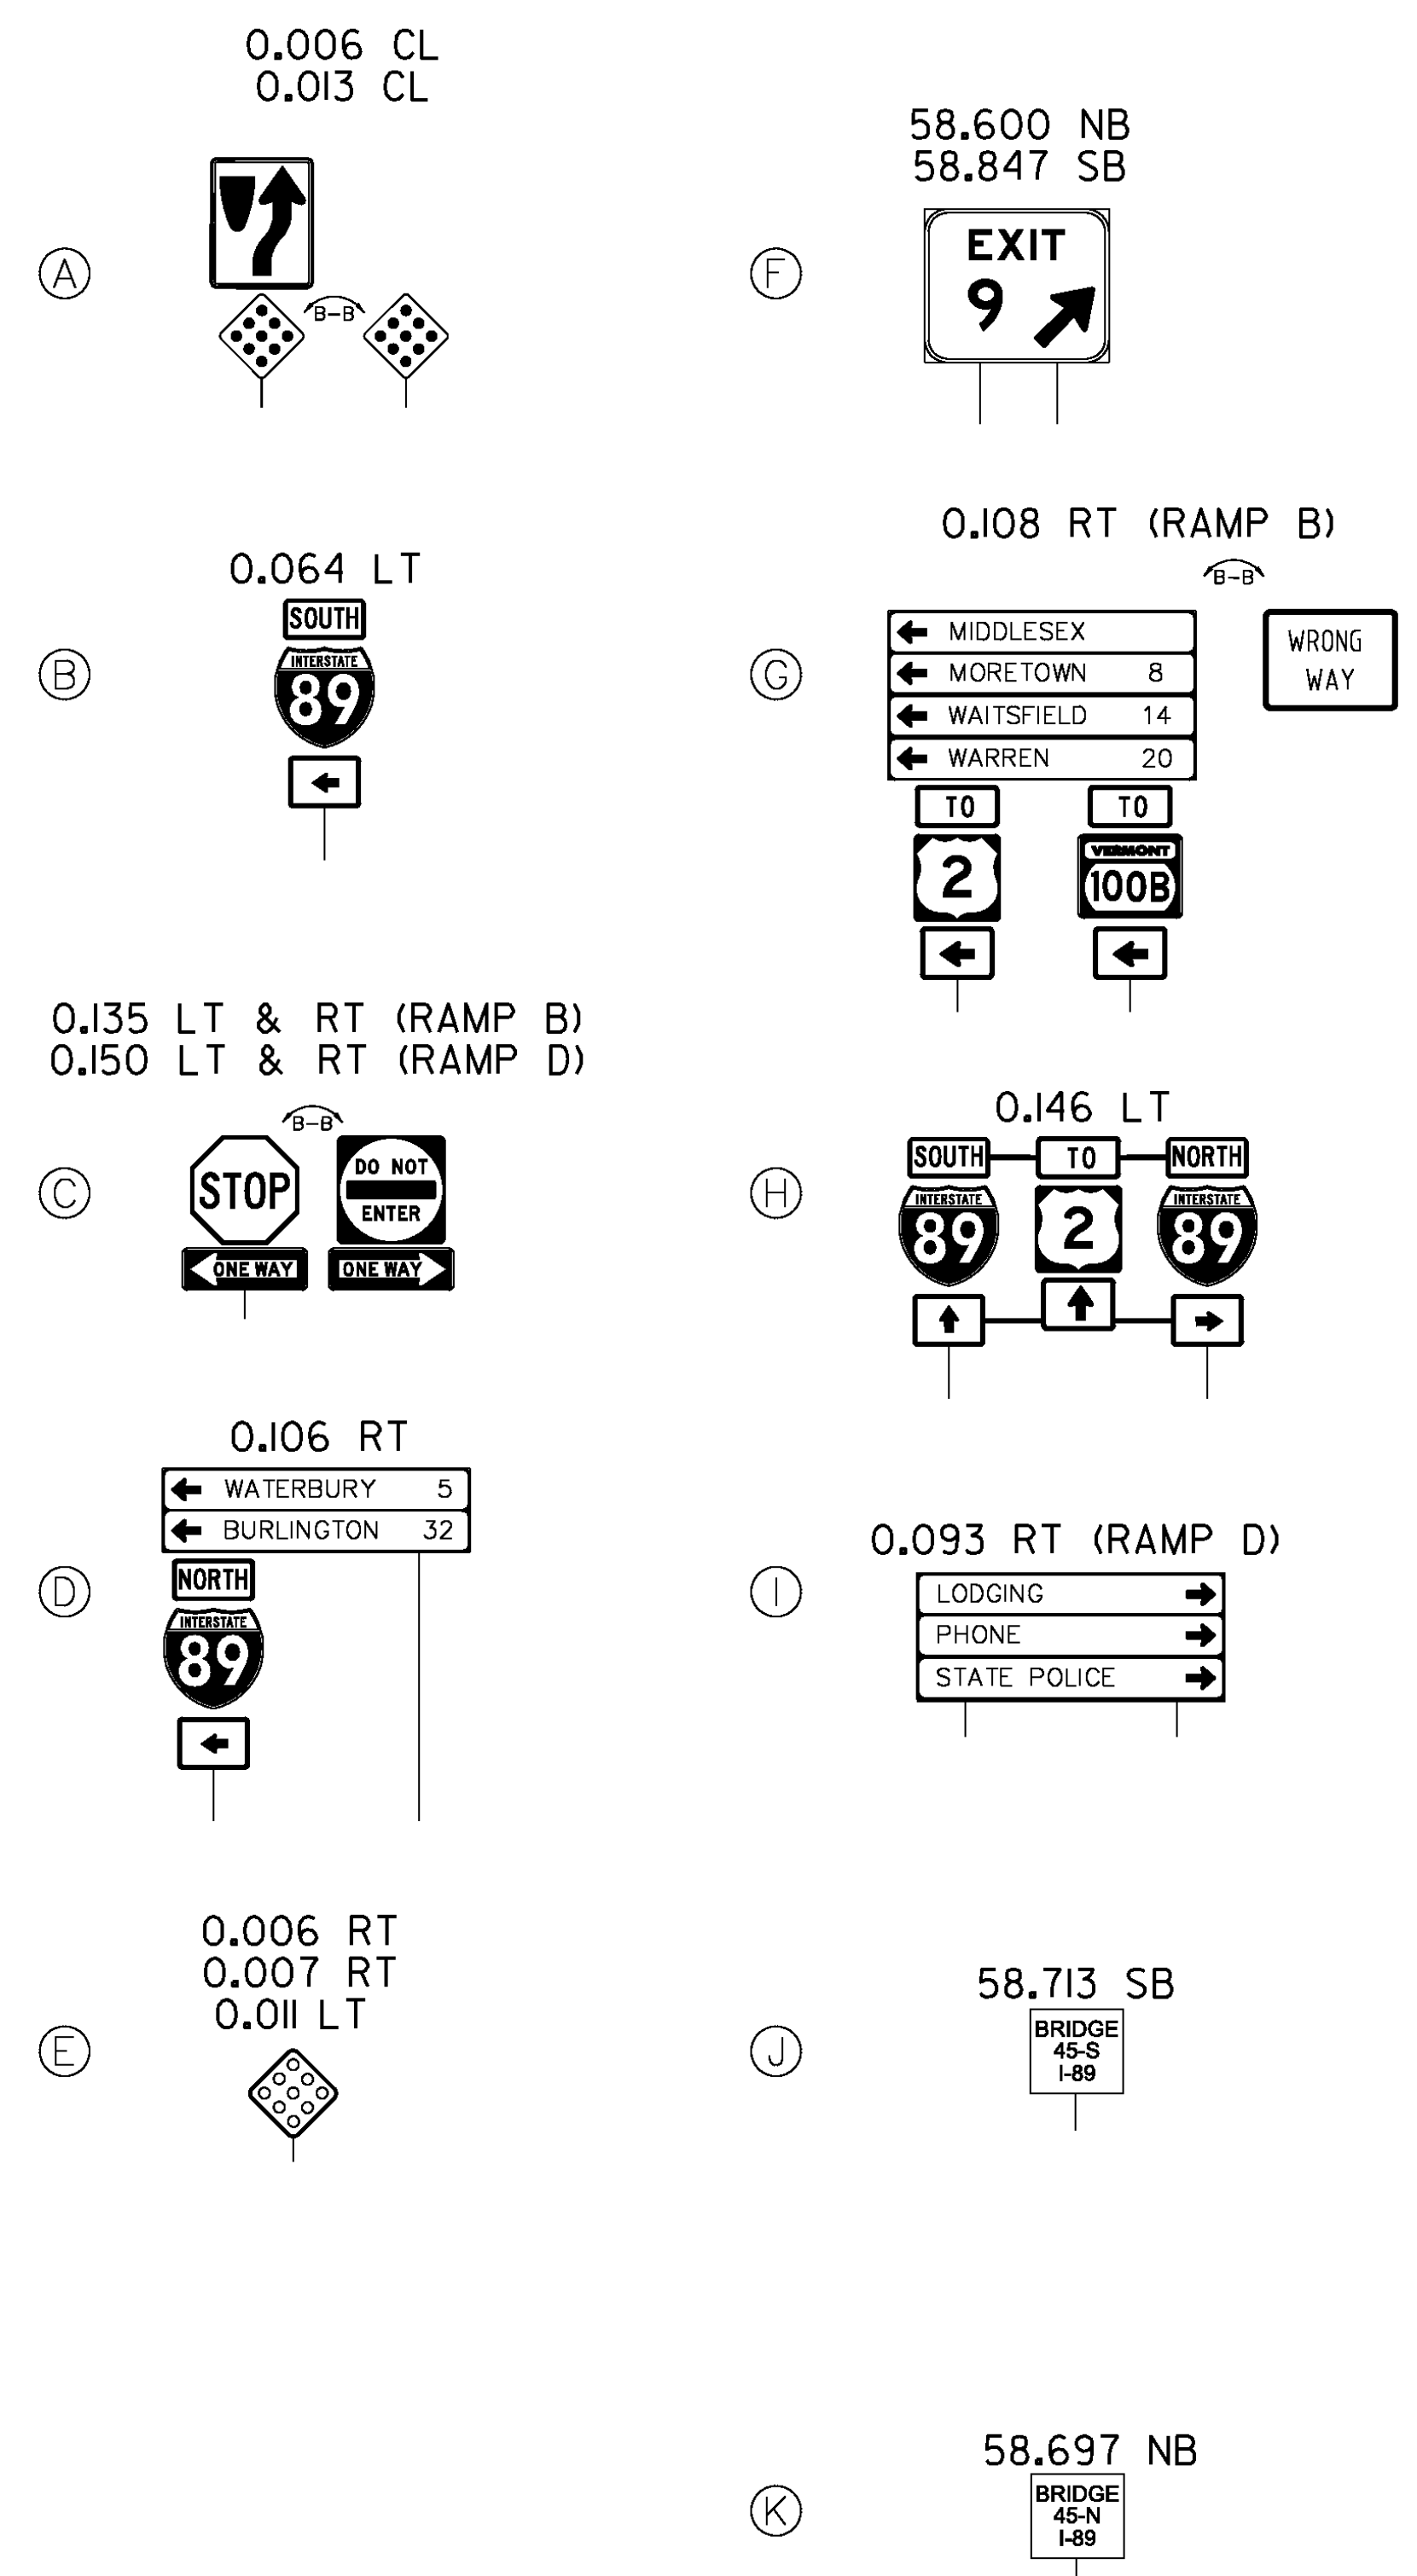


REMOVING SIGNS
 TYPE A: 131
 TYPE B: 2
 BRIDGE PLAQUE: 2

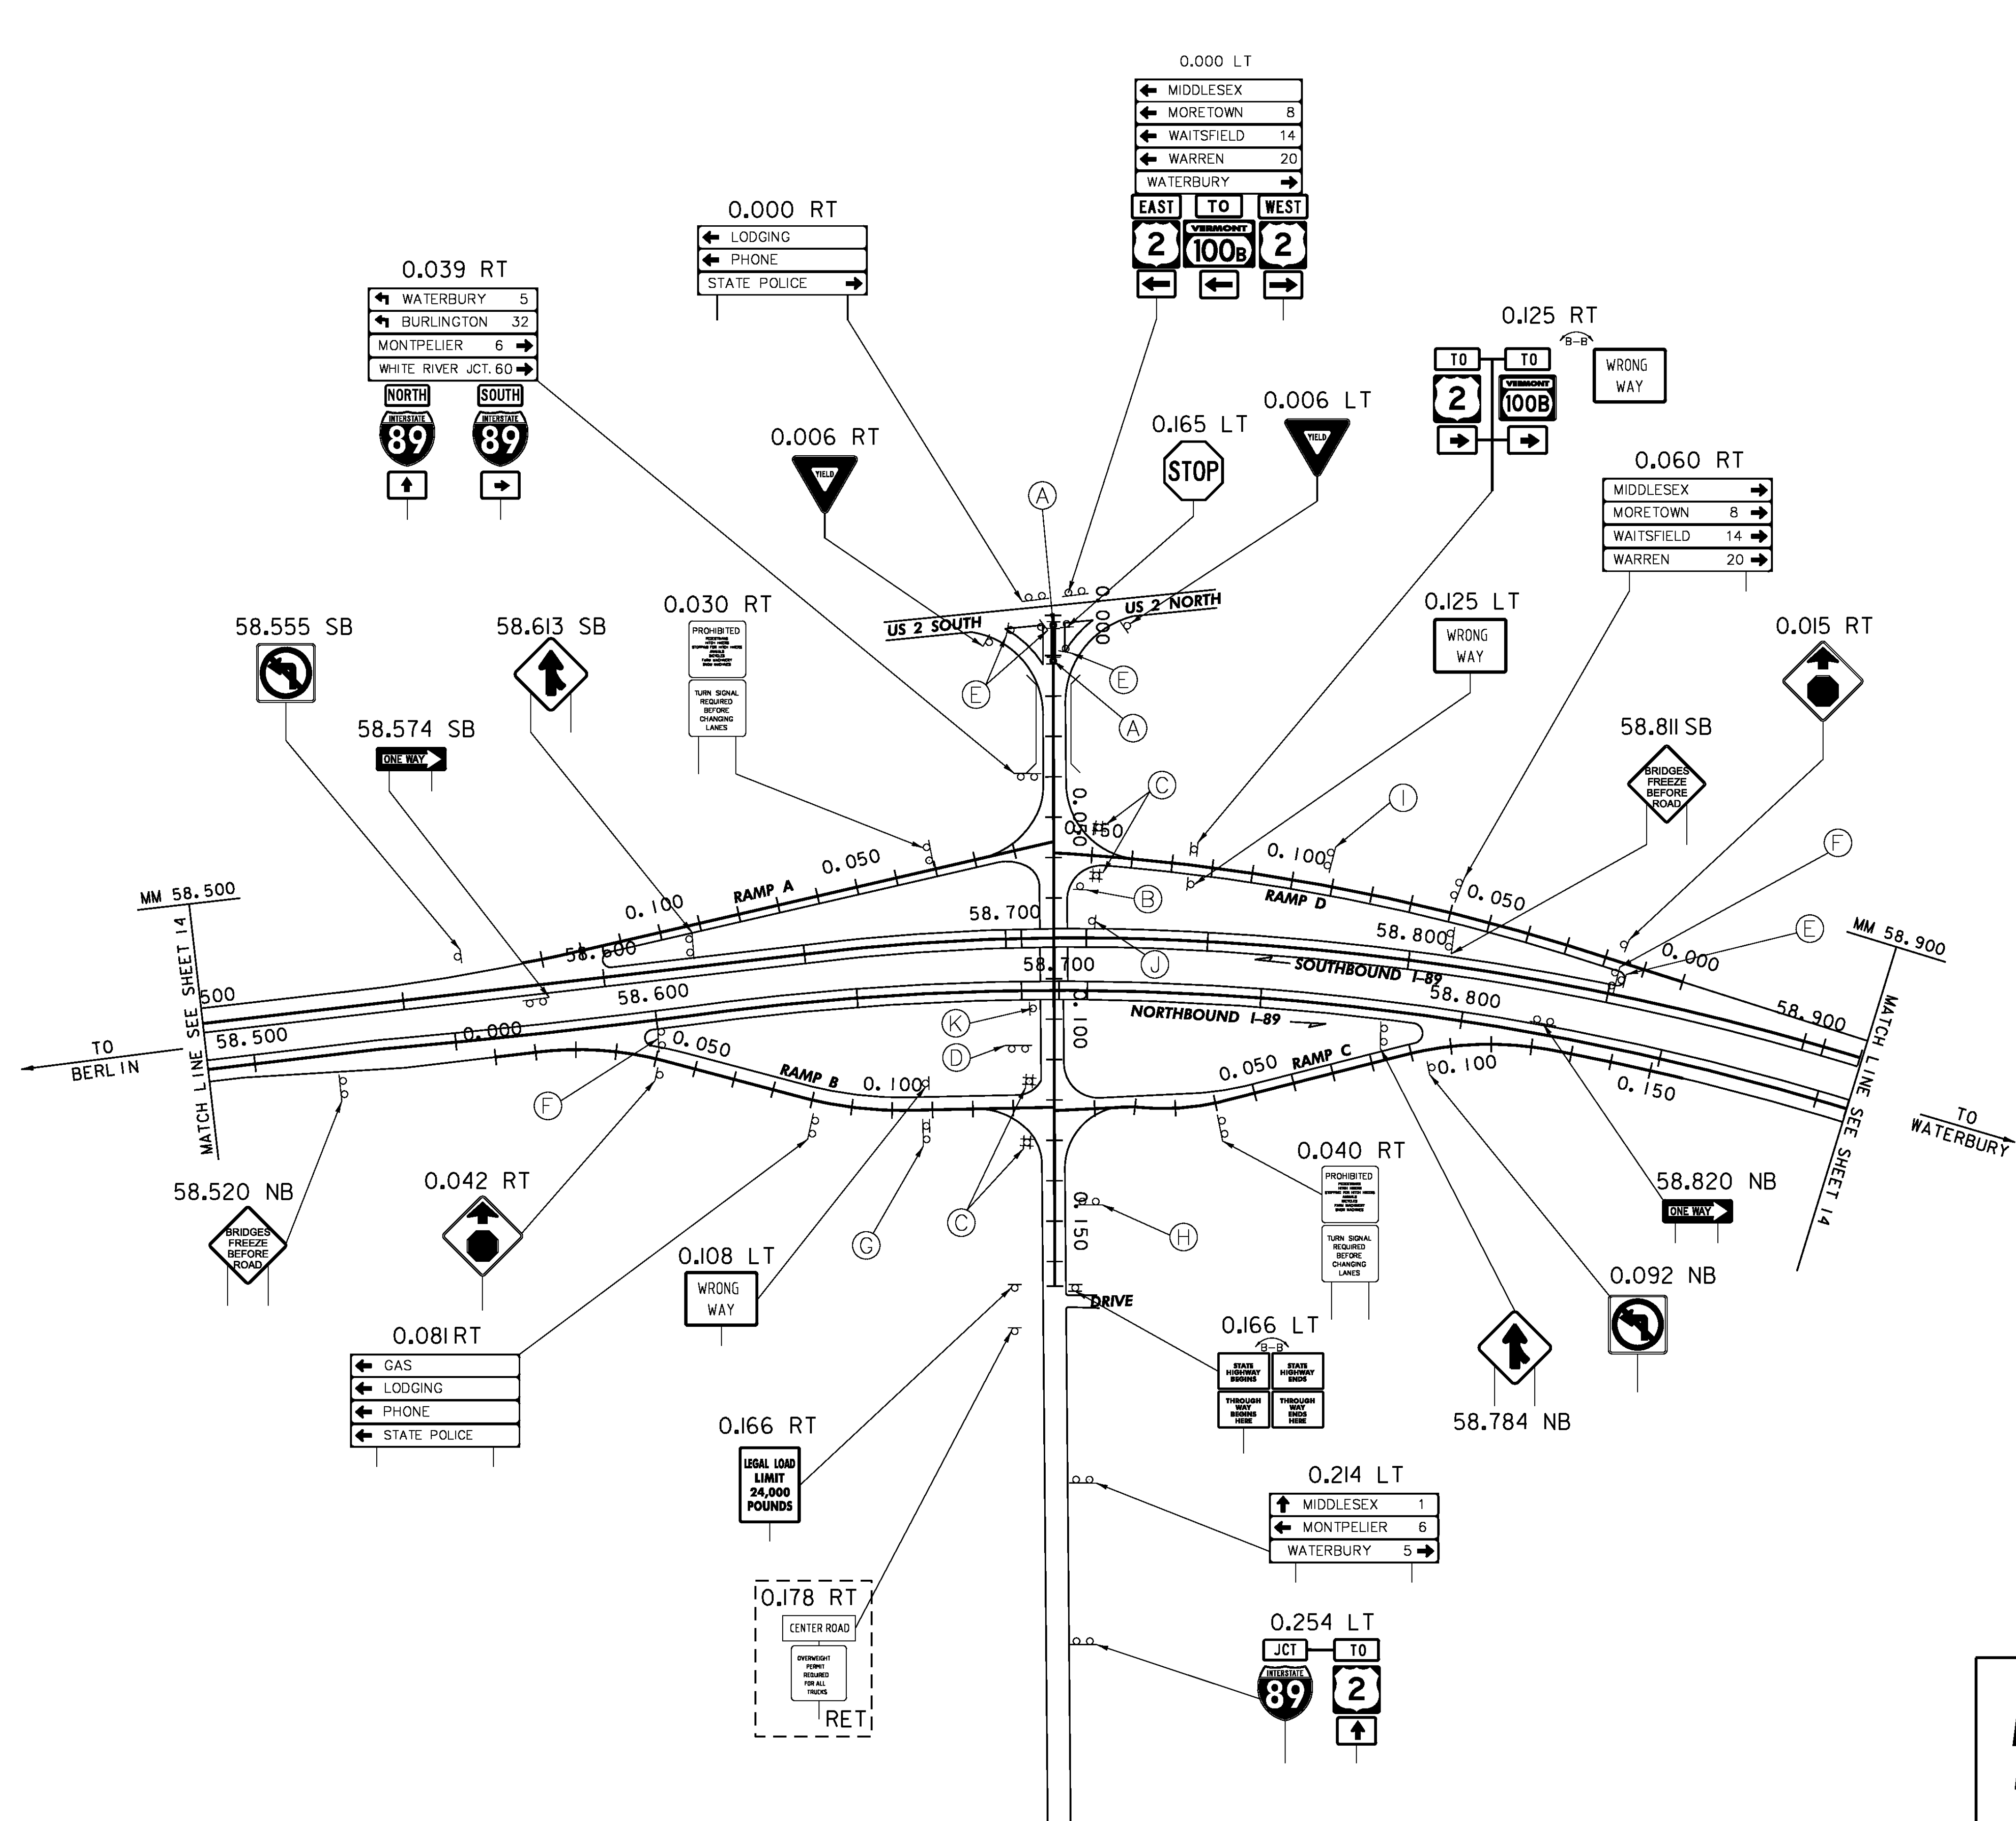

ALL SIGNS AND POSTS WILL BE REMOVED UNLESS OTHERWISE NOTED

**INTERCHANGE 9
 EXISTING SIGNS**

PROJECT NAME:	ROYALTON-MIDDLESEX
PROJECT NUMBER:	IMG SIGN(19)
FILE NAME:	z09a020int09.dgn
PROJECT LEADER:	CRB
DESIGNED BY:	BDB
CLD REF. NO.:	09-0106
PLOT DATE:	8/12/2009
DRAWN BY:	JBZ
CHECKED BY:	DAM
SHEET	24 OF 163

MODEL: Exist