
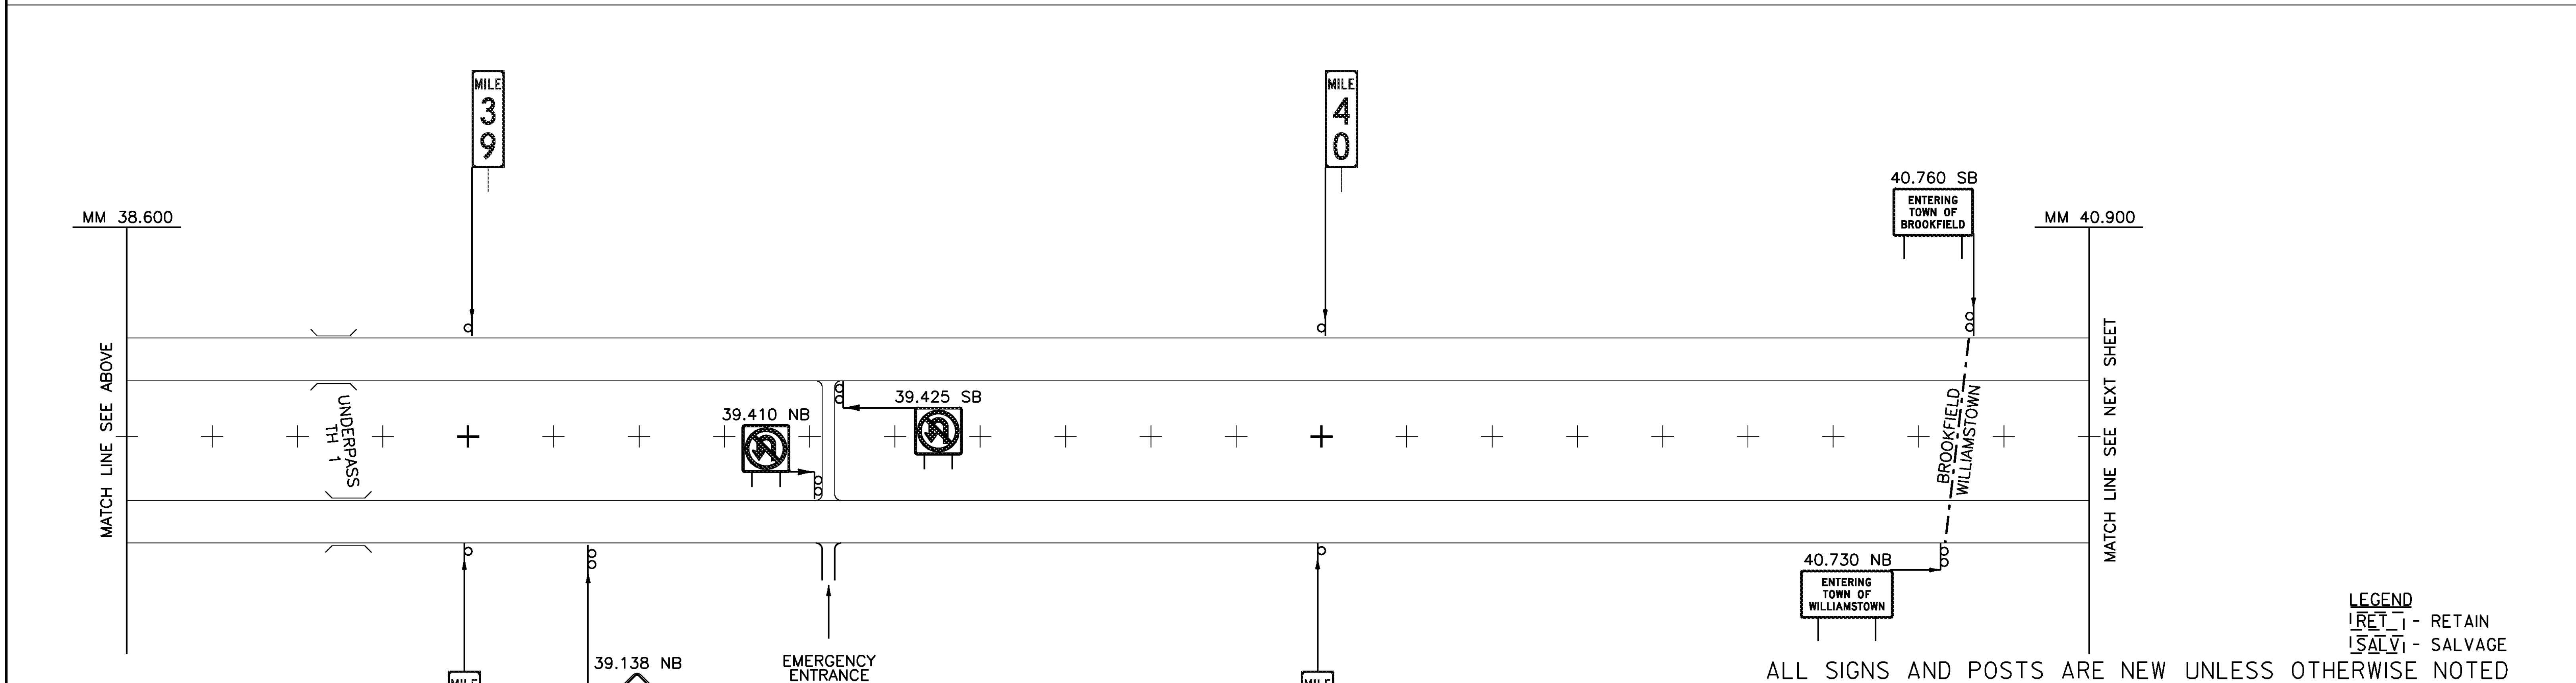


MODEL: 04-New

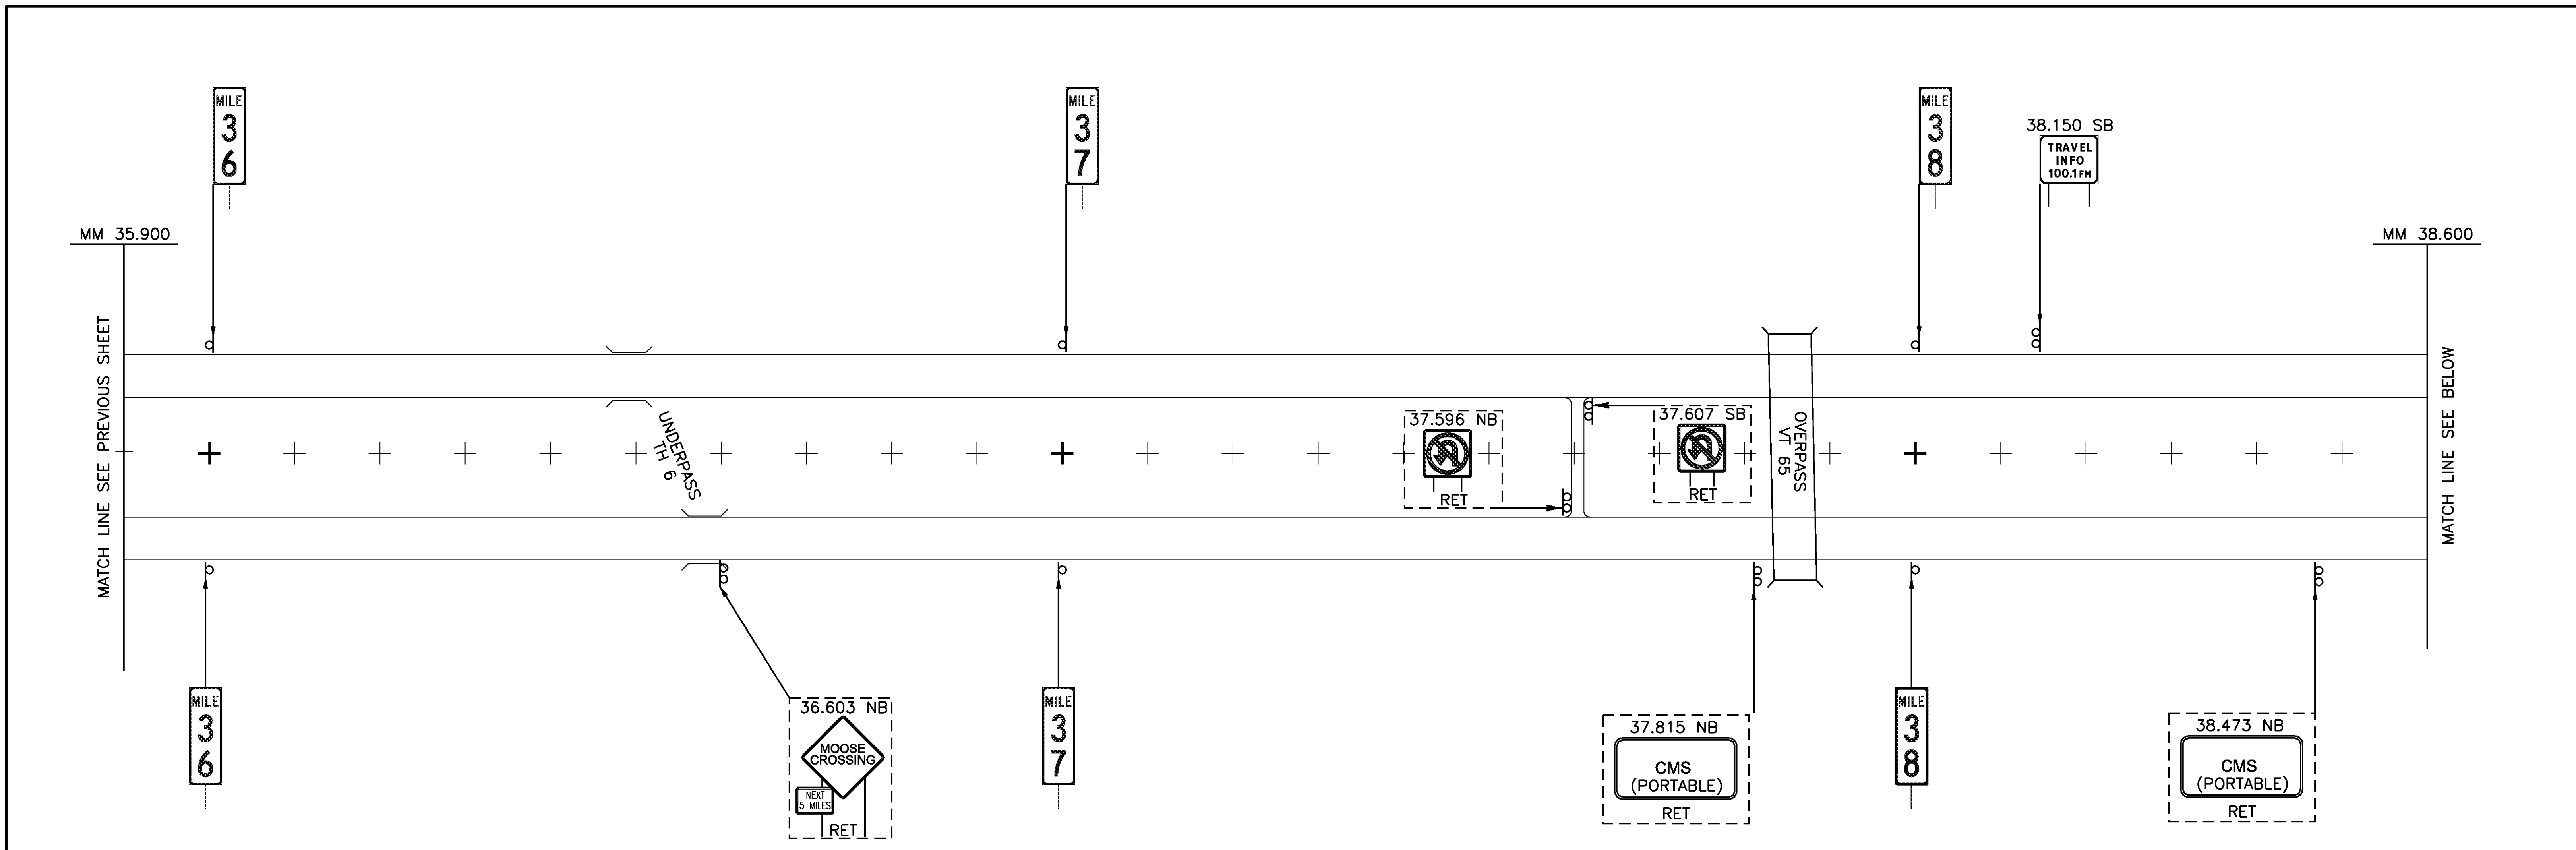

LEGEND
 RET - RETAIN
 SALV - SALVAGE

ALL SIGNS AND POSTS ARE NEW UNLESS OTHERWISE NOTED

NEW SIGNS MAINLINE (4) 35.900 - 40.900		PROJECT NAME: ROYALTON-MIDDLESEX	
		PROJECT NUMBER: IMG SIGN(19)	
FILE NAME: z09a020mainline.dgn	DESIGNED BY: BDB	CLD REF. NO.: 09-0106	PLOT DATE: 8/12/2009
PROJECT LEADER: CRB	CHECKED BY: DAM	DRAWN BY: JBZ	
		SHEET 28 OF 163	