


MODEL: NEW

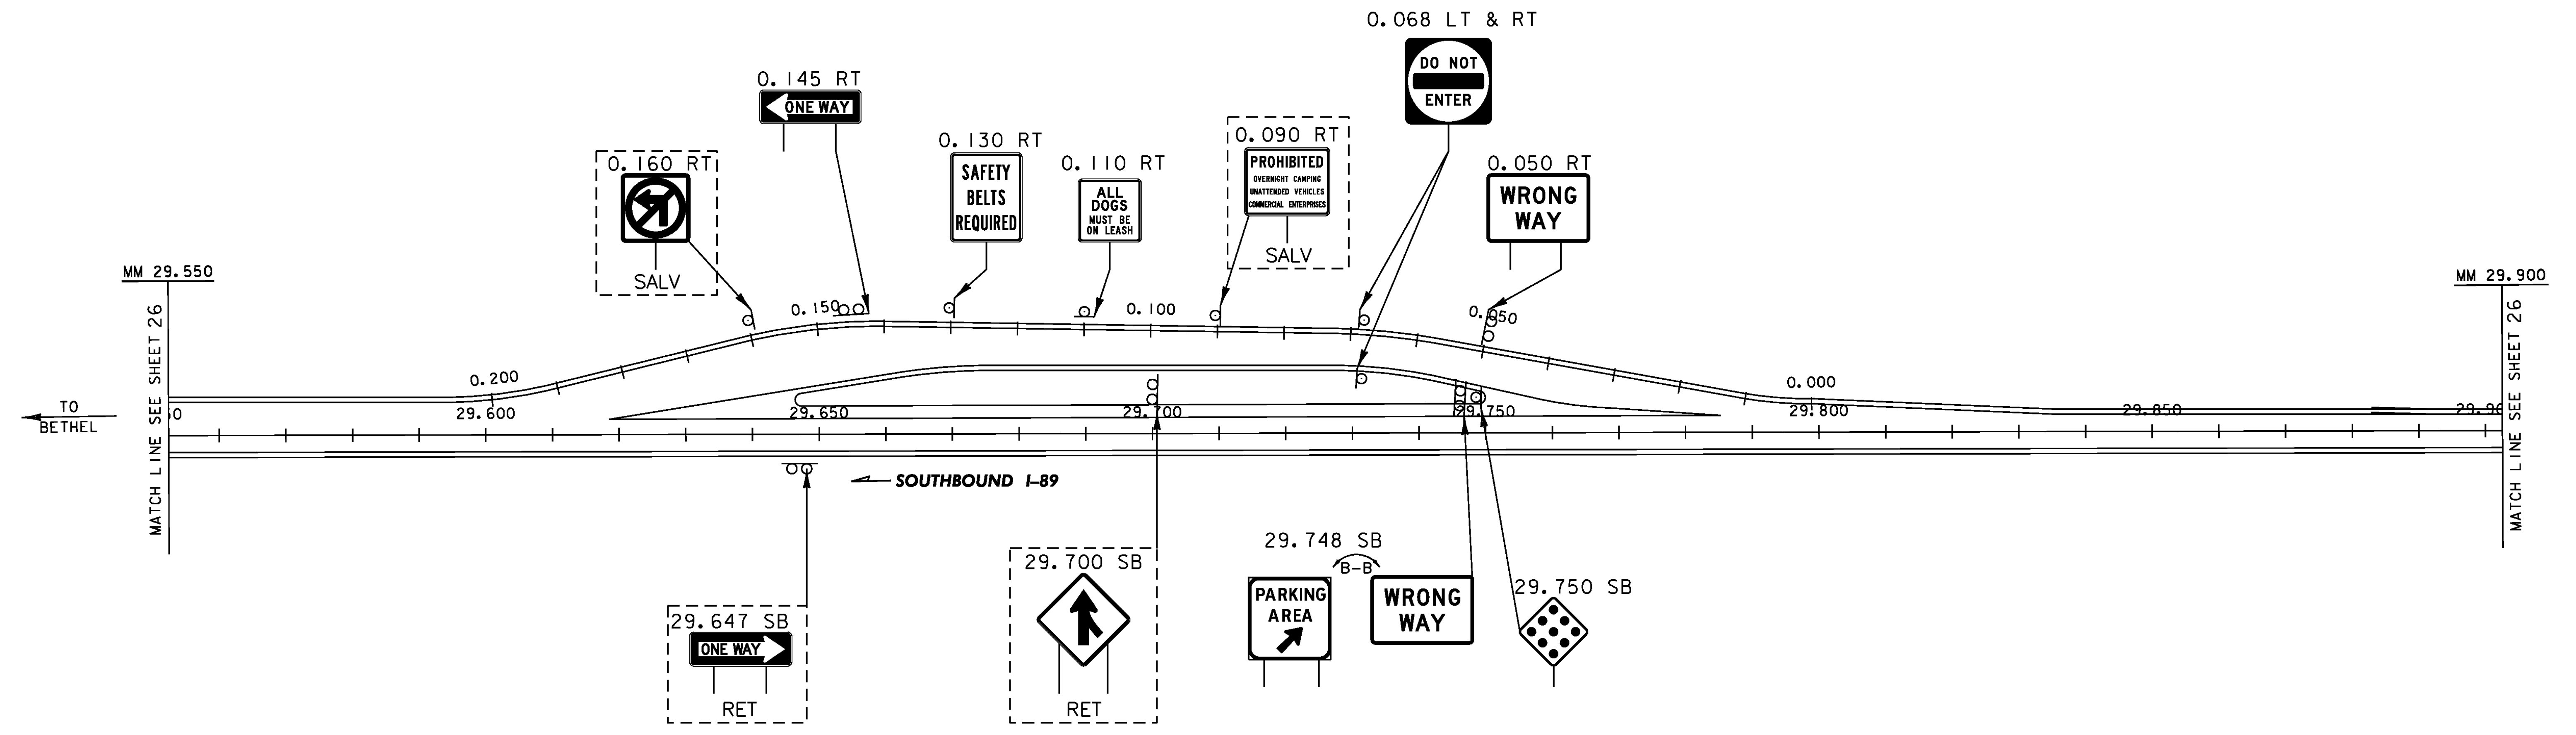

LEGEND
 [RET] - RETAIN
 [SALV] - SALVAGE

ALL SIGNS AND POSTS ARE NEW UNLESS OTHERWISE NOTED

PARKING AREA RANDOLPH - SB NEW SIGNS MM 29.675	PROJECT NAME: ROYALTON-MIDDLESEX
	PROJECT NUMBER: IMG SIGN(19)
	FILE NAME: z09a020rest-SB(29.70).dgn
	CLD REF.NO.: 09-0106
	PLOT DATE: 8/12/2009
	DRAWN BY: JBZ
	CHECKED BY: DAM
	SHEET 34 OF 163