


MODEL: NEW

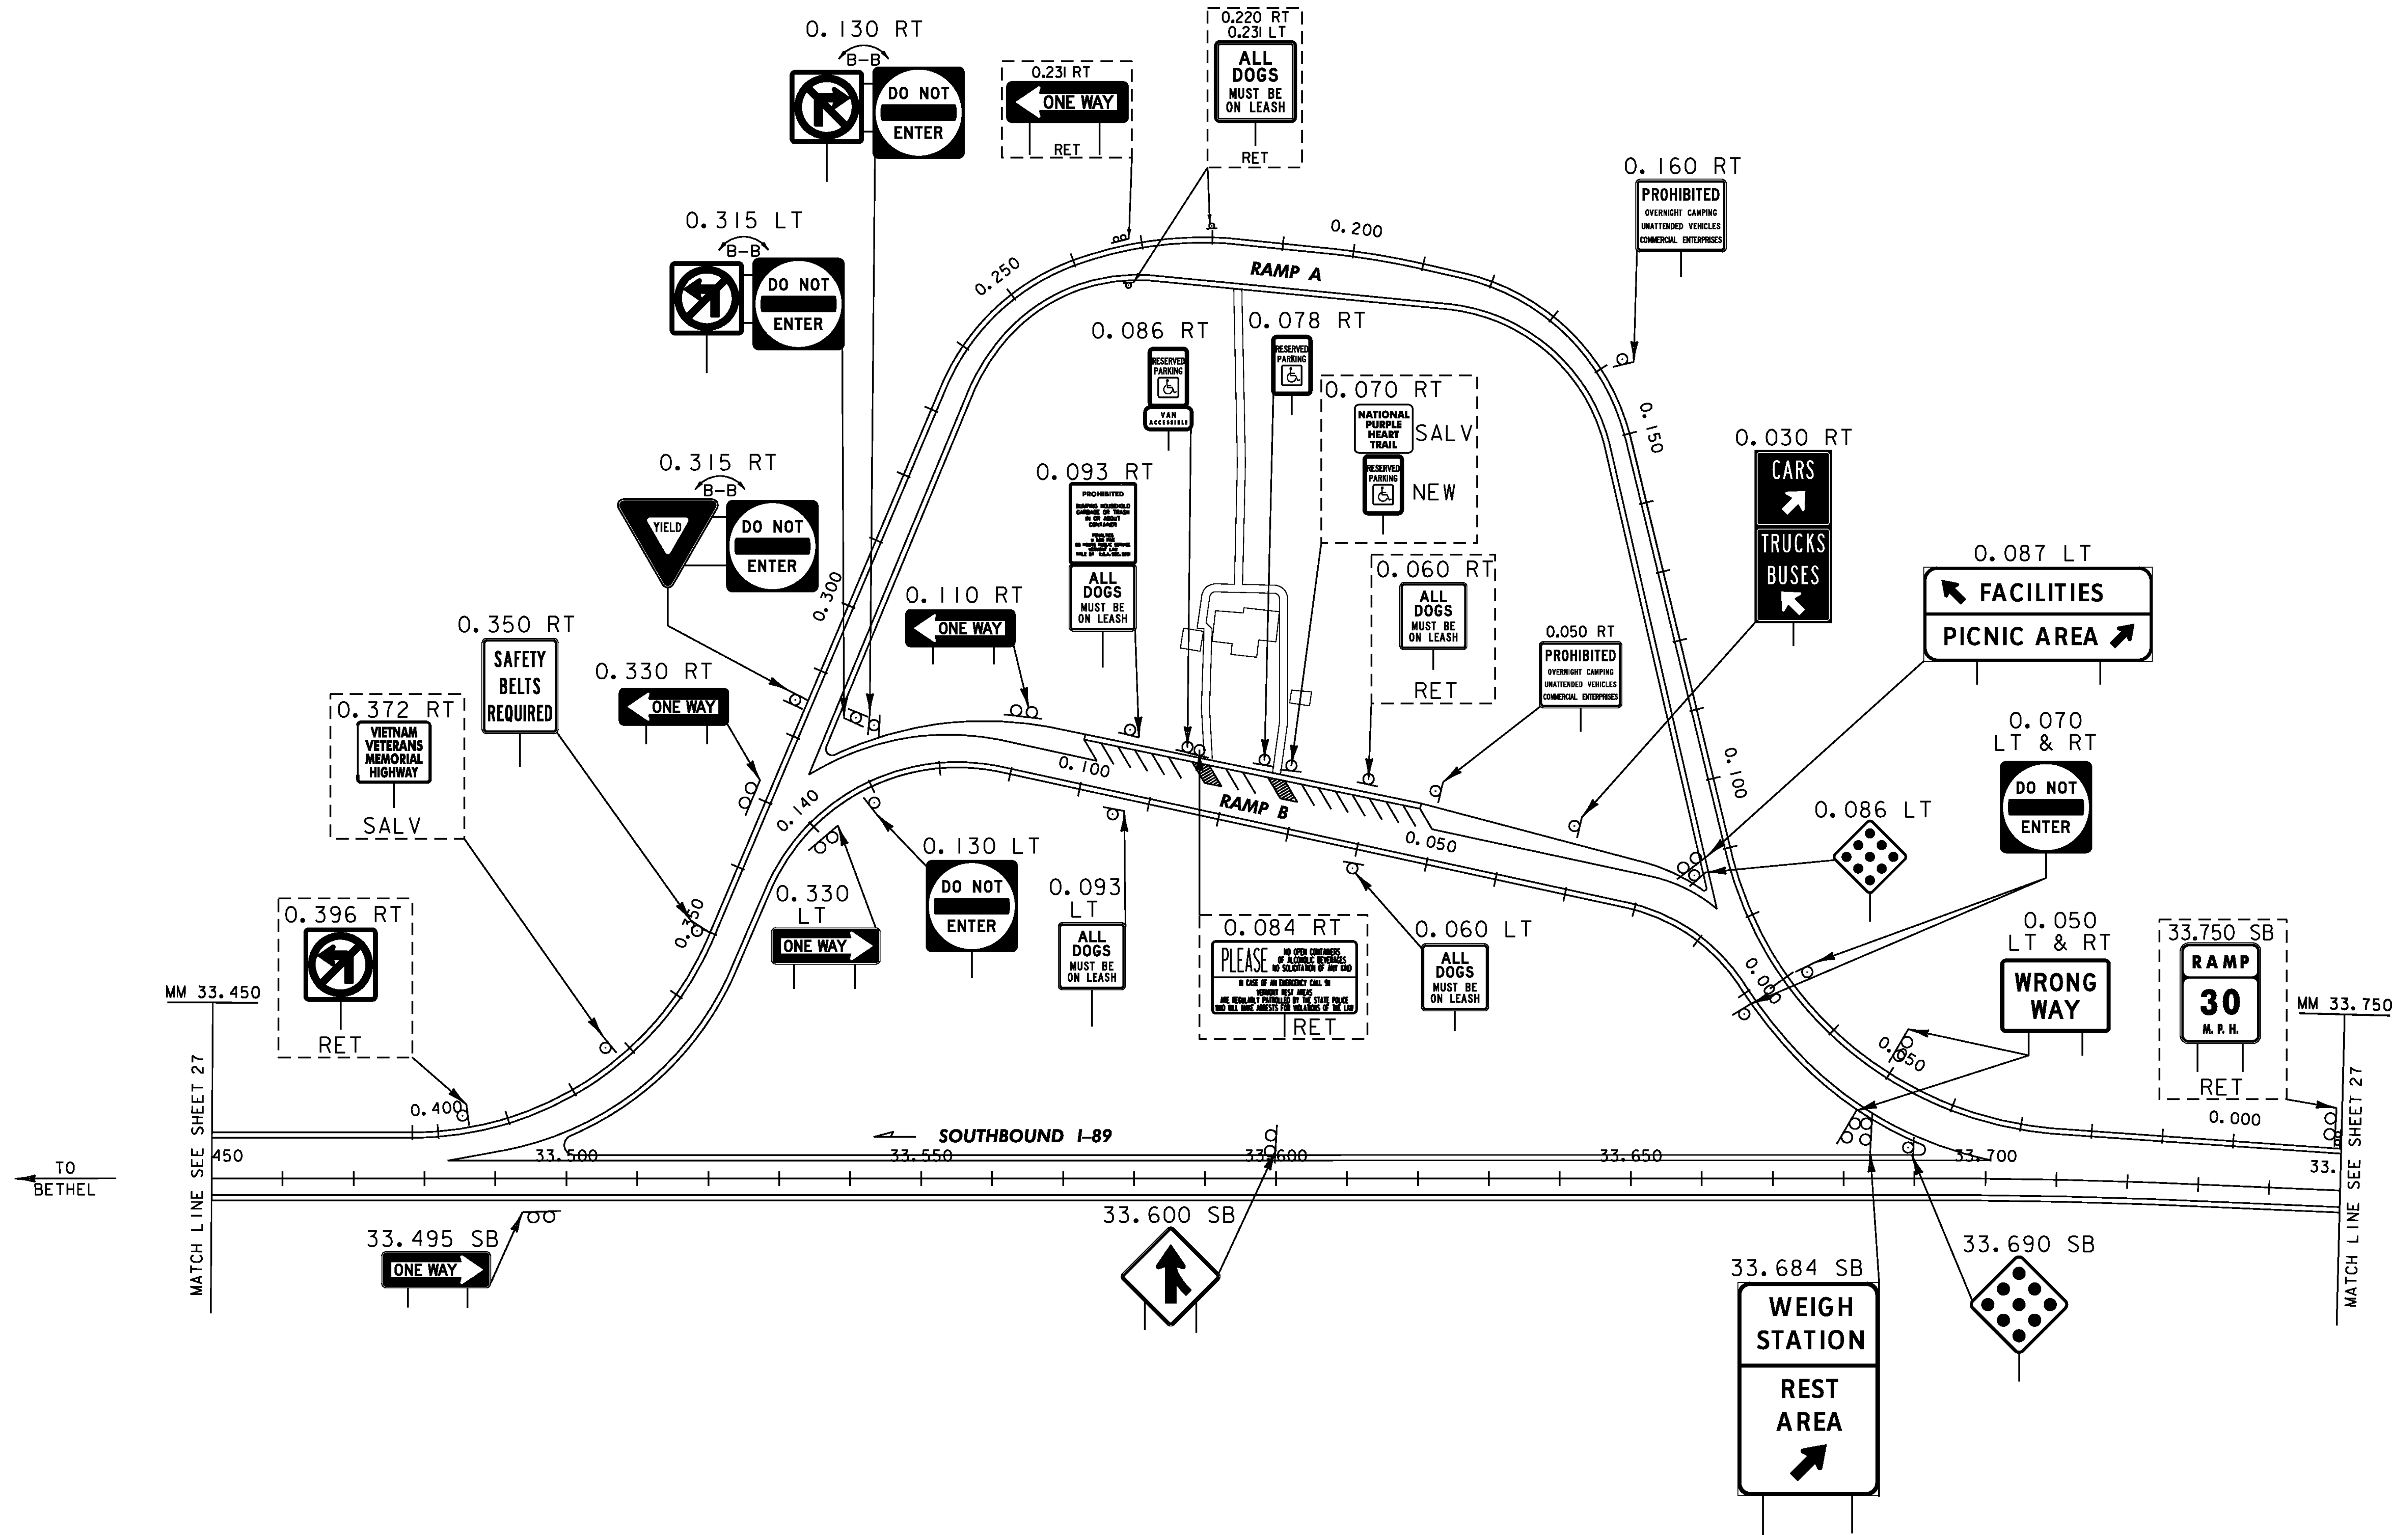

**LEGEND**  
 [RET] - RETAIN  
 [SALV] - SALVAGE

ALL SIGNS AND POSTS ARE NEW UNLESS OTHERWISE NOTED

<b>REST AREA          RANDOLPH - SB          NEW SIGNS          MM 33.600</b>	PROJECT NAME: ROYALTON-MIDDLESEX
	PROJECT NUMBER: IMG SIGN(19)
	FILE NAME: z09a020rest-SB(34).dgn
	PLOT DATE: 8/12/2009
	PROJECT LEADER: CRB
	DESIGNED BY: BDB
	CLD REF. NO.: 09-0106
	DRAWN BY: JBZ
	CHECKED BY: DAM
	SHEET 36 OF 163