


NOTE  
FOR TYPICAL PLACEMENT OF DELINEATORS  
SEE STANDARDS E-197 AND SHEET 4.

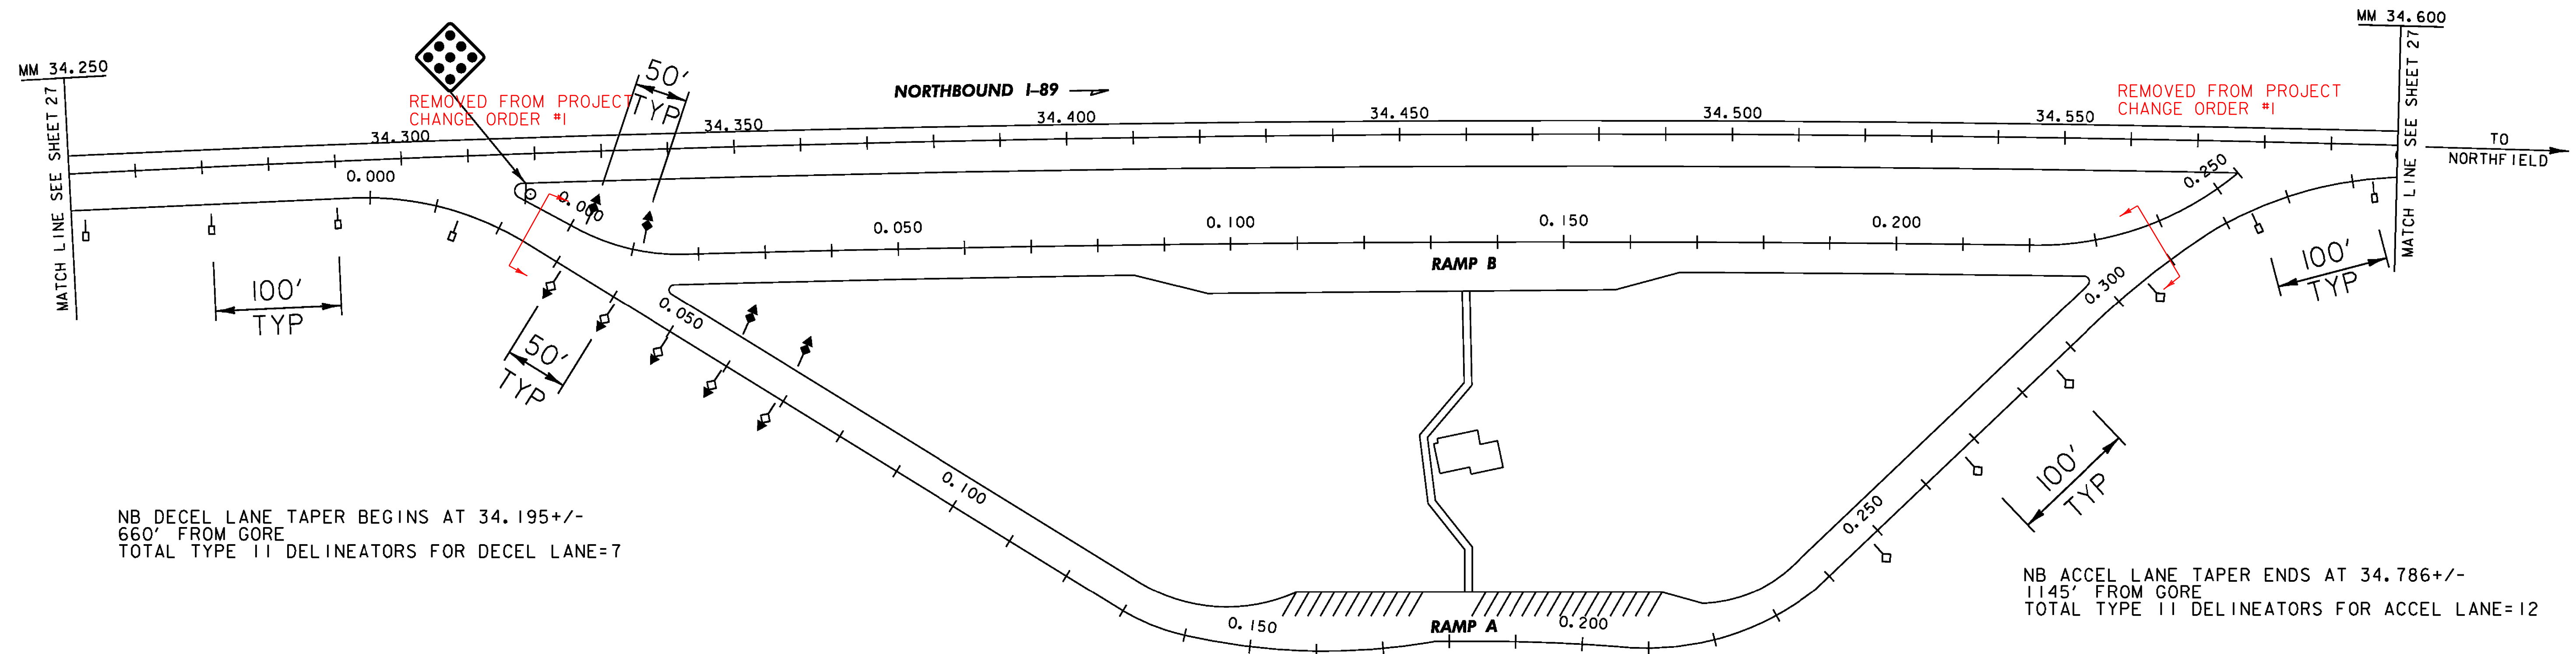

**LEGEND**

- ↑ TYPE I (YELLOW)
- ◇ TYPE I (WHITE)
- ⊥ TYPE II (WHITE)
- ⬆ TYPE III (YELLOW, RED ON BACK)
- ⬆ TYPE III (WHITE, RED ON BACK)

**REST AREA  
RANDOLPH - NB  
DELINEATOR  
LAYOUT  
MM 34.450**

PROJECT NAME: ROYALTON-MIDDLESEX  
PROJECT NUMBER: IMG SIGN(19)

FILE NAME: z09a020rest-nb(34).dgn PLOT DATE: 8/12/2009  
PROJECT LEADER: CRB DRAWN BY: JBZ  
DESIGNED BY: BDB CHECKED BY: BDB  
CLD REF. NO.: 09-0106 SHEET 47 OF 163