



MM 21.320 NB

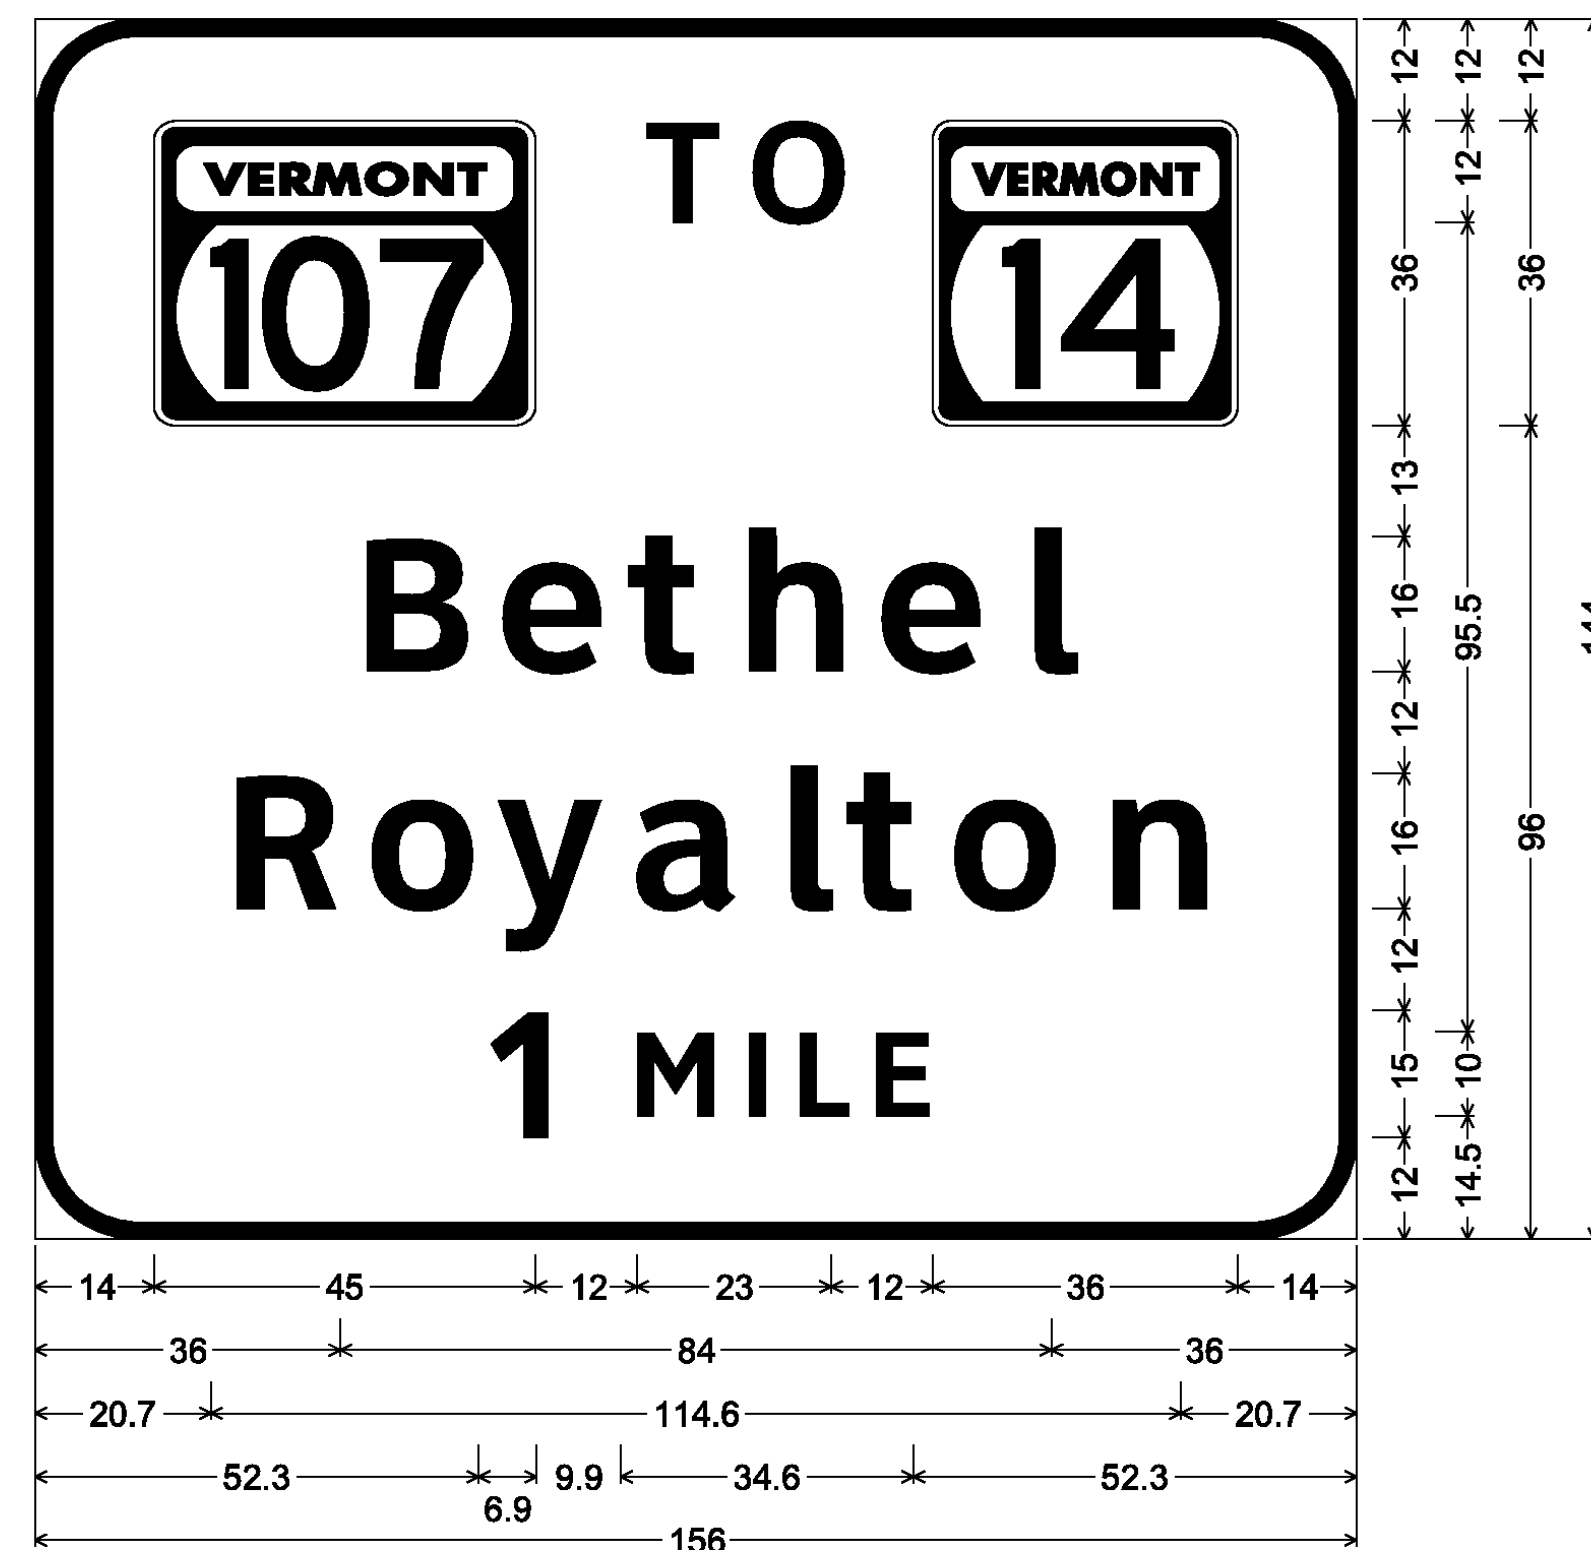


12.0" Radius, 2.0" Border, White on Green;  
 VT107; [TO] ClearviewHwy-5-W; 14; [Bethel] ClearviewHwy-5-W;  
 [Royalton] ClearviewHwy-5-W; [1 MILE] ClearviewHwy-5-W;

MM 21.650 NB

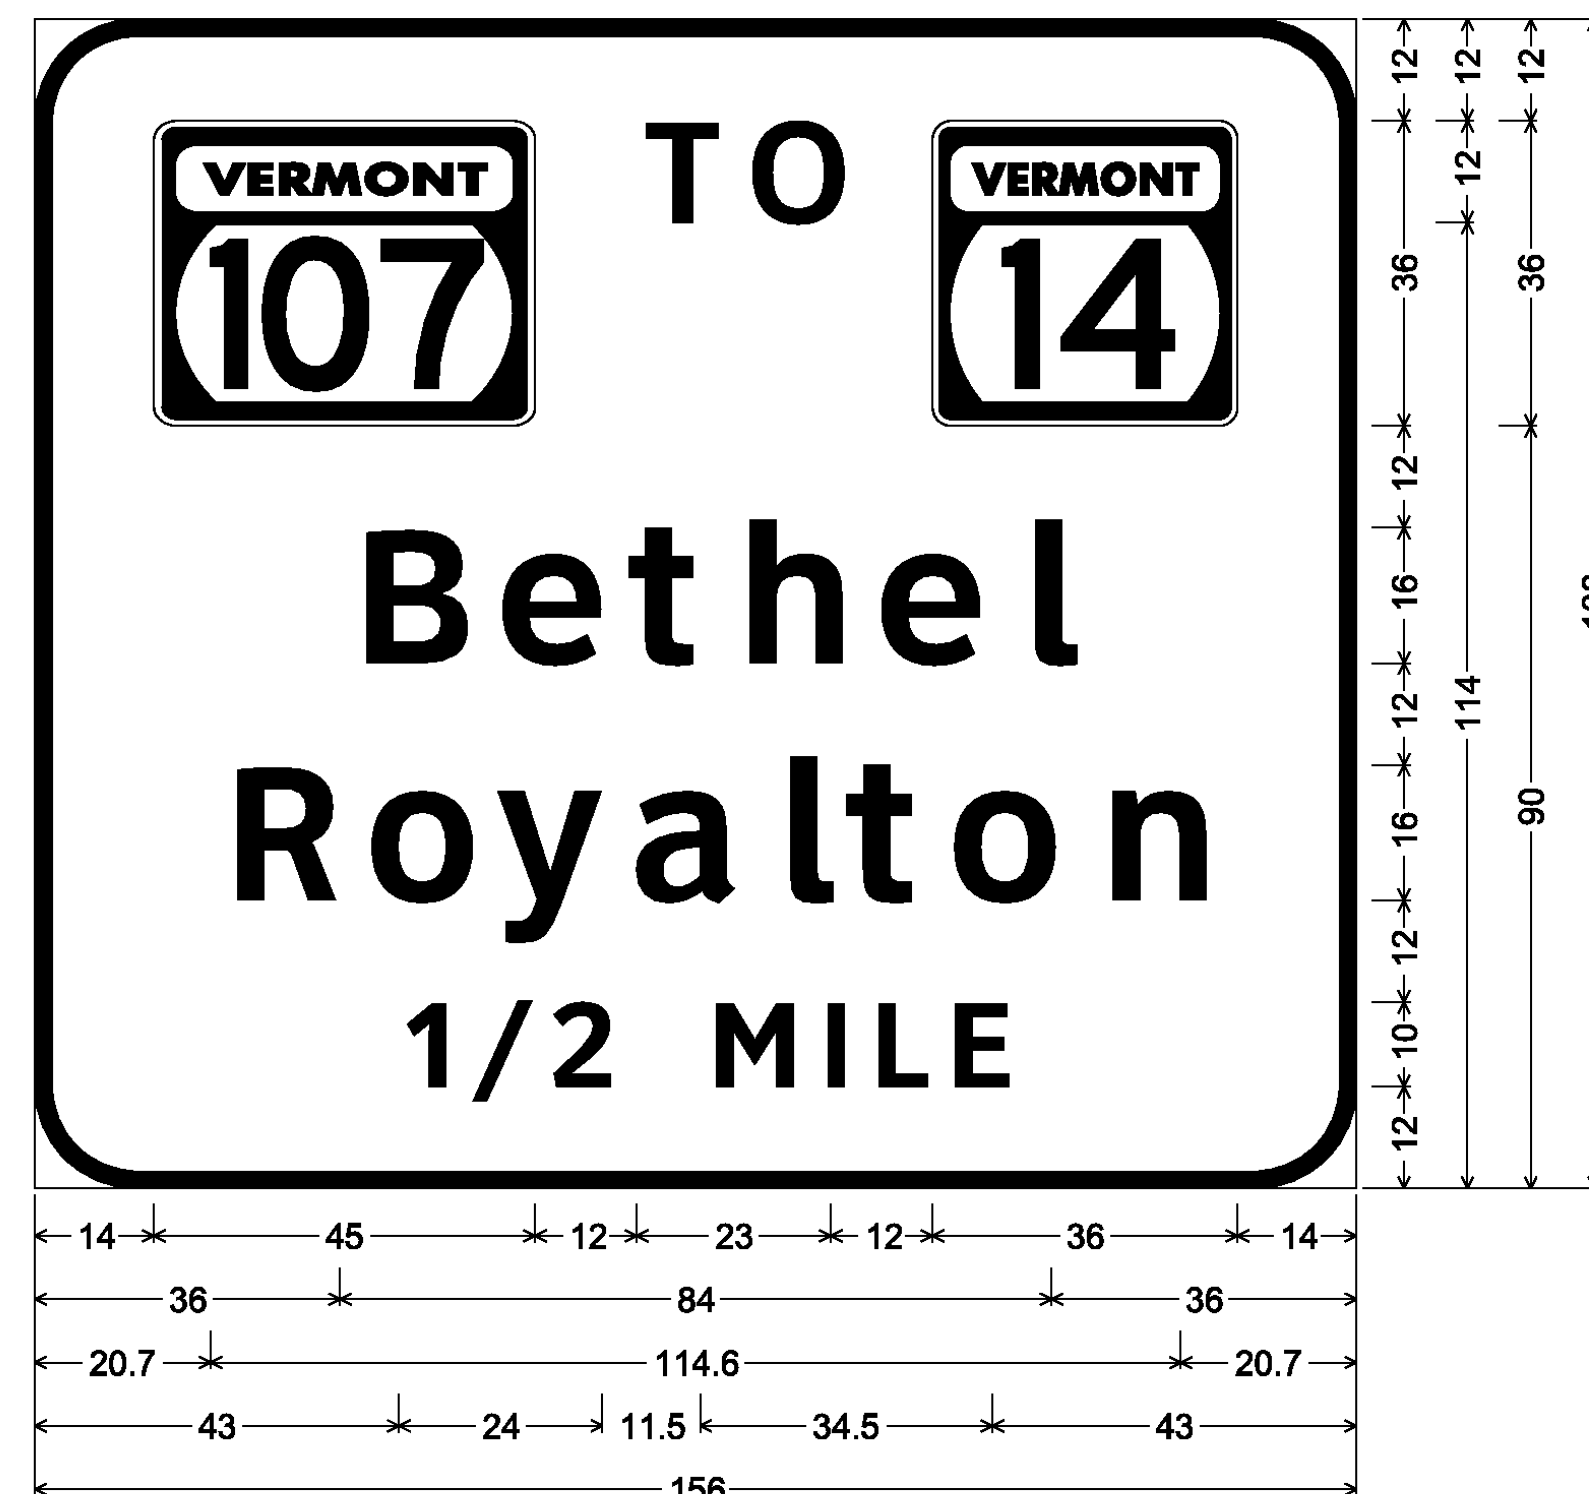


12.0" Radius, 2.0" Border, White on Green;  
 VT107; [TO] ClearviewHwy-5-W; 14; [Bethel] ClearviewHwy-5-W;  
 [Royalton] ClearviewHwy-5-W; [1/2 MILE] ClearviewHwy-5-W;

MM 21.920 NB

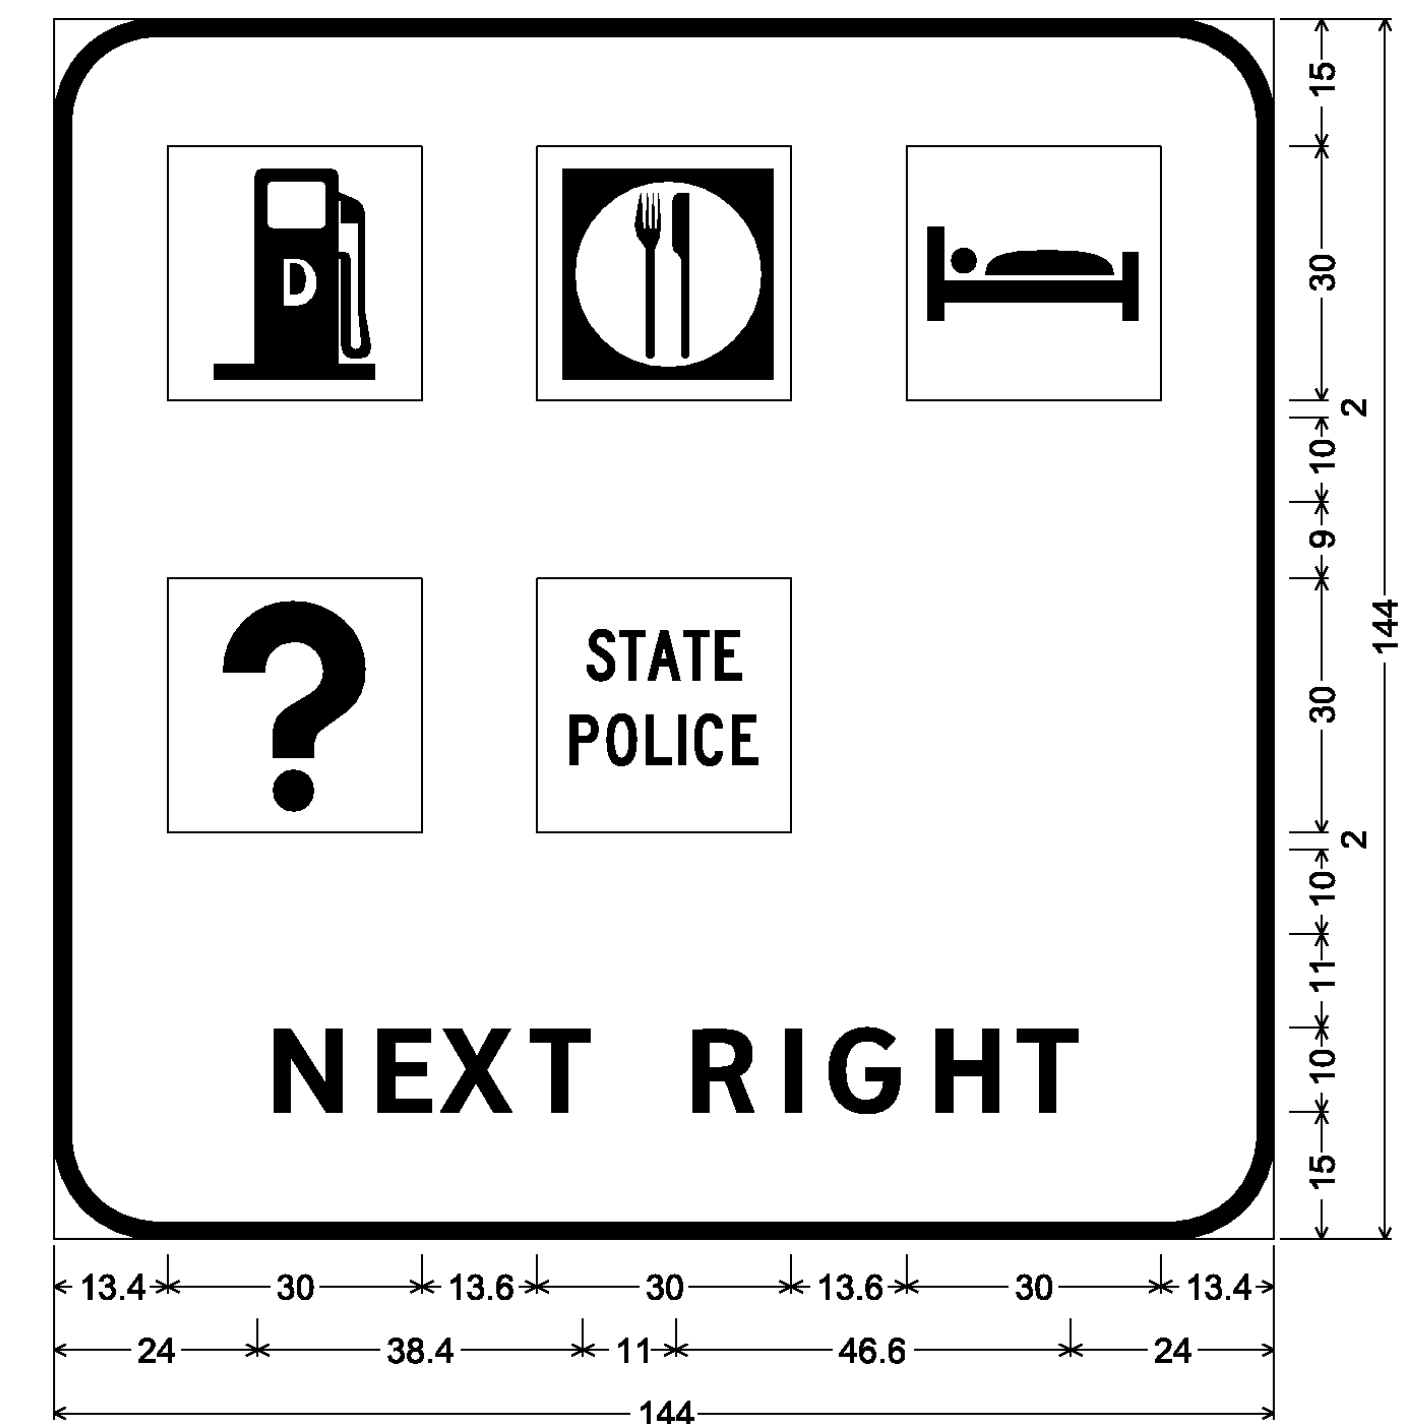


12.0" Radius, 2.0" Border, White on Blue;  
 [NEXT RIGHT] ClearviewHwy-5-W;

MM 22.135 NB

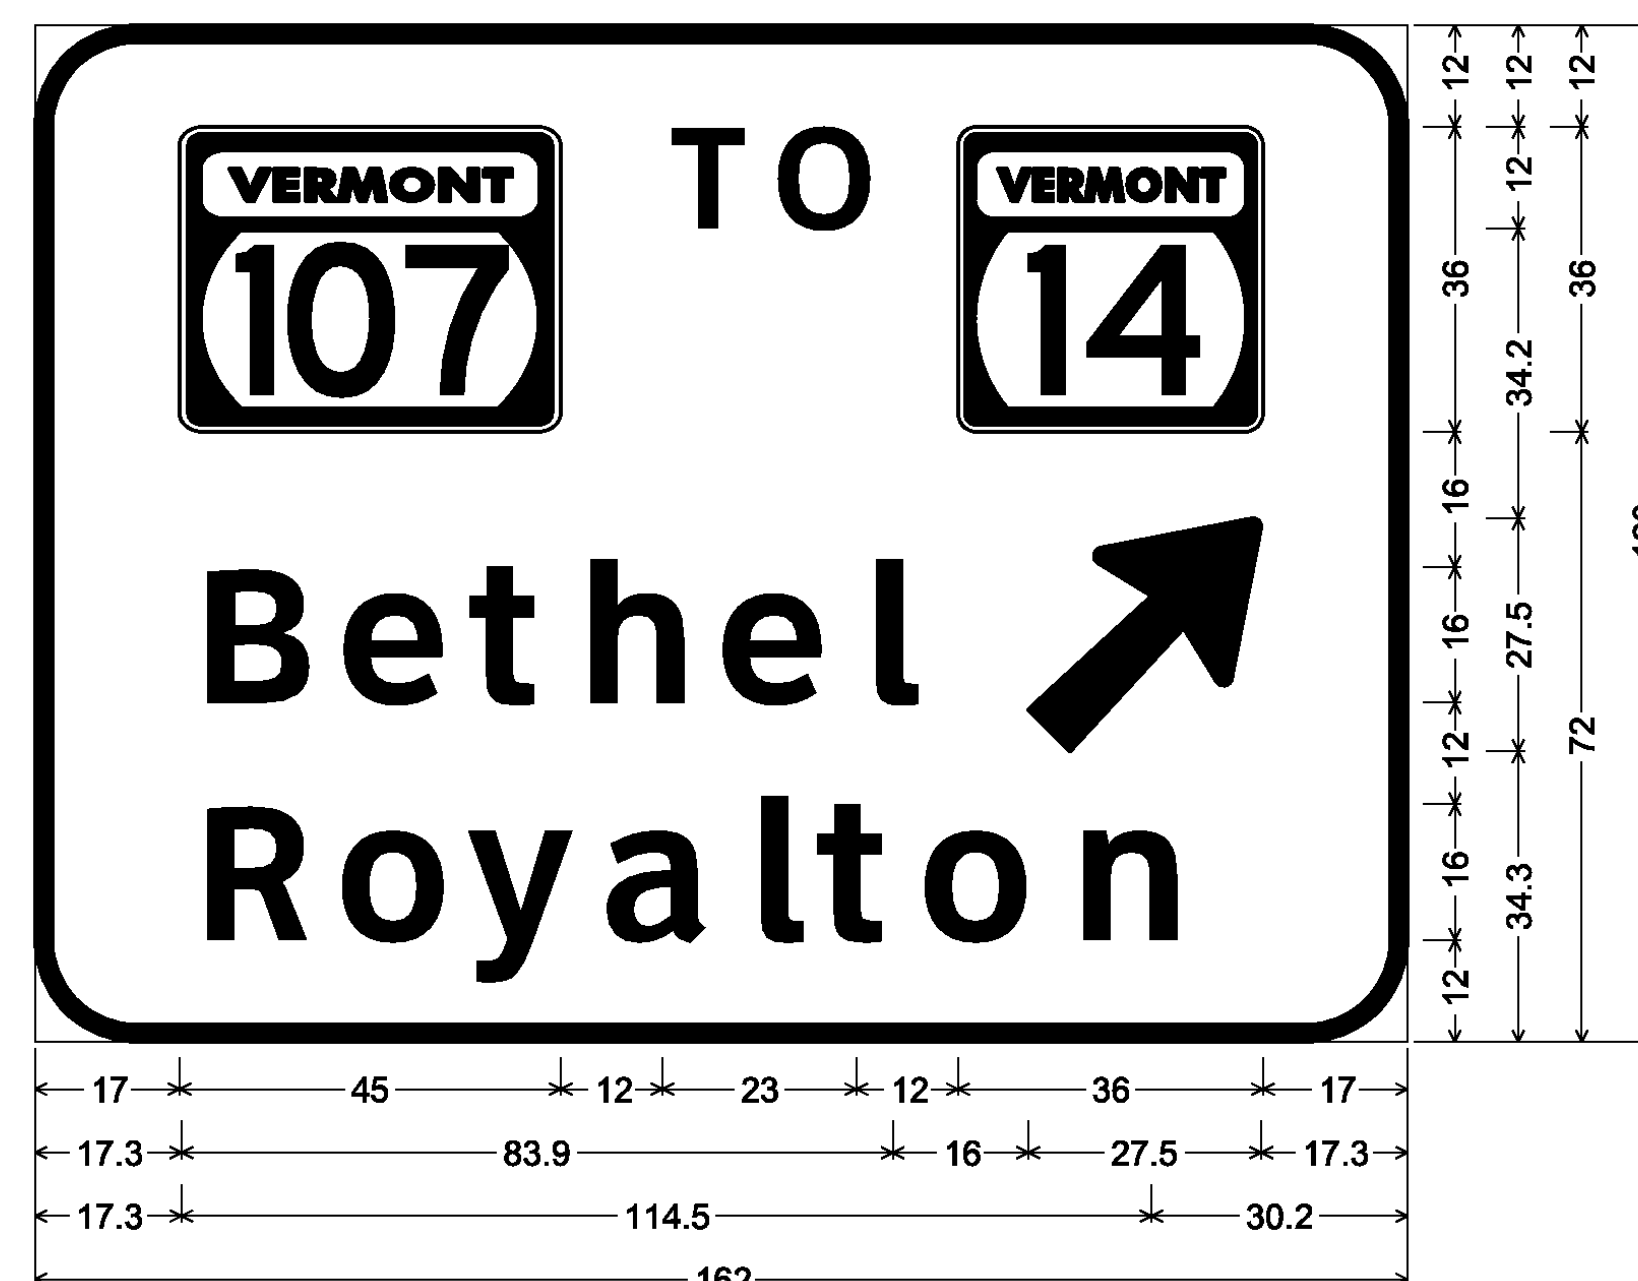


12.0" Radius, 2.0" Border, White on Green;  
 VT107; [TO] ClearviewHwy-5-W; 14; [Bethel] ClearviewHwy-5-W;  
 Arrow 160 - 35.0" 45°; [Royalton] ClearviewHwy-5-W;

MM 23.210 NB

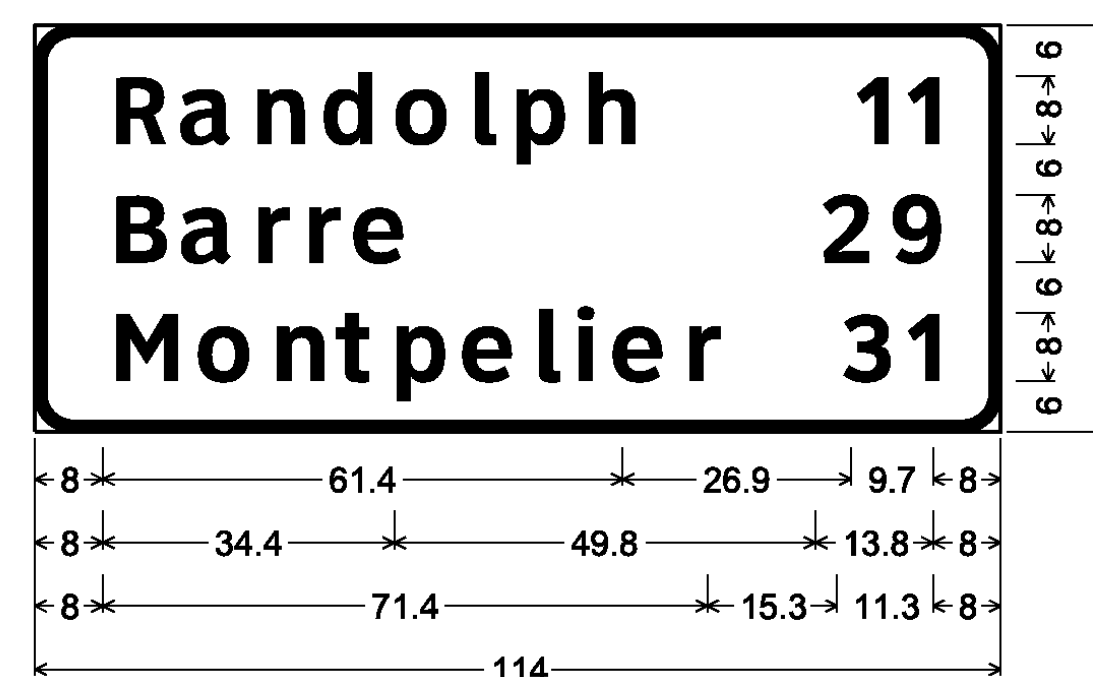

4.5" Radius, 1.3" Border, White on Green;  
 [Randolph] ClearviewHwy-5-W;  
 [Barre] ClearviewHwy-5-W;  
 [Montpelier] ClearviewHwy-5-W;  
 [11] ClearviewHwy-5-W; [29] ClearviewHwy-5-W;  
 [31] ClearviewHwy-5-W;

MM 27.040 NB  
 MM 38.150 SB

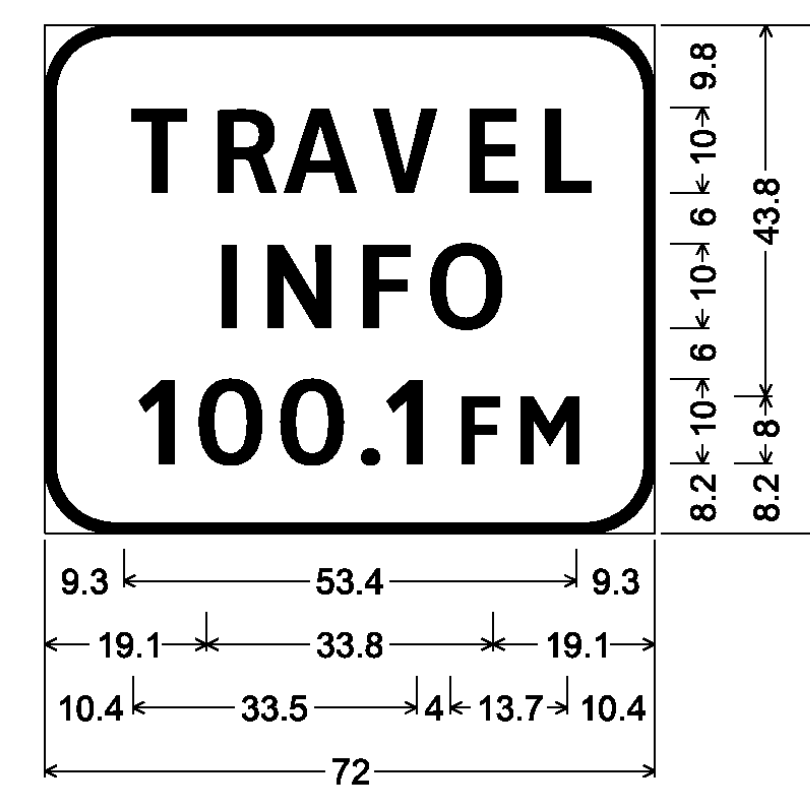

8.0" Radius, 1.3" Border, White on Blue;  
 [TRAVEL] ClearviewHwy-4-W;  
 [INFO] ClearviewHwy-4-W;  
 [100.1] ClearviewHwy-4-W 70% spacing;  
 [FM] ClearviewHwy-4-W;

GENERAL SIGN DETAIL NOTES

1. THE NOTE BELOW EACH SIGN DETAIL INCLUDES THE CORNER RADIUS, BORDER WIDTH, TEXT COLOR, BACKGROUND COLOR AND TEXT SERIES TO BE USED.
2. COLORS: UNLESS NOTED OTHERWISE, WHITE ON GREEN AND WHITE ON BLUE SIGNIFIES WHITE ASTM TYPE IX RETROREFLECTIVE LEGEND AND BORDER ON GREEN OR BLUE ASTM TYPE III RETROREFLECTIVE BACKGROUND. BLACK ON YELLOW AND BLACK ON WHITE SIGNIFIES BLACK LEGEND AND BORDER ON YELLOW OR WHITE ASTM TYPE III (MINIMUM) RETROREFLECTIVE BACKGROUND. ALL COLORS SHALL CONFORM WITH THE COLORS ADOPTED BY AASHTO AND APPROVED BY FHWA.
3. TEXT LAYOUT DIMENSIONS ARE BASED ON THE CLEARVIEW FONT OR THE STANDARD ALPHABETS SPACING CHARTS FOUND IN THE MUTCD "STANDARD HIGHWAY SIGNS" PUBLICATION. MINOR VARIATIONS IN TEXT DIMENSIONS ARE ACCEPTABLE BASED ON INDIVIDUAL MANUFACTURER'S LETTER FABRICATION. SIGNIFICANT CHANGES WHICH AFFECT SIGN APPEARANCE SHALL BE BROUGHT TO THE ATTENTION OF THE VTRANS' TRAFFIC AND SAFETY SECTION BEFORE FABRICATION.
4. UNLESS NOTED OTHERWISE, THE DESIGN/DIMENSIONS FOR SYMBOLS SHOWN ON THESE SIGNS CAN BE FOUND IN VTRANS' STANDARDS OR IN THE STANDARD HIGHWAY SIGNS PUBLICATION.
5. FOR GUIDE SIGN ROUTE MARKER DETAILS SEE STD'S E-135, E-136A AND E-136B.
6. THE NOTE BELOW EACH GUIDE SIGN DETAIL SPECIFIES APPROPRIATE ARROW LENGTHS WHEN APPLICABLE. FOR ARROW DIMENSIONS REFER TO GUIDE SIGN ARROW DETAILS IN THE STANDARD HIGHWAY SIGNS PUBLICATION.

SIGN DETAIL SHEET 1

PROJECT NAME: ROYALTON-MIDDLESEX

PROJECT NUMBER: IMG SIGN(19)

FILE NAME: z09a020signdet.dgn

PLOT DATE: 8/12/2009

PROJECT LEADER: CRB

DRAWN BY: JBZ

DESIGNED BY: JBZ

CHECKED BY: BDB

CLD REF. NO.: 09-0106

SHEET 132 OF 163