


DIMENSIONS FOR CRITICAL OFFSETS OR CLEARANCES SHOWN FOR CONVENIENCE, REFER TO STANDARD SHEET E-120 FOR PLACEMENT GUIDELINES.

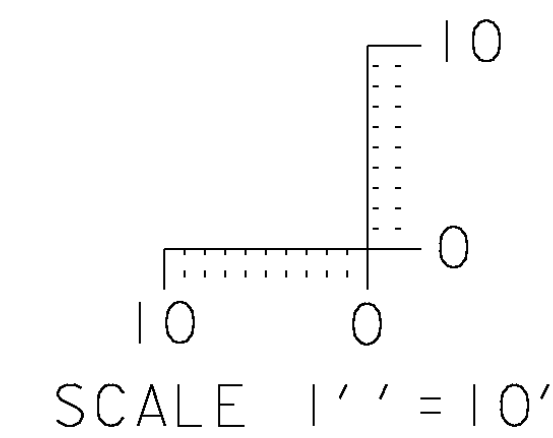

CROSS SECTION SHEET 3

PROJECT NAME: ROYALTON-MIDDLESEX	PLOT DATE: 8/12/2009
PROJECT NUMBER: IMG SIGN(19)	DRAWN BY: JBZ
FILE NAME: z09a020xs.dgn	CHECKED BY: BDB
PROJECT LEADER: CRB	SHEET 149 OF 163
DESIGNED BY: JBZ	
CLD REF. NO.: 09-0106	