



**M.M. 59.550 NB**

STEEL BEAM GUARDRAIL

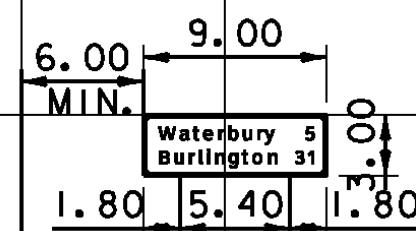

LT. POST - 10.6 FT  
 MID POST -  
 MID POST -  
 RT. POST - 11.4 FT

DIMENSIONS FOR CRITICAL OFFSETS OR CLEARANCES SHOWN FOR CONVENIENCE, REFER TO STANDARD SHEET E-120 FOR PLACEMENT GUIDELINES.

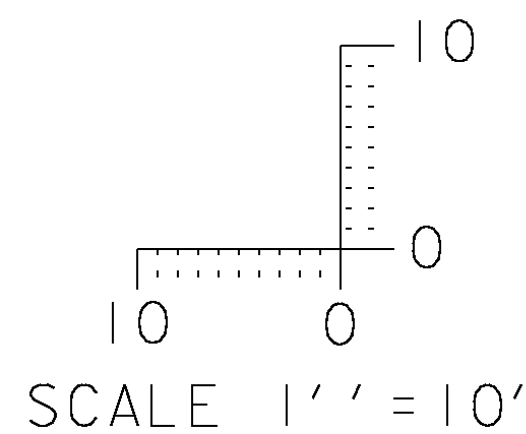

**CROSS SECTION SHEET 4**

PROJECT NAME: ROYALTON-MIDDLESEX

PROJECT NUMBER: IMG SIGN(19)

FILE NAME: z09a020xs.dgn

PROJECT LEADER: CRB

DESIGNED BY: BDB

CLD REF. NO.: 09-0106

PLOT DATE: 8/12/2009

DRAWN BY: JBZ

CHECKED BY: BDB

SHEET 150 OF 163