




TYPICAL MAINLINE MARKING PLAN
NOT TO SCALE

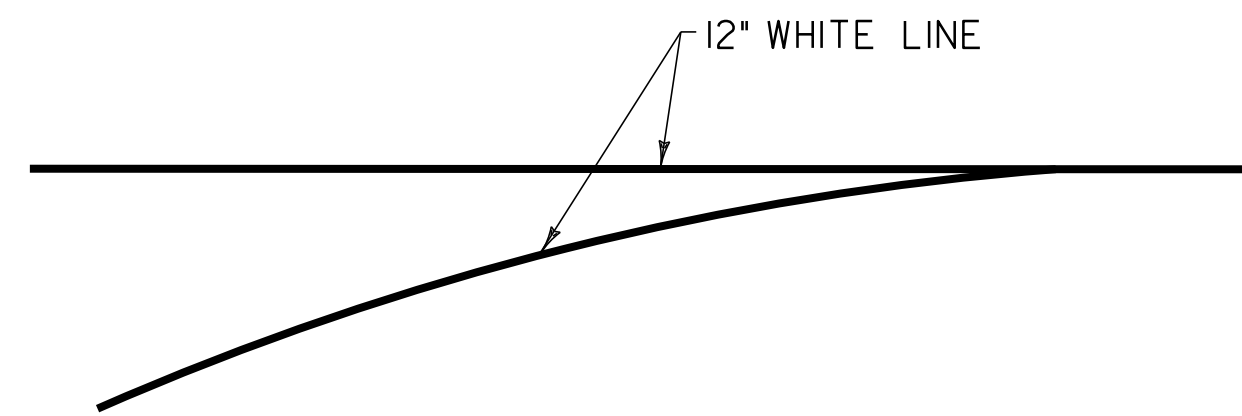


GORE MARKING DETAIL
NOT TO SCALE

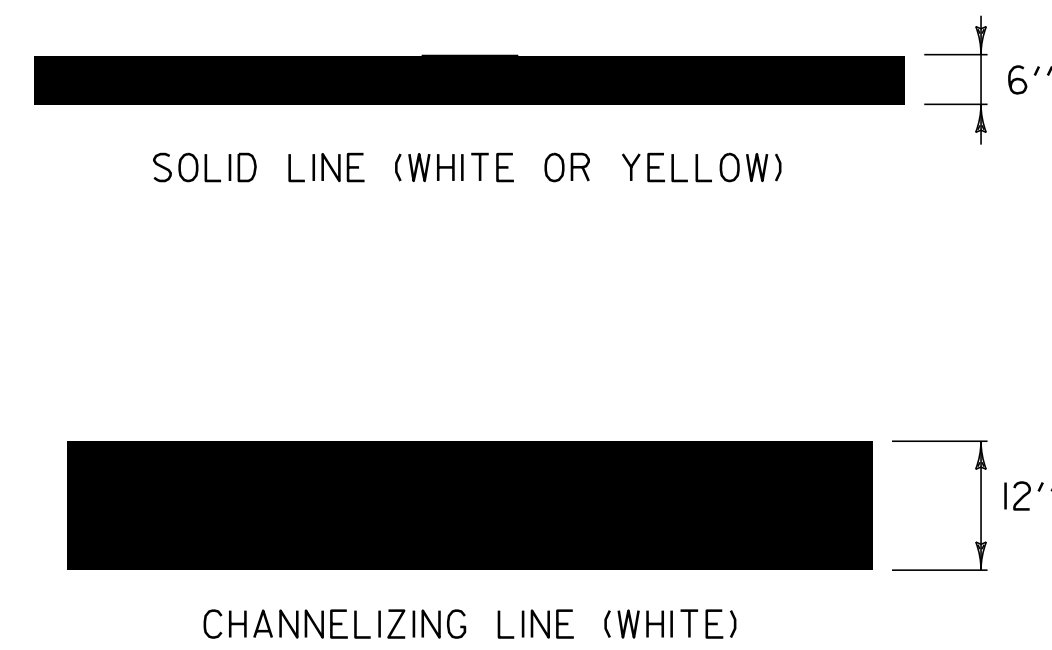

PAVEMENT MARKING LINE DETAILS
NOT TO SCALE

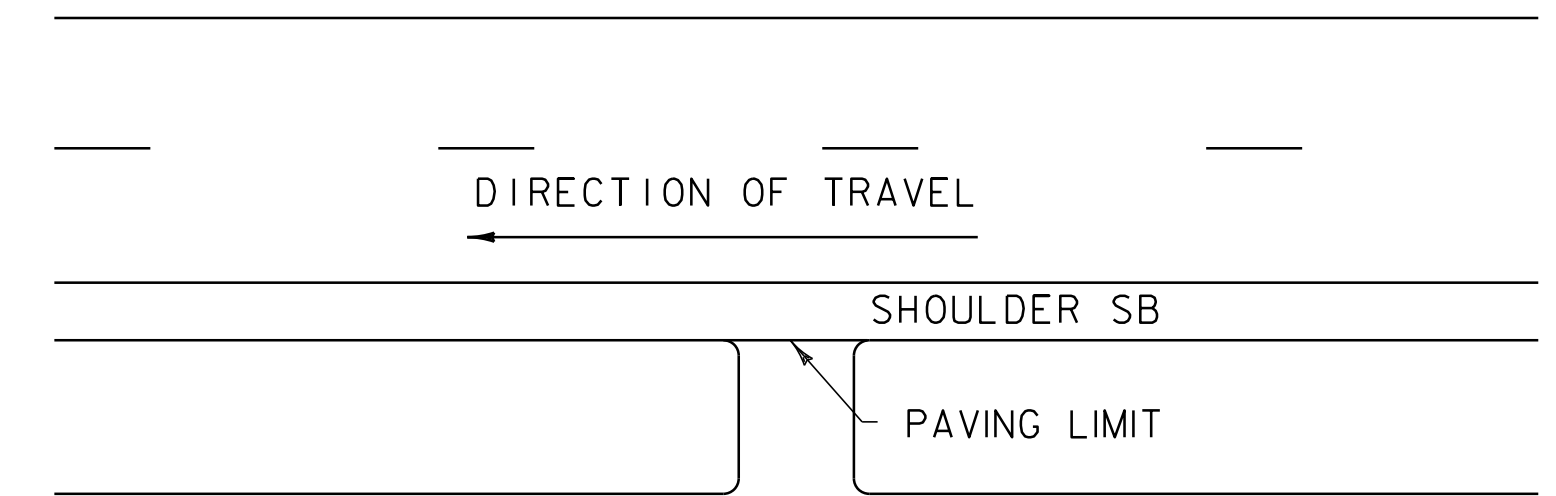

PAVING LIMITS AT U-TURNS
NOT TO SCALE

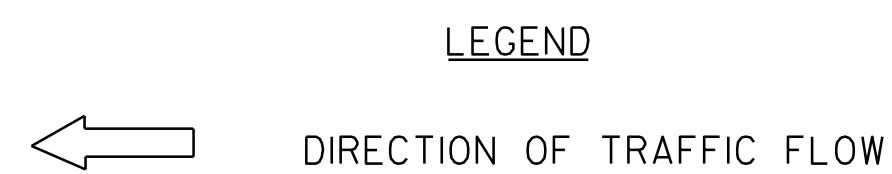

NOTES:

1. TWO (2) APPLICATIONS OF FINAL PAVEMENT MARKINGS WILL BE REQUIRED ON BOTH ALTERNATIVE TREATMENTS. THE FIRST APPLICATION WILL BE IMMEDIATELY FOLLOWING PLACEMENT OF THE SURFACE TREATMENT. THE SECOND AND FINAL APPLICATION WILL BE APPLIED NO SOONER THAN 14 CALENDER DAYS AFTER THE FIRST APPLICATION, AND NO LATER THAN SEPTEMBER 17, 2010.

DETAIL SHEET	PROJECT NAME:	SHEFFIELD - BARTON
	PROJECT NUMBER:	IM SURF (18)
	FILE NAME: p09a044.dgn	PLOT DATE: 04-NOV-2011 6:15
	PROJECT LEADER: MIKE FOWLER	DRAWN BY: WILDER
DESIGNED BY: WILDER	CHECKED BY: PAVT MGMT	
IPARM FILE NAME: p09a044_06.i	SHEET 6 OF 9	