


LEGEND	
	EDGE OF WETLAND
	ORDINARY HIGH WATER
	DIRECTION OF FLOW



I-89 MM 89.636 - SOUTH BURLINGTON

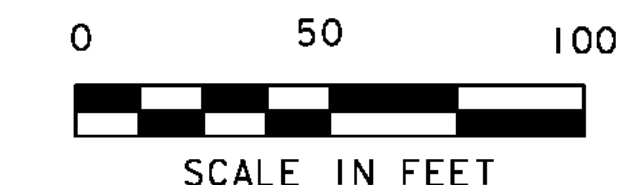

PROJECT NAME: SO. BURLINGTON - COLCHESTER	PLOT DATE: 08-FEB-2011
PROJECT NUMBER: IM CULV (23)	DRAWN BY: M. LOVETT
FILE NAME: z09a046ec02.dgn	CHECKED BY: D. BENOIT
PROJECT LEADER: D. BENOIT	EXISTING CONDITIONS - SO. BURLINGTON 69-1
DESIGNED BY: B. COLBURN	SHEET 11 OF 36