


LEGEND	
	EDGE OF WETLAND
	ORDINARY HIGH WATER
	STONE FILL, TYPE II

- SITE STABILIZATION NOTES:**
1. ALL DISTURBED GRASSED AREAS SHALL BE STABILIZED WITH SEED AND MULCH.
 2. ALL DISTURBED STONE AREAS AND AREAS SHOWN ON THE PLAN SHALL BE STABILIZED WITH STONE FILL, TYPE II.
 3. SLOPES STEEPER THAN 1:3 (VERTICAL:HORIZONTAL) SHALL ALSO USE TEMPORARY EROSION MATTING.
 4. THE RESIDENT ENGINEER SHALL HAVE THE OPTION TO LEAVE THE TEMPORARY ACCESS ROAD IN PLACE AT THE COMPLETION OF THE PROJECT.

I-89 MM 89.636 - SOUTH BURLINGTON

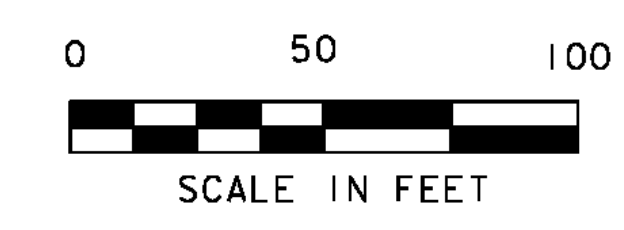

PROJECT NAME: SO. BURLINGTON - COLCHESTER	
PROJECT NUMBER: IM CULV (23)	
FILE NAME: z09a046fc02.dgn	PLOT DATE: 08-FEB-2011
PROJECT LEADER: D. BENOIT	DRAWN BY: M. LOVETT
DESIGNED BY: B. COLBURN	CHECKED BY: D. BENOIT
FINAL CONDITIONS - SOUTH BURLINGTON 69-1 SHEET 13 OF 36	