


I-89 MM 95.183 - COLCHESTER



GENERAL NOTES:

1. THE CONTRACTOR WILL BE RESPONSIBLE FOR PROVIDING TEMPORARY ACCESS TO THE CULVERT ENDS. ALL RESULTING DISTURBED EARTH SHALL BE STABILIZED AND RESTORED UPON COMPLETION OF CONSTRUCTION. PAYMENT SHALL BE MADE UNDER CONTRACT ITEM 900.645 - SPECIAL PROVISION (TEMPORARY ACCESS ROAD AND STAGING AREAS, CULVERT). ANY CLEARING OF TREES AND STUMPS NECESSARY FOR CONSTRUCTION OF THE TEMPORARY ACCESS ROAD SHALL BE PAID UNDER CONTRACT ITEM 201.10 - CLEARING AND GRUBBING, INCLUDING INDIVIDUAL TREES AND STUMPS.

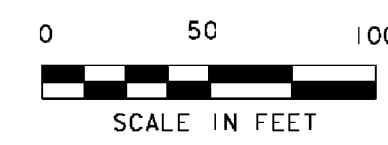

| | |
|-----------------|-----------------------------|
| PROJECT NAME: | SO. BURLINGTON - COLCHESTER |
| PROJECT NUMBER: | IM CULV (23) |
| FILE NAME: | z09a046a00.dgn |
| PROJECT LEADER: | D. BENOIT |
| DESIGNED BY: | B. COLBURN |
| LAYOUT SHEET: | COLCHESTER 75-3 |
| PLOT DATE: | 08-FEB-2011 |
| DRAWN BY: | M. LOVETT |
| CHECKED BY: | D. BENOIT |
| SHEET: | 17 OF 36 |