


LEGEND	
	EDGE OF WETLAND
	ORDINARY HIGH WATER
	DIRECTION OF FLOW



I-89 MM 95.183 - COLCHESTER

PROJECT NAME: SO. BURLINGTON - COLCHESTER	
PROJECT NUMBER: IM CULV (23)	
FILE NAME: z09a046ec01.dgn	PLOT DATE: 08-FEB-2011
PROJECT LEADER: D. BENOIT	DRAWN BY: M. LOVETT
DESIGNED BY: B. COLBURN	CHECKED BY: D. BENOIT
EXISTING CONDITIONS - COLCHESTER 75-3	SHEET 20 OF 36

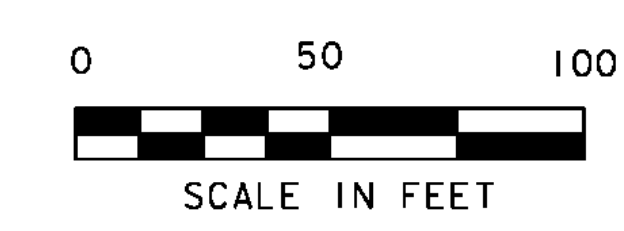