


UNIVERSITY OF CALIFORNIA
 DEPARTMENT OF CIVIL AND ENVIRONMENTAL ENGINEERING
 101 SHALICE DRIVE, BERKELEY, CA 94720-1762

DATE: 10/10/00
 DRAWN BY: [blank]
 CHECKED BY: [blank]
 PROJECT: [blank]

DATE: 10/10/00
 DRAWN BY: [blank]
 CHECKED BY: [blank]
 PROJECT: [blank]

South Bay Bridge, Caltrans (05)

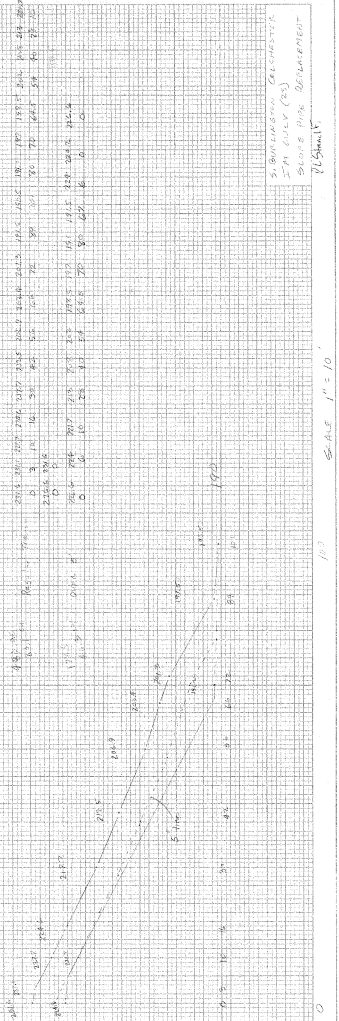

SYMMETRICAL CALCULATIONS
 5" = 10' (10')
 SCALE FOR REFERENCE
 1/8" = 10'

1/8" = 10'

1/8"

0