

# STATE OF VERMONT AGENCY OF TRANSPORTATION



## PROPOSED IMPROVEMENT BRIDGE PROJECT

TOWN OF RICHMOND  
COUNTY OF CHITTENDEN  
BRIDGES NO. 58 N&S

PROJECT LOCATION: BRIDGES NO. 58 N&S LOCATED ON I-89 OVER WINOOSKI RIVER AND JOHNNIE BROOK ROAD (T.H. 16)


PROJECT DESCRIPTION: THIS PROJECT INVOLVES CLEANING AND REPAINTING THE EXISTING STEEL SUPERSTRUCTURE MEMBERS AND MINOR ASSOCIATED WORK.

INDEX OF SHEETS

- 1 TITLE SHEET
- 2 QUANTITY SHEET
- 3 PROJECT NOTES
- 4-6 TRAFFIC CONTROL SHEETS
- 7-9 REFERENCE SHEETS - BRIDGE 58
- 10 REFERENCE SHEET - BRIDGE 58 RIGHT OF WAY


STANDARD SHEETS

- E-100 01/02/04
- E-100A 01/02/04
- E-101 05/30/03
- E-102 06/30/03
- E-102A 05/01/04
- E-103 03/01/04
- E-106 03/01/04
- E-107 06/30/03
- E-107A 06/03/09

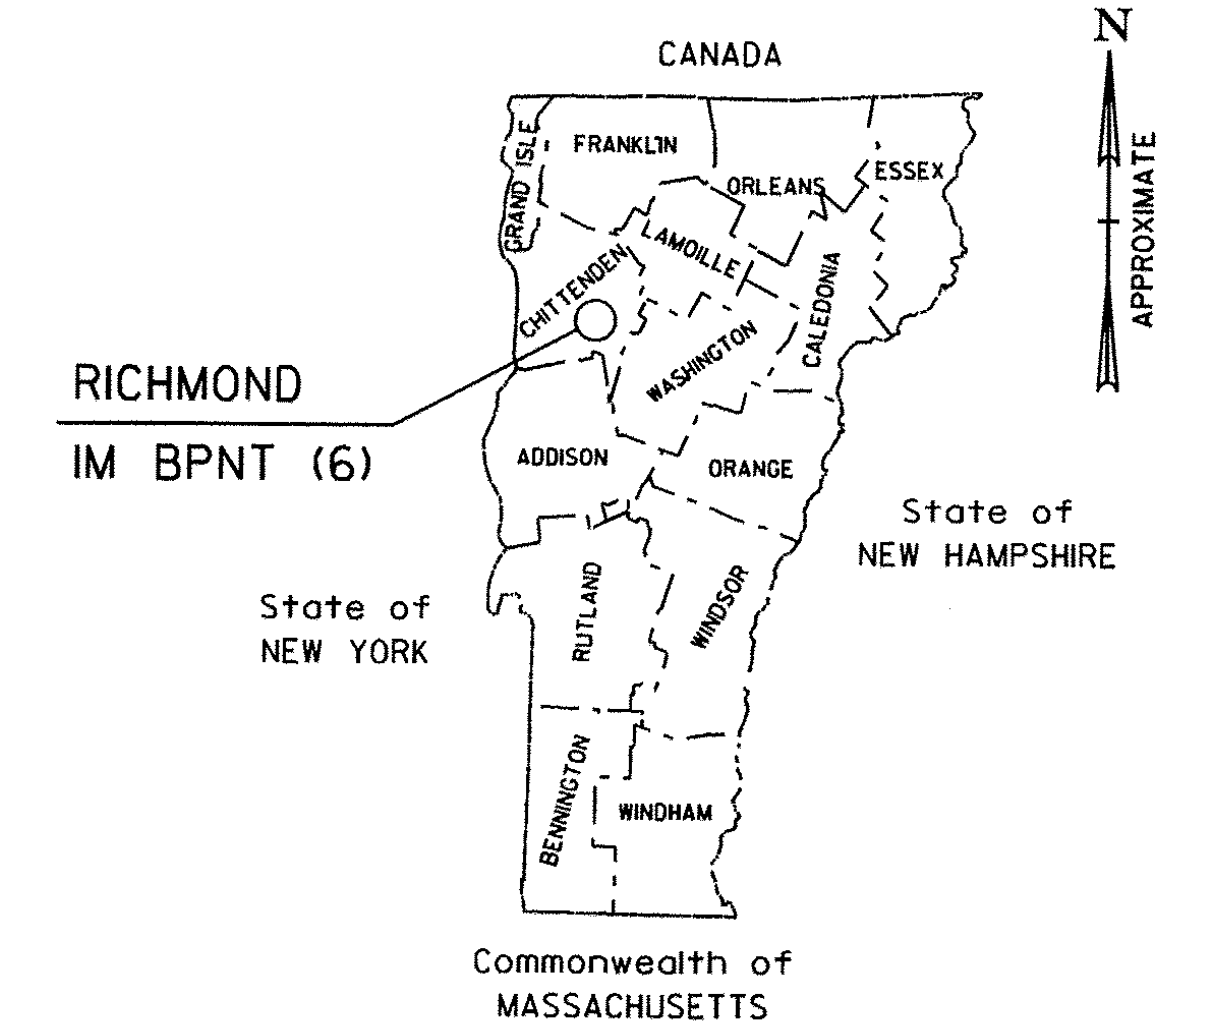

LOCATION MAP  
NOT TO SCALE

RECORD PLANS	
CONTRACTOR:	ATSALIS BROTHERS PAINTING CO.-WARREN, MI
RESIDENT ENGINEER:	SCOTT WHEATLEY
CONSTRUCTION BEGAN:	JULY 13, 2010
CONSTRUCTION COMPLETE:	MARCH 26, 2012
RECORD PLANS BY:	SCOTT WHEATLEY
I HEREBY CERTIFY THAT ALL THE CONSTRUCTION REQUIRED BY THIS SET OF DRAWINGS HAS BEEN ACCOMPLISHED AS INDICATED HEREIN.	
BY	<i>Scott Wheatley</i> RESIDENT ENGINEER
DATE	July 31, 2012
NOTE: Any further information concerning final quantities, amounts or other details relative to this project may be found at Central Files in the electronic archives.	

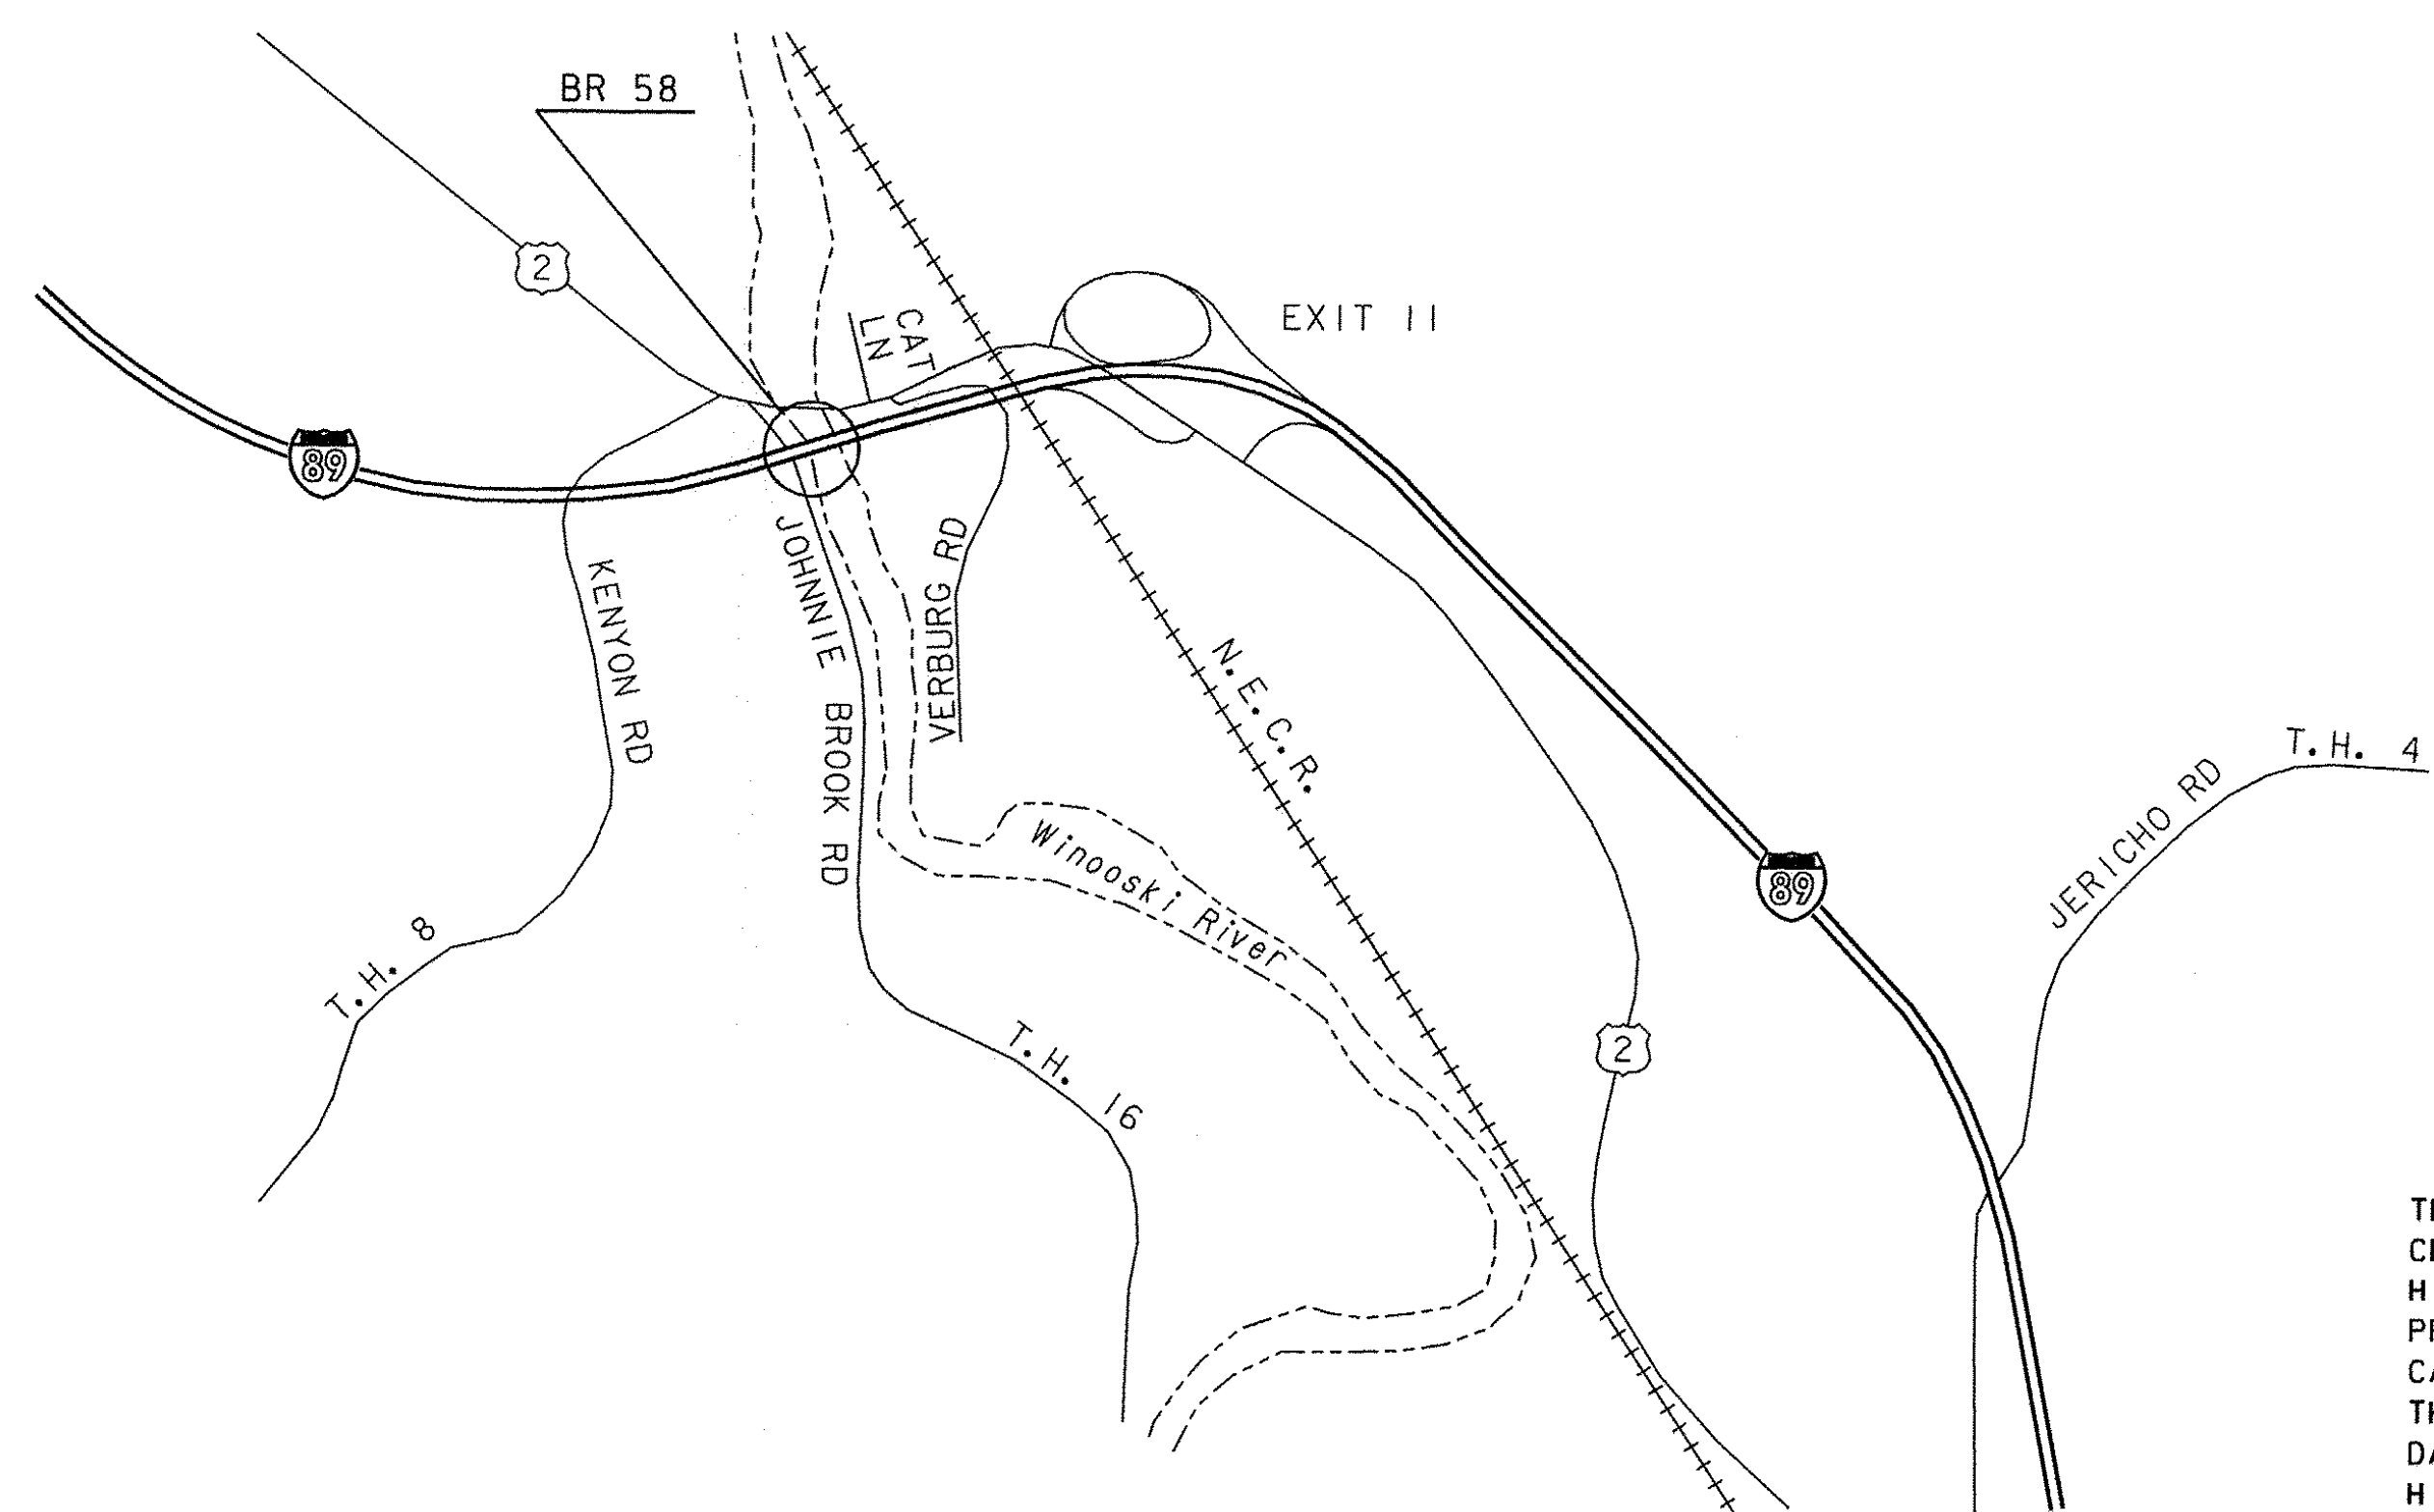


PLAN  
NOT TO SCALE

CONVENTIONAL SYMBOLS	
COUNTY LINE	
TOWN LINE	
LIMITS OF ACCESS	
POINT OF ACCESS	
FENCE LINE	
STONE WALL	
TRAVELED WAY	
GUARD RAIL	
RAILROAD	
SURVEY LINE	
CULVERT	
POWER POLE	
TELEPHONE POLE	
TREES	
CONTROL OF ACCESS	
R.O.W. LINE	
PROPERTY LINE	
R.O.W. TAKING LINE	
SLOPE RIGHTS	
CLEAR ZONE	
TOP OF CUT	
TOE OF SLOPE	

DATUM	
VERTICAL	N/A
HORIZONTAL	N/A

THESE PLANS ARE SUBJECT TO SUCH ENGINEERING CHANGES AS MAY BE REQUIRED BY THE FEDERAL HIGHWAY ADMINISTRATION OR THE DIRECTOR OF PROGRAM DEVELOPMENT. CONSTRUCTION IS TO BE CARRIED ON IN ACCORDANCE WITH THESE PLANS AND THE STANDARD SPECIFICATIONS FOR CONSTRUCTION DATED 2006, AS APPROVED BY THE FEDERAL HIGHWAY ADMINISTRATION ON JUNE 15, 2006 FOR USE ON THIS PROJECT, INCLUDING ALL SUBSEQUENT REVISIONS AND SUCH REVISED SPECIFICATIONS AND SPECIAL PROVISIONS AS ARE INCORPORATED IN THESE PLANS.

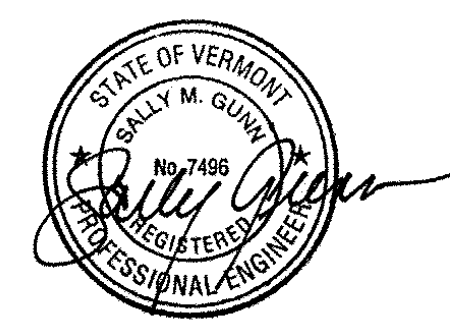

DIRECTOR OF PROGRAM DEVELOPMENT	
APPROVED <i>John H. Weaver</i>	DATE 7/27/09
PROJECT MANAGER : JOHN H. WEAVER, P.E.	
PROJECT NAME : RICHMOND	
PROJECT NUMBER : IM BPNT (6)	
SHEET 1 OF 10 SHEETS	

**VHB Vanasse Hangen Brustlin, Inc.**