


GENERAL NOTES:
 Floor slab to be concrete class B 7 1/2" thick, dopped as shown at beam haunch, surface to be screeded, floated and broomed. Partial parabolic crown, as per detail, to be obtained by stepping.
 DEPTH OF STRINGER AND GIRDER HAUNCHES TO BE DETERMINED AFTER STEEL IS ERECTED AND PROFILE OF TOP STEEL IS TAKEN.

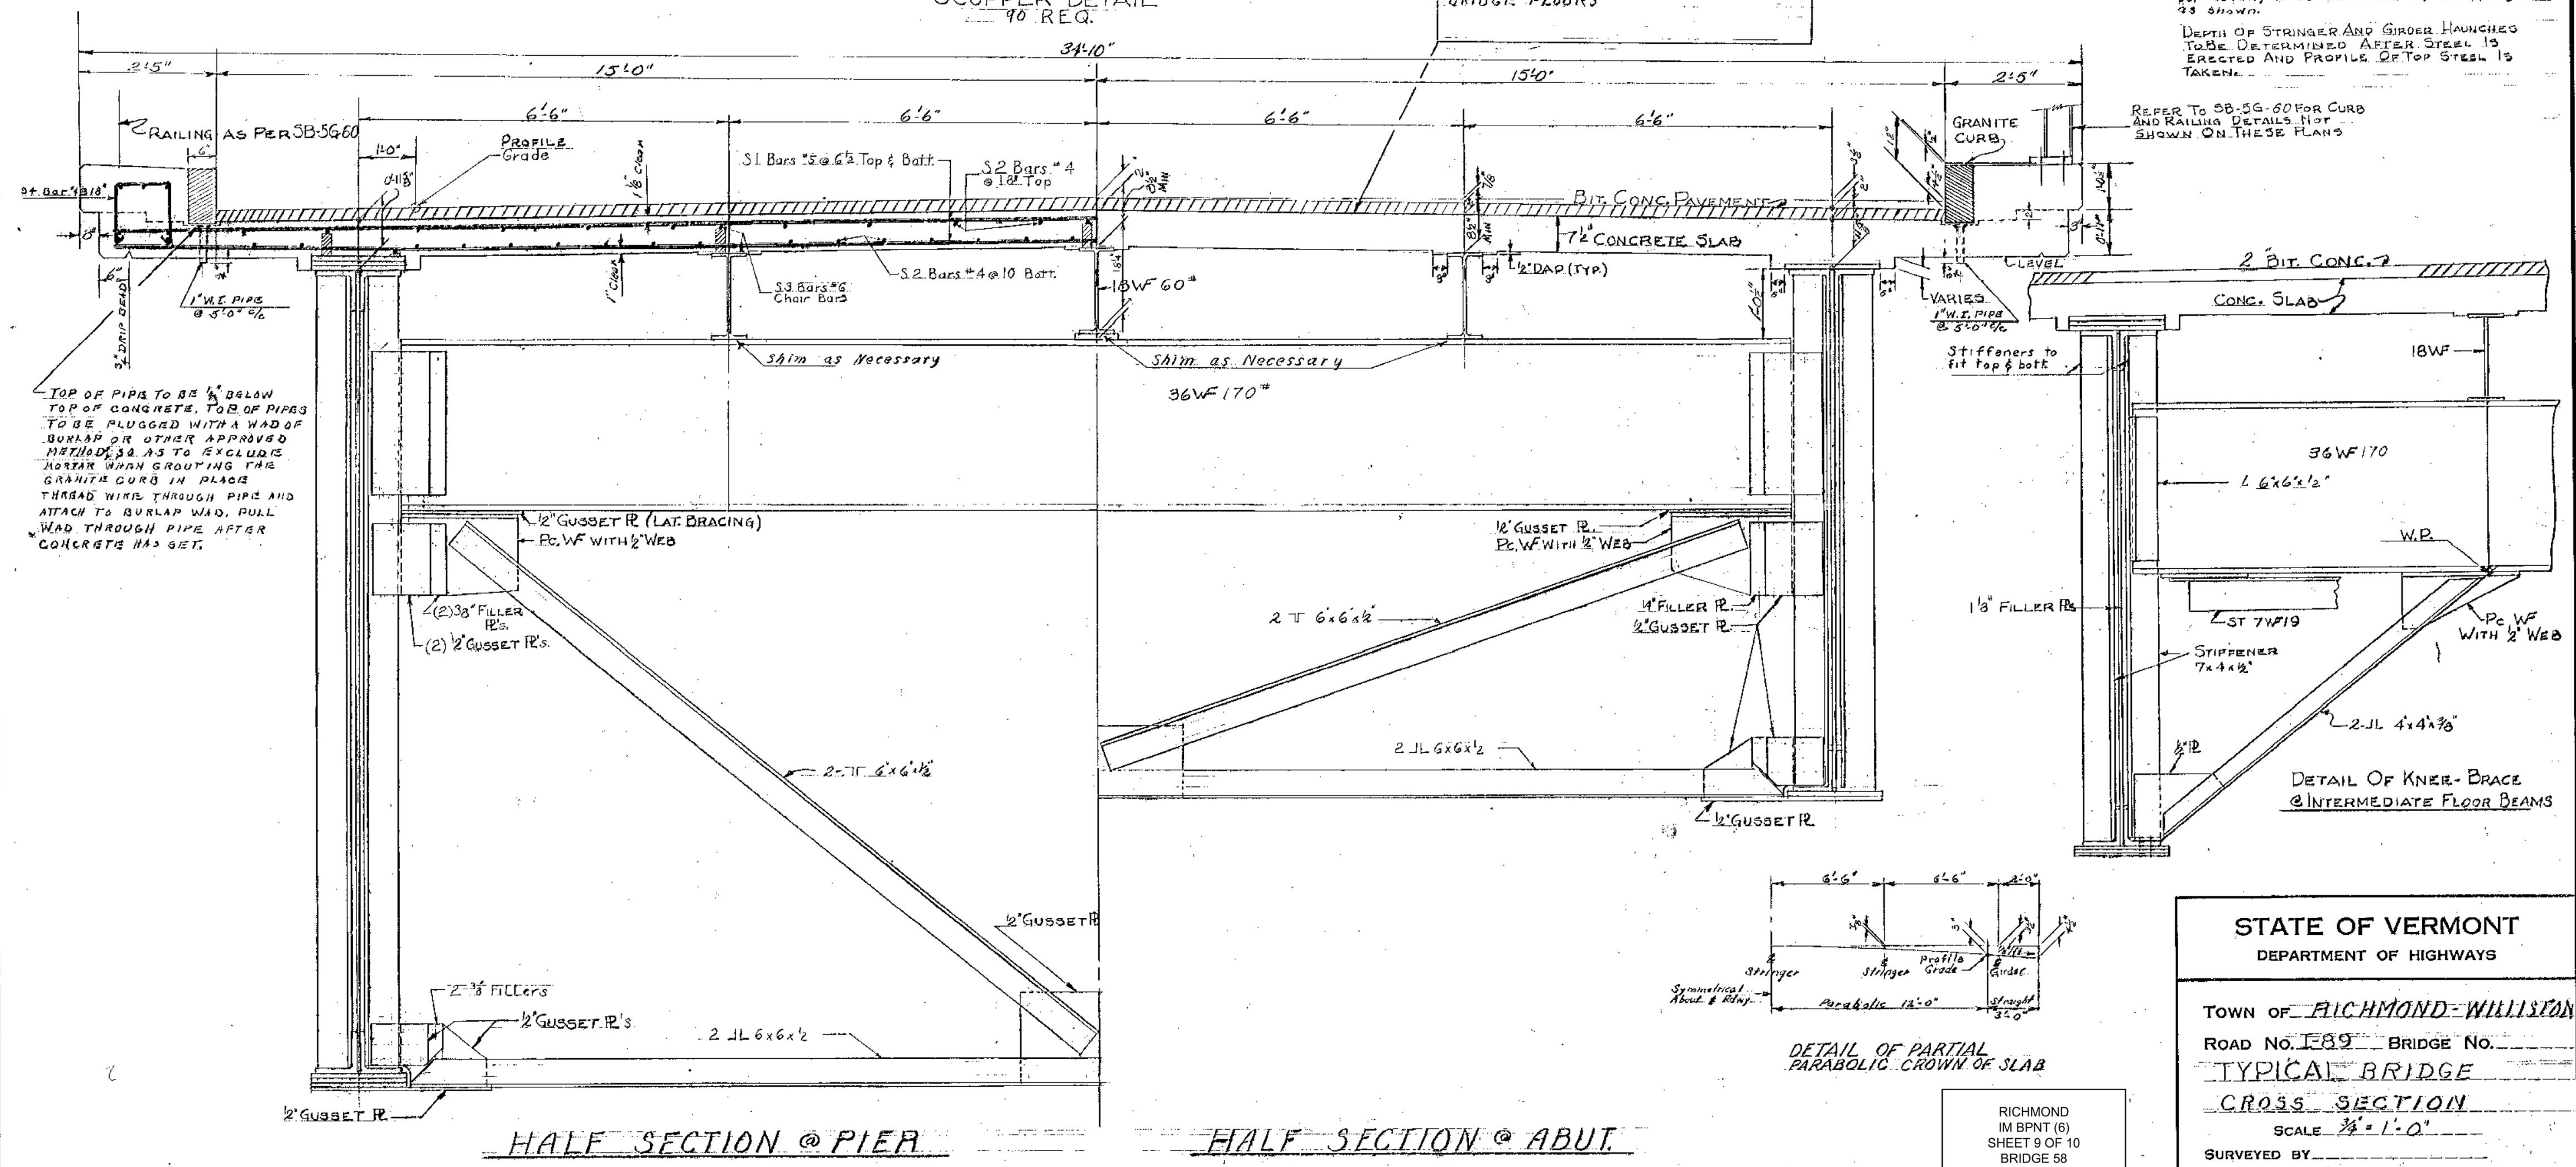

TOP OF PIPE TO BE 1/4" BELOW TOP OF CONCRETE. TOP OF PIPES TO BE PLUGGED WITH A WAD OF BURLAP OR OTHER APPROVED METHOD, AS TO EXCLUDE MOISTURE WHEN GROUTING THE GRANITE CURB IN PLACE. THREAD WIRE THROUGH PIPE AND ATTACH TO BURLAP WAD. PULL WAD THROUGH PIPE AFTER CONCRETE HAS SET.

REFER TO SB-56-60 FOR CURB AND RAILING DETAILS NOT SHOWN ON THESE PLANS

STATE OF VERMONT
 DEPARTMENT OF HIGHWAYS

TOWN OF RICHMOND-WILLISDON
 ROAD NO. 189 BRIDGE NO. _____
 TYPICAL BRIDGE
 CROSS SECTION
 SCALE 3/4" = 1'-0"

SURVEYED BY _____
 DRAWN BY E.A.B. CHECKED BY W.M.S.
 PROJECT NO. I-89-2 (9)
 SHEET 42 OF 118 - Cont. #1

RICHMOND
 IM BPNT (6)
 SHEET 9 OF 10
 BRIDGE 58
 FOR REFERENCE ONLY