

INDEX OF SHEETS
SEE SHEET 2

BERLIN - WATERBURY IM SURF (20)
SEE SHEET 5 FOR ADDITIONAL
PROJECT INFORMATION



MONTPELIER IM MEMB (23)
SEE SHEET 30 FOR ADDITIONAL
PROJECT INFORMATION

STATE OF VERMONT AGENCY OF TRANSPORTATION



PROPOSED IMPROVEMENT TOWNS OF BERLIN, MONTPELIER, MIDDLESEX AND WATERBURY COUNTY OF WASHINGTON INTERSTATE ROUTE 89 (NB & SB)

PROJECT LOCATION
BERLIN - WATERBURY IM SURF (20)
MONTPELIER IM MEMB (23)

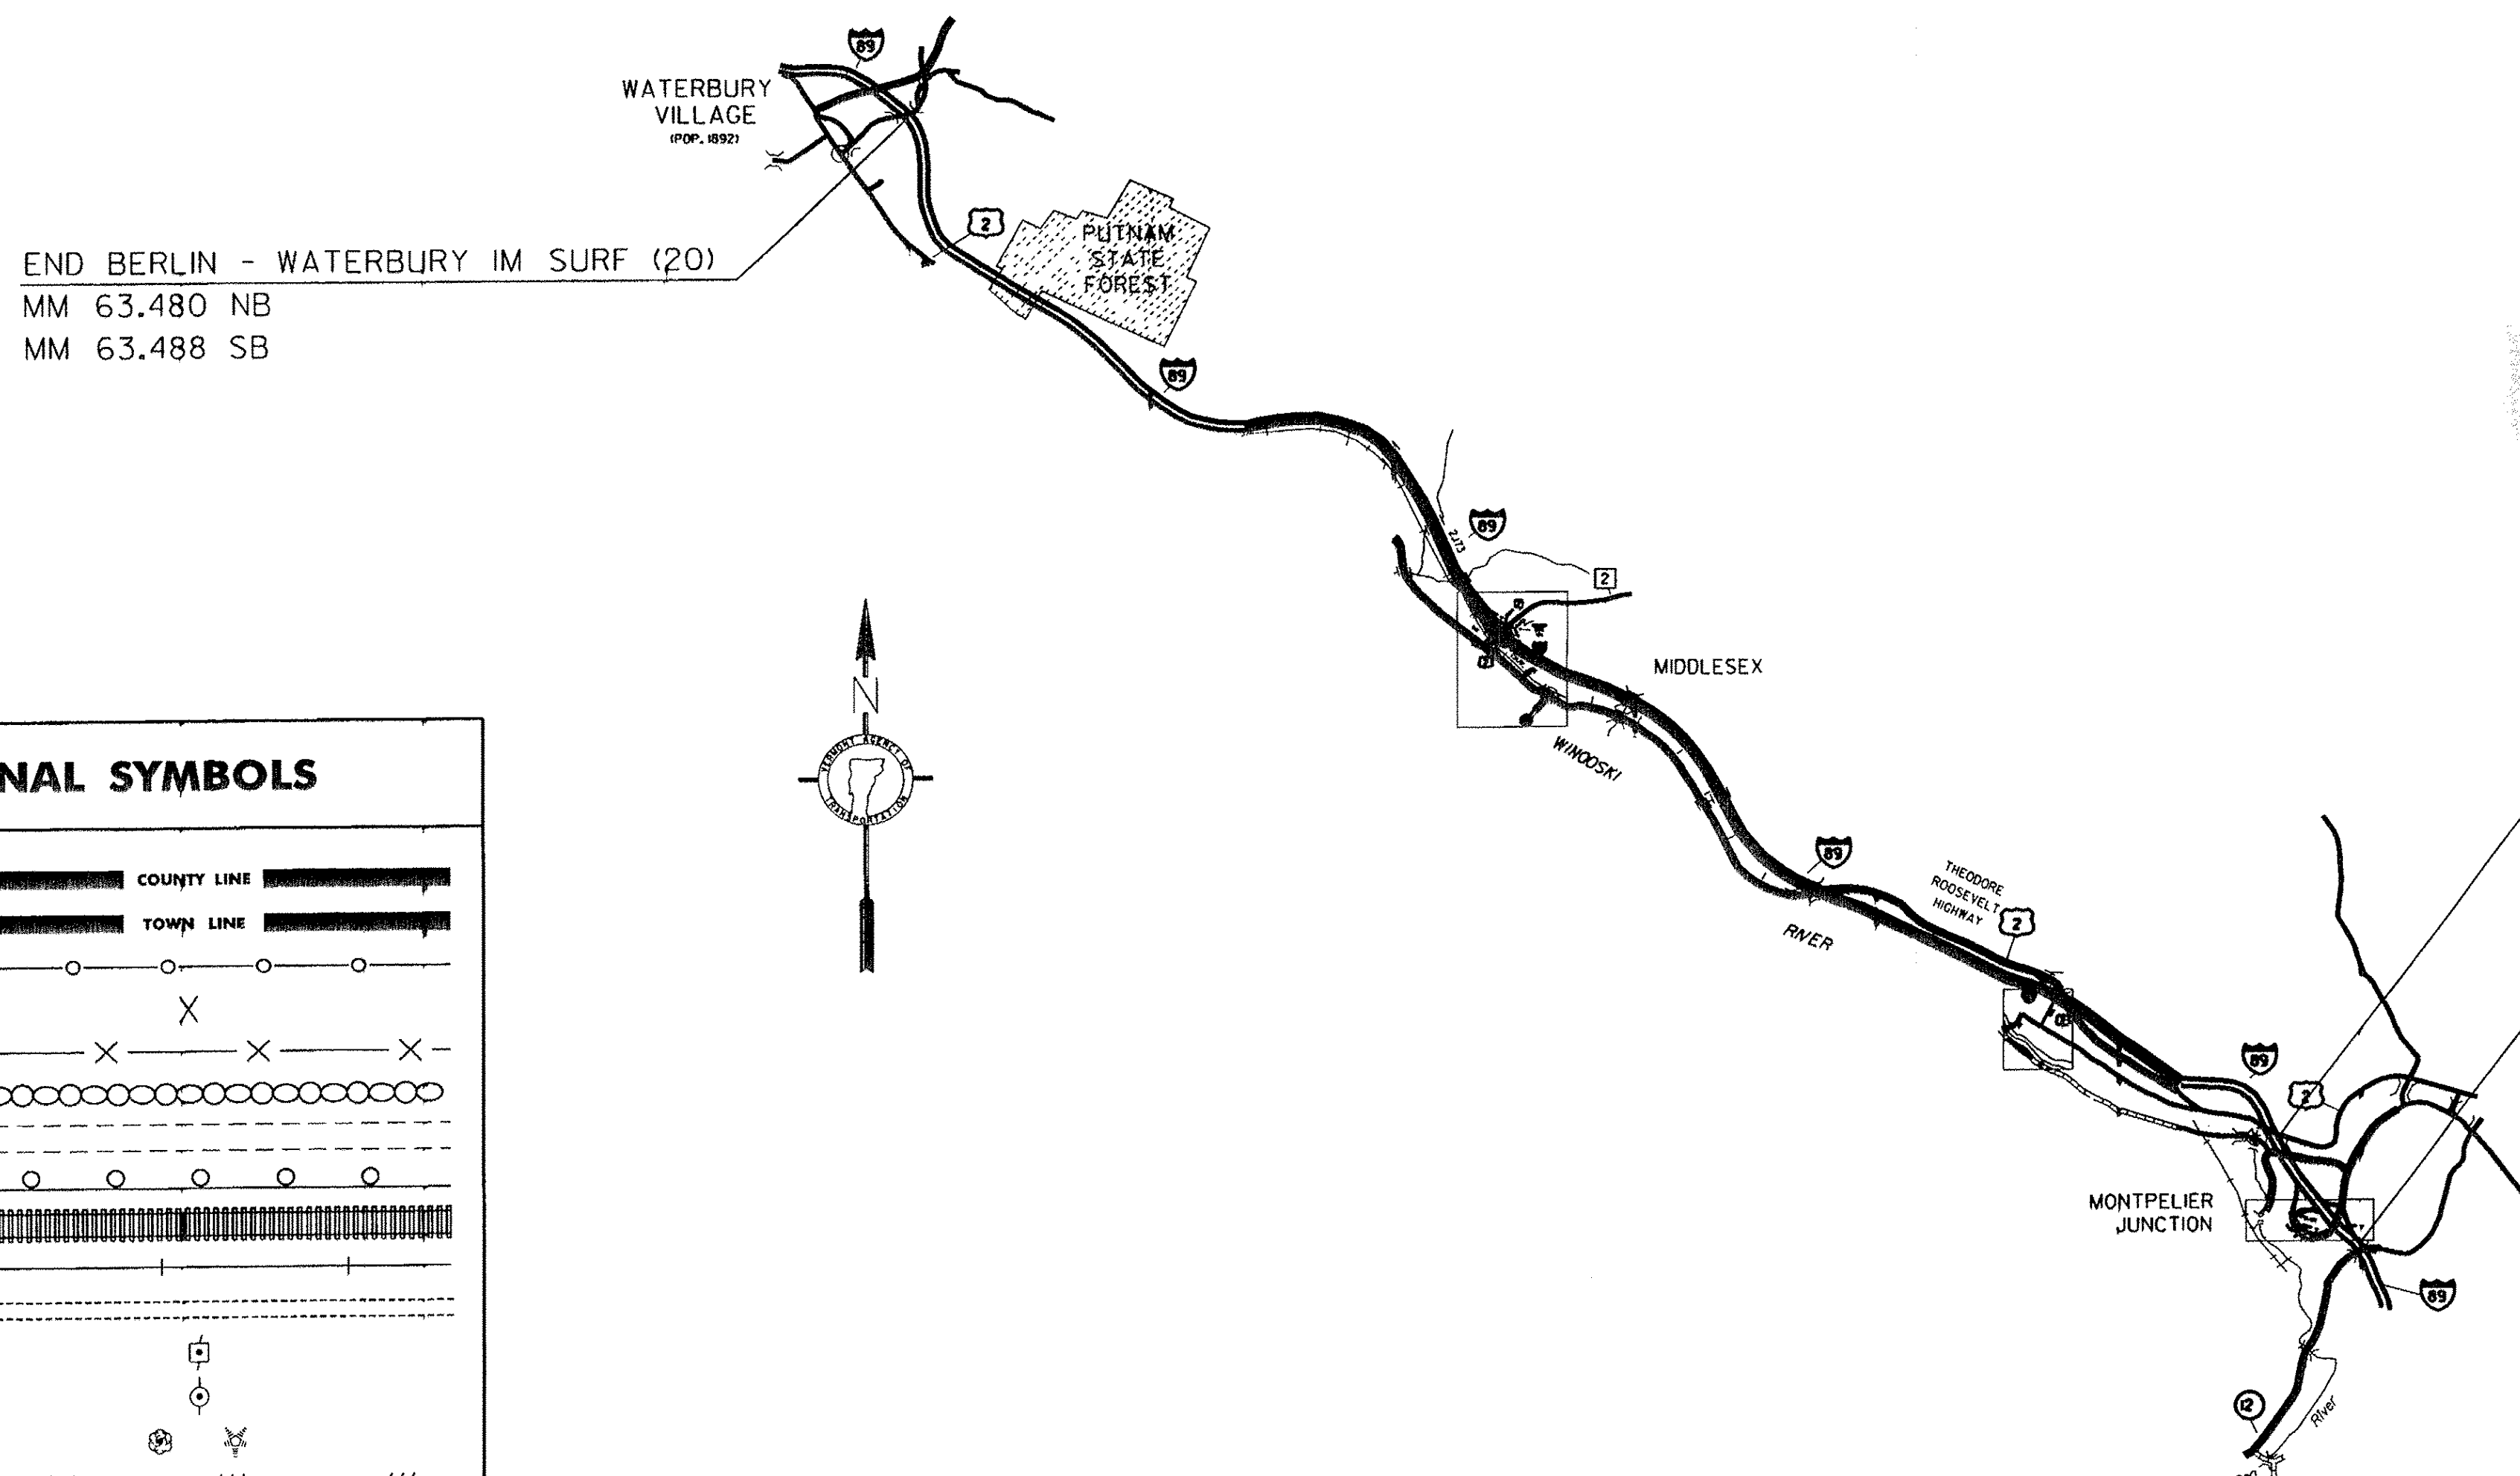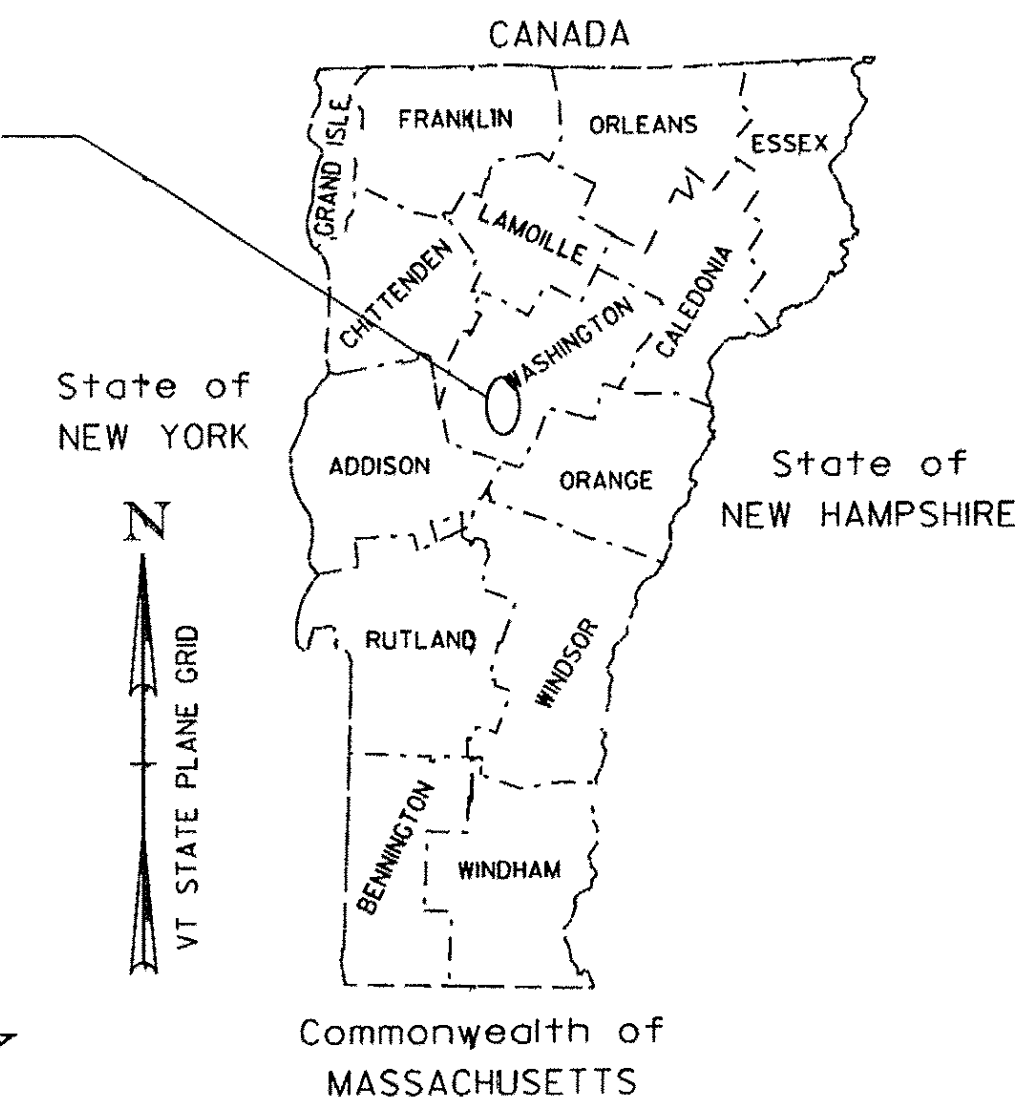

RECORD PLANS	
CONTRACTOR:	F.W. WHITCOMB CONSTRUCTION CORP. - WALPOLE, NH
RESIDENT ENGINEER:	TOM MANCINI
CONSTRUCTION BEGAN:	AUGUST 9, 2010
CONSTRUCTION COMPLETE:	SEPTEMBER 8, 2011
RECORD PLANS BY:	TOM MANCINI & JENNA HYDE
I HEREBY CERTIFY THAT ALL THE CONSTRUCTION REQUIRED BY THIS SET OF DRAWINGS HAS BEEN ACCOMPLISHED AS INDICATED HEREIN.	
BY	<i>Tom Mancini</i> RESIDENT ENGINEER
DATE	8/7/12
NOTE: Any further information concerning final quantities, amounts or other details relative to this project may be found at Central Files in the electronic archives.	

BEGIN/END MONTPELIER IM MEMB (23)
BR 42N NB
BR 42S SB

BEGIN BERLIN - WATERBURY IM SURF (20)
MM 52.600 NB
MM 52.620 SB

THESE PLANS ARE SUBJECT TO SUCH ENGINEERING CHANGES AS MAY BE REQUIRED BY THE FEDERAL HIGHWAY ADMINISTRATION OR THE DIRECTOR OF PROGRAM DEVELOPMENT.
CONSTRUCTION IS TO BE CARRIED ON IN ACCORDANCE WITH THESE PLANS AND THE STANDARD SPECIFICATIONS FOR CONSTRUCTION DATED 2006, AS APPROVED BY THE FEDERAL HIGHWAY ADMINISTRATION ON JUNE 15, 2006 FOR USE ON THIS PROJECT, INCLUDING ALL SUBSEQUENT REVISIONS AND SUCH REVISED SPECIFICATIONS AND SPECIAL PROVISIONS AS ARE INCORPORATED IN THESE PLANS.

CONVENTIONAL SYMBOLS	
COUNTY LINE	
TOWN LINE	
LIMITS OF ACCESS	
POINT OF ACCESS	
FENCE LINE	
STONE WALL	
TRAVELED WAY	
GUARD RAIL	
RAILROAD	
SURVEY LINE	
CULVERT	
POWER POLE	
TELEPHONE POLE	
TREES	
CONTROL OF ACCESS	
PROPERTY LINE	
R.O.W. TAKING LINE	
SLOPE RIGHTS	
TOP OF CUT	
TOE OF SLOPE	

DIRECTOR OF PROGRAM DEVELOPMENT	
APPROVED <i>Richard Schmitt</i>	DATE 5-20-10
PROJECT MANAGER : MIKE FOWLER	
PROJECT NAME : BERLIN - WATERBURY	MONTPELIER
PROJECT NUMBER : IM SURF (20)	IM MEMB (23)