


**INTERSTATE ROUTE 89 NB
(MM 52.600)
BEGIN PROJECT
IM SURF (20)**

**INTERSTATE ROUTE 89 NB
(MM 63.480)
LIMIT OF WORK
IM SURF (20)**


646.620 TEMPORARY 6" WHITE LINE
M. M. 52.600 - M. M. 63.480 NB (SOLID RT)
M. M. 52.600 - M. M. 63.480 NB (DASH)
646.630 TEMPORARY 6" YELLOW LINE
M. M. 52.600 - M. M. 63.480 NB (SOLID LT)
646.424 DURABLE 6 INCH WHITE LINE, POLYUREA
M. M. 52.600 - M. M. 63.480 NB (SOLID RT)
M. M. 52.600 - M. M. 63.480 NB (DASH)
646.434 DURABLE 6 INCH YELLOW LINE, POLYUREA
M. M. 52.600 - M. M. 63.480 NB (SOLID LT)

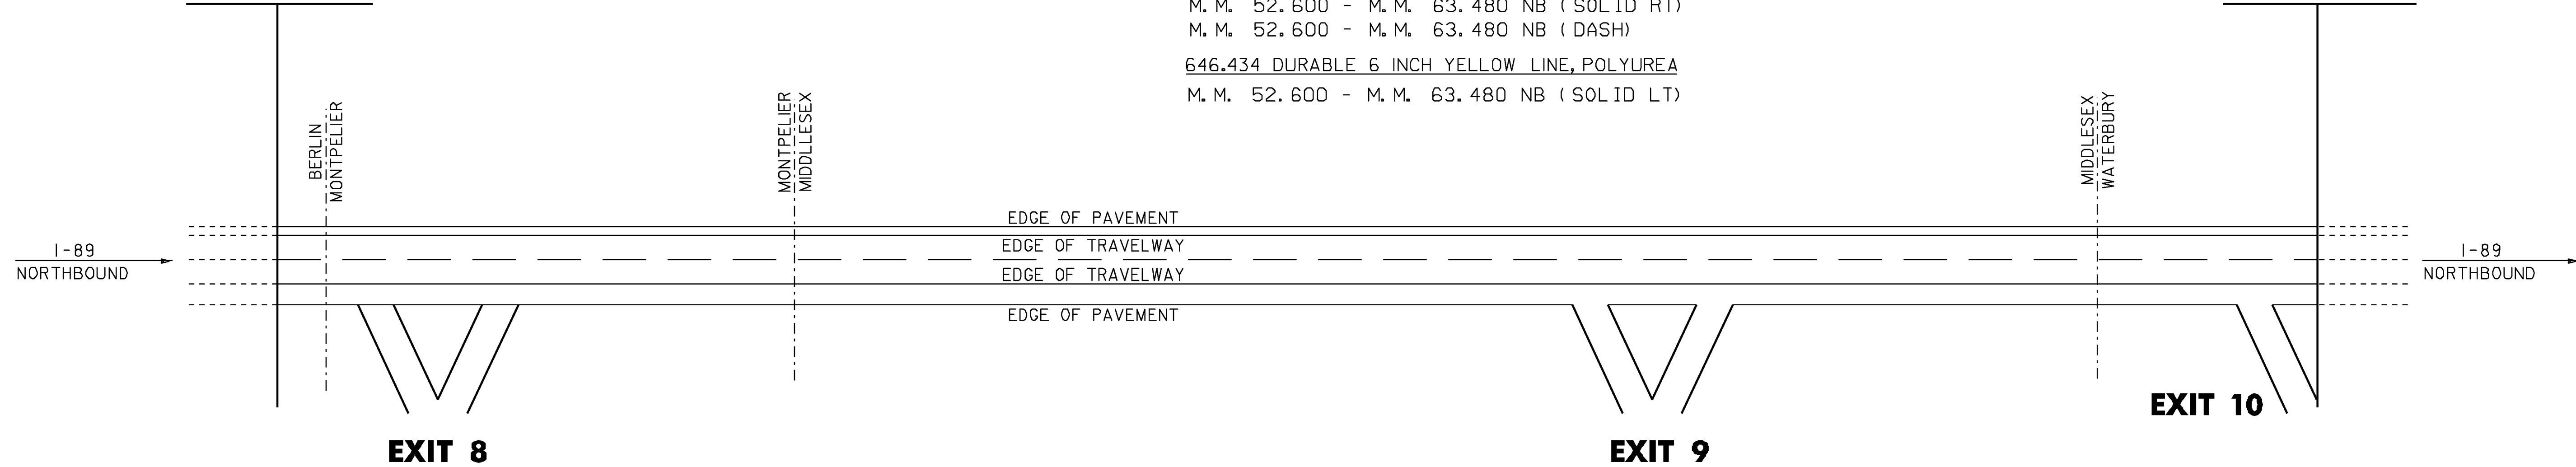

**INTERSTATE ROUTE 89 SB
(MM 52.620)
BEGIN PROJECT
IM SURF (20)**

**INTERSTATE ROUTE 89 SB
(MM 63.488)
LIMIT OF WORK
IM SURF (20)**

646.620 TEMPORARY 6" WHITE LINE
M. M. 52.620 - M. M. 63.488 SB (SOLID RT)
M. M. 52.620 - M. M. 63.488 SB (DASH)
646.630 TEMPORARY 6" YELLOW LINE
M. M. 52.620 - M. M. 63.488 SB (SOLID LT)
646.214 6" WHITE LINE
M. M. 52.620 - M. M. 63.488 SB (SOLID RT)
M. M. 52.620 - M. M. 63.488 SB (DASH)
646.215 6" YELLOW LINE
M. M. 52.620 - M. M. 63.488 SB (SOLID LT)

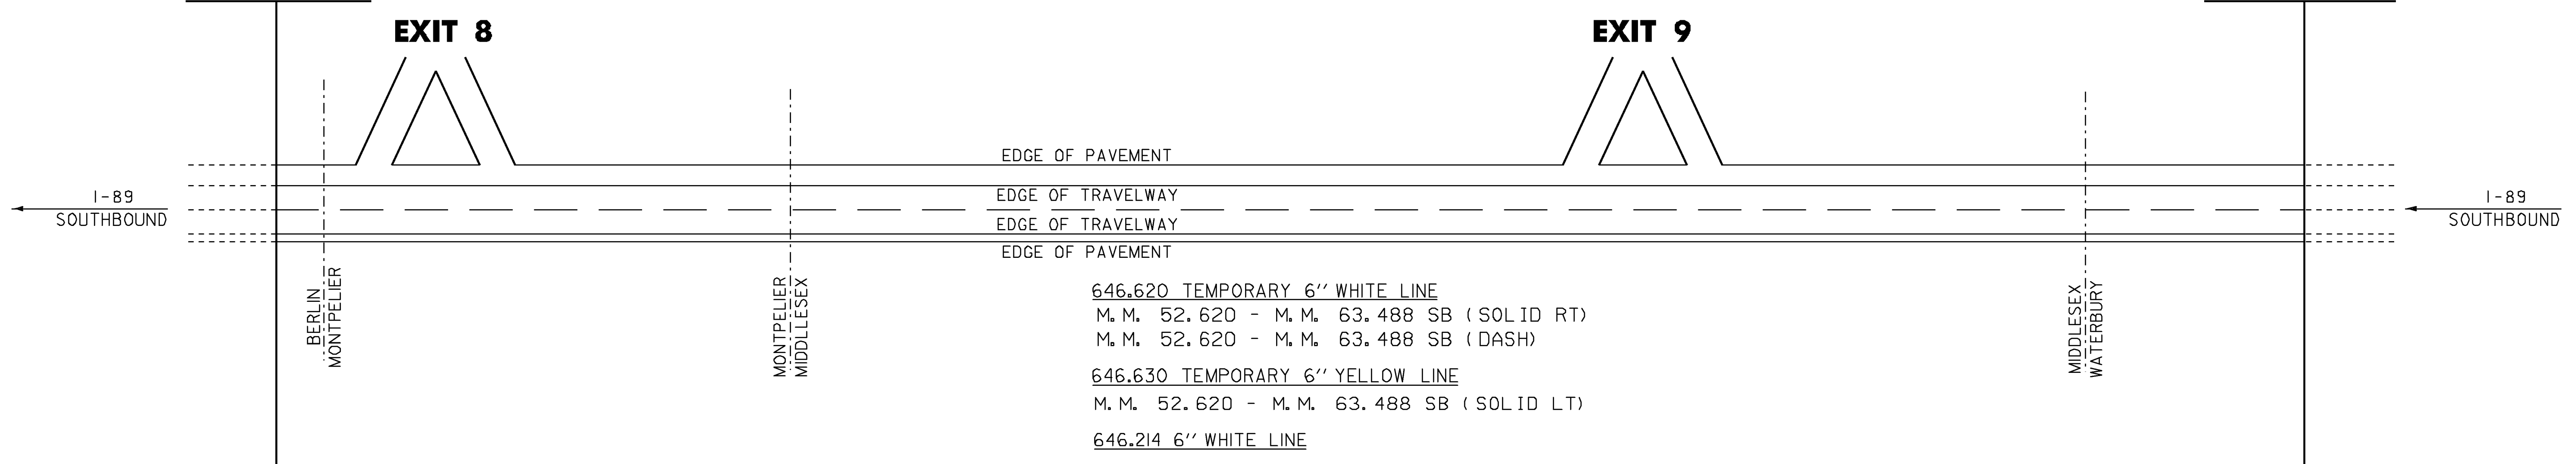

NOT TO SCALE

MAINLINE PAVEMENT MARKINGS NB & SB LANES	PROJECT NAME: BERLIN - WATERBURY	
	PROJECT NUMBER: IM SURF (20)	
	FILE NAME: /pave/09a382/p09a382.dgn	PLOT DATE: 21-MAY-2010
PROJECT MANAGER: MIKE FOWLER	DRAWN BY: WILDER	
DESIGNED BY: WILDER	CHECKED BY: PAVT MGMT	
IPARM FILE NAME: p09a382_14.1	SHEET 14 OF 63	