

646.214 6 INCH WHITE LINE

RAMP 'C' SOLID RT (951')
 RAMP 'D' SOLID RT (2640')
 RAMP 'D' DASH (40')
 RAMP 'D' DOTTED (127')

646.215 6 INCH YELLOW LINE

RAMP 'C' SOLID LT (2691')
 RAMP 'D' SOLID LT (2585')

646.24 12 INCH WHITE LINE

RAMP 'C' GORE AREA (520')
 RAMP 'D' GORE AREA (420')

646.424 DURABLE 6 INCH WHITE LINE, POLYUREA

RAMP 'A' SOLID RT (2640')
 RAMP 'A' DOTTED (142')
 RAMP 'B' SOLID RT (951')
 RAMP 'B' DASH (60')

646.434 DURABLE 6 INCH YELLOW LINE, POLYUREA

RAMP 'A' SOLID LT (1529')
 RAMP 'B' SOLID LT (1085')

646.464 DURABLE 12 INCH WHITE LINE, POLYUREA

RAMP 'A' GORE AREA (500')
 RAMP 'B' GORE AREA (432')

SINKHOLE REPAIRS

MM 53.089 TRAVEL LANE 11'X10'
 MM 53.311 TRAVEL LANE & PASSING LANE 11'X16'

646.620 TEMPORARY 6 INCH WHITE LINE


RAMP 'A' SOLID RT (2640')
 RAMP 'A' DOTTED (142')
 RAMP 'B' SOLID RT (951')
 RAMP 'B' DASH (60')
 RAMP 'C' SOLID RT (951')
 RAMP 'D' SOLID RT (2640')
 RAMP 'D' DASH (40')
 RAMP 'D' DOTTED (127')

646.630 TEMPORARY 6 INCH YELLOW LINE


RAMP 'A' SOLID LT (1529')
 RAMP 'B' SOLID LT (1085')
 RAMP 'C' SOLID LT (2691')
 RAMP 'D' SOLID LT (2585')

646.660 TEMPORARY 12 INCH WHITE LINE

RAMP 'A' GORE AREA (500')
 RAMP 'B' GORE AREA (432')
 RAMP 'C' GORE AREA (520')
 RAMP 'D' GORE AREA (420')

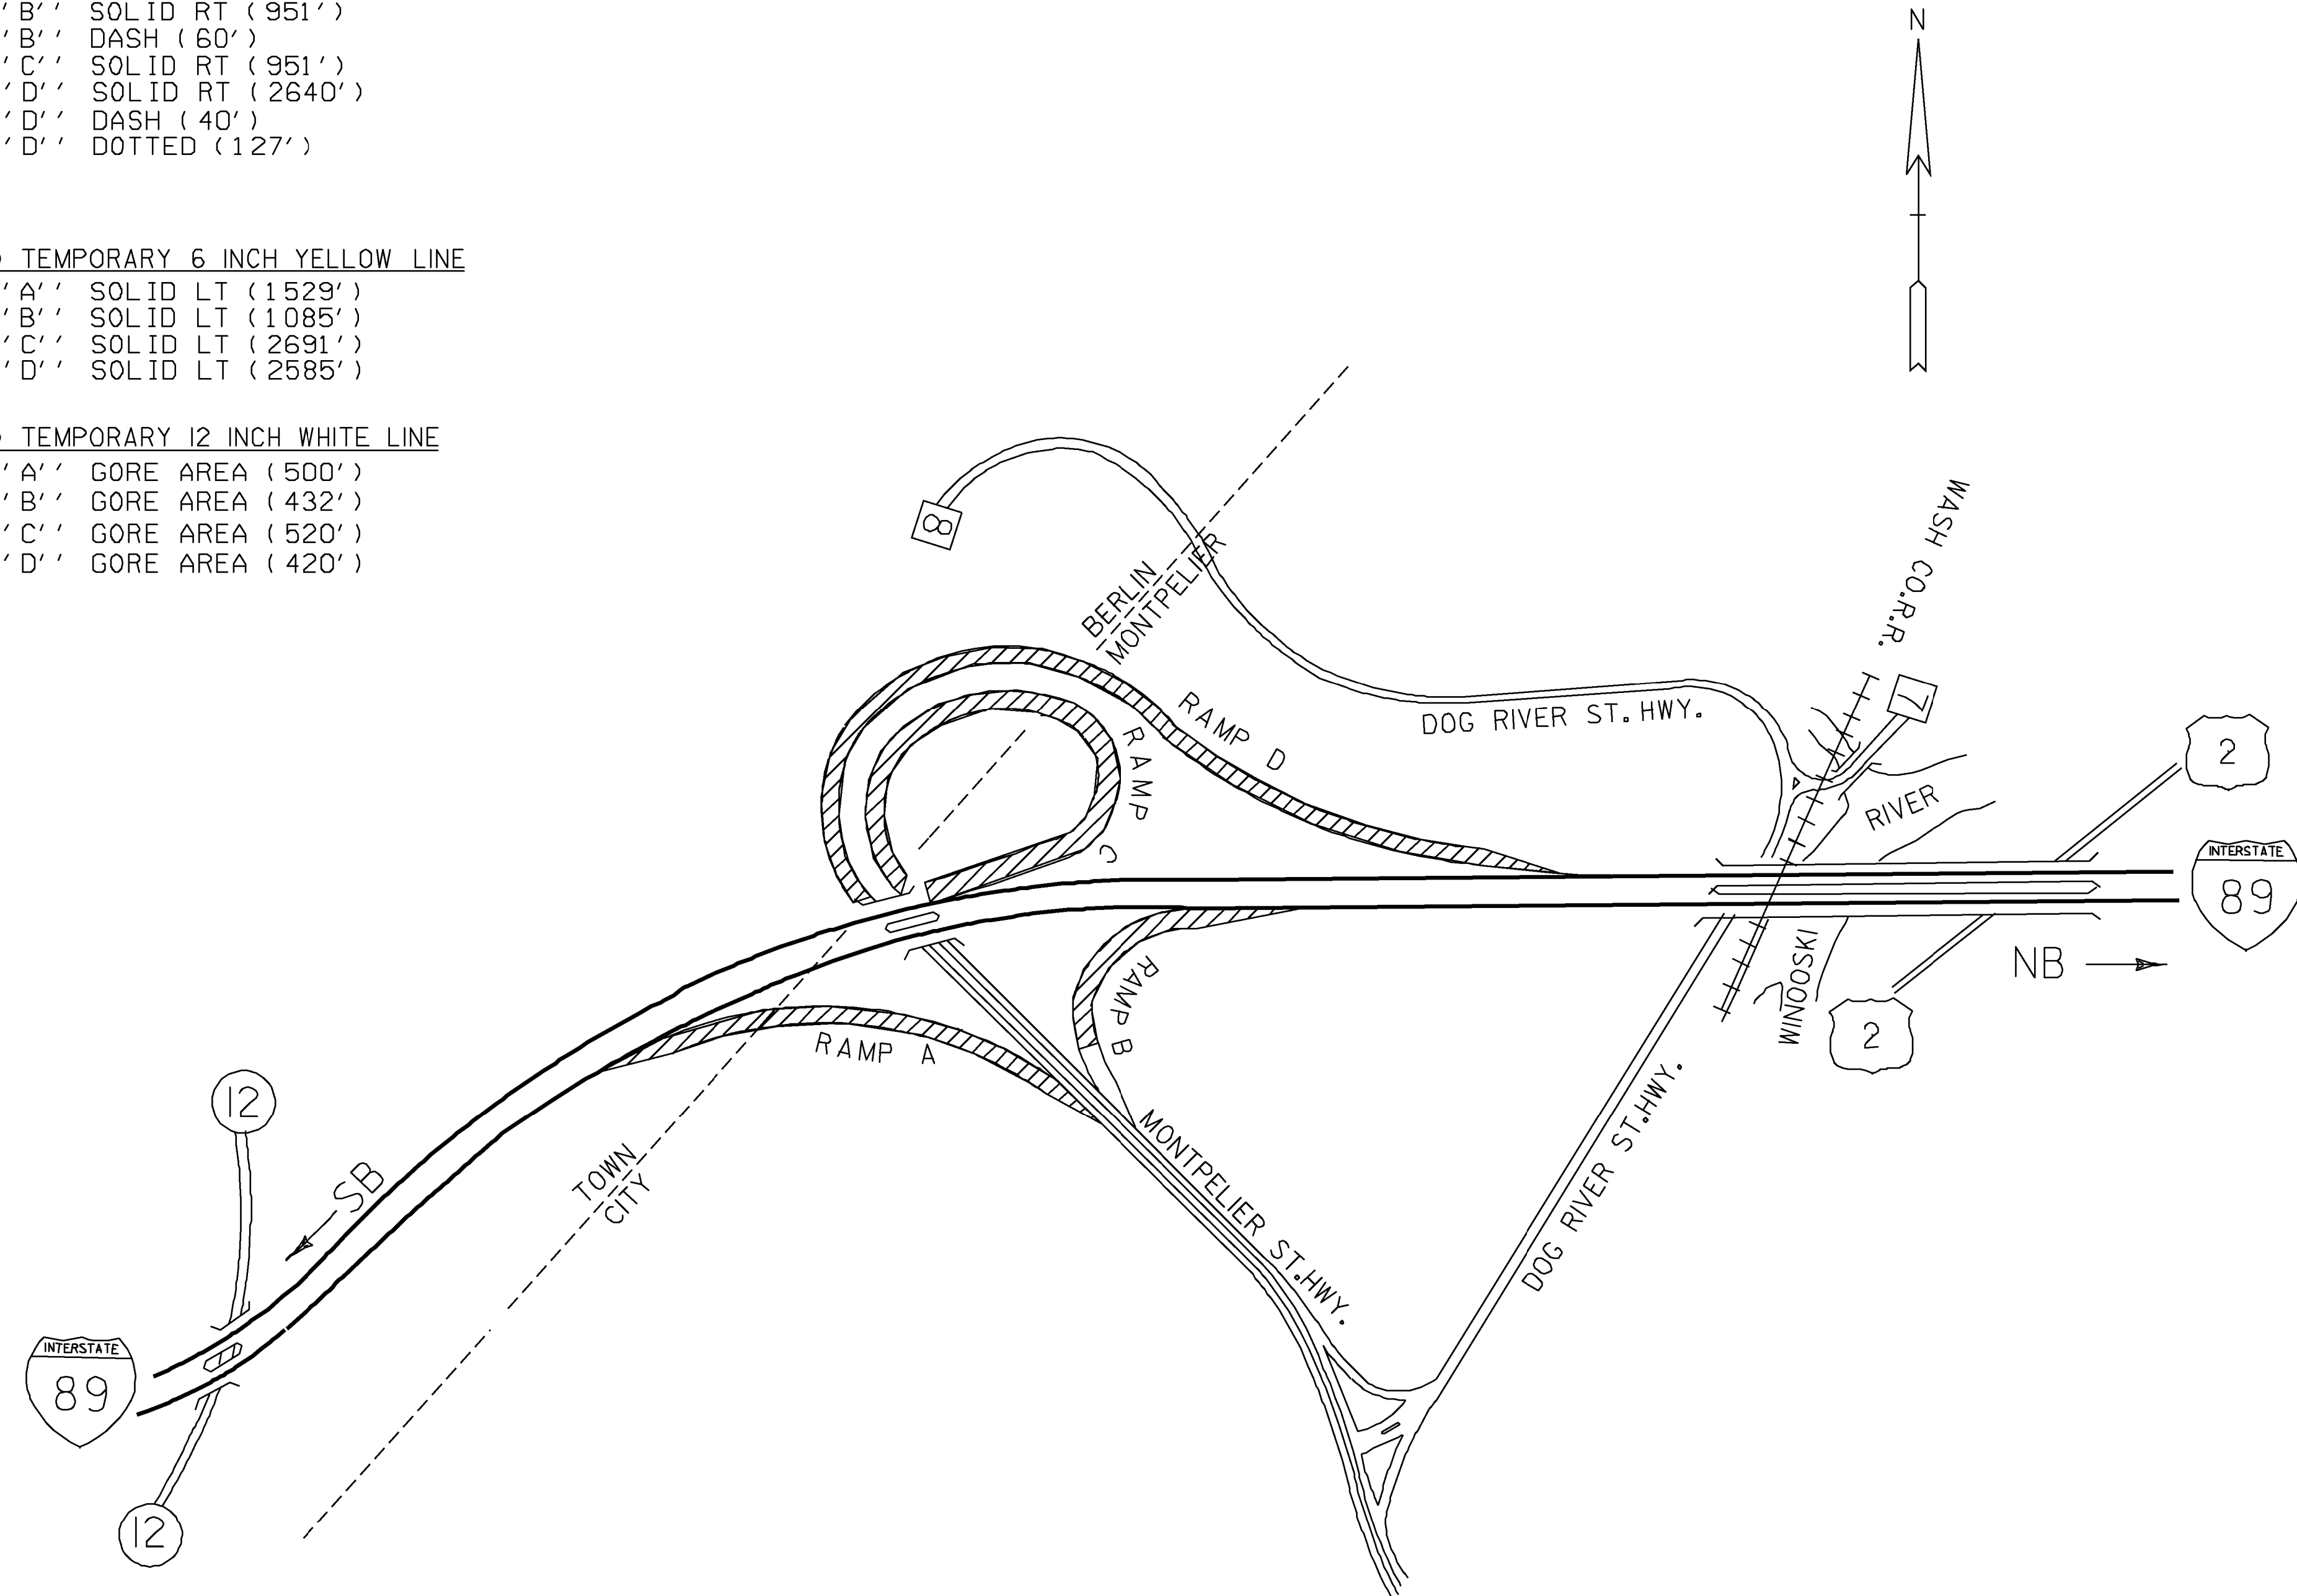

NOT TO SCALE

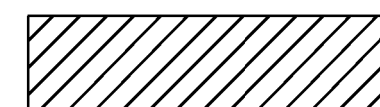 = WORK AREA

**EXIT #8
 PAVEMENT MARKINGS**

PROJECT NAME: MONTPELIER - WATERBURY

PROJECT NUMBER: IM 089-2(34)

FILE NAME: /pave/09a382/p09a382.dgn

PROJECT MANAGER: MIKE FOWLER

DESIGNED BY: WILDER

IPARM FILE NAME: p09a382_15.i

PLOT DATE: 21-MAY-2010

DRAWN BY: WILDER

CHECKED BY: PAVT MGMT

SHEET 15 OF 63