


RAMPS REQUIRING CRACK SEALING

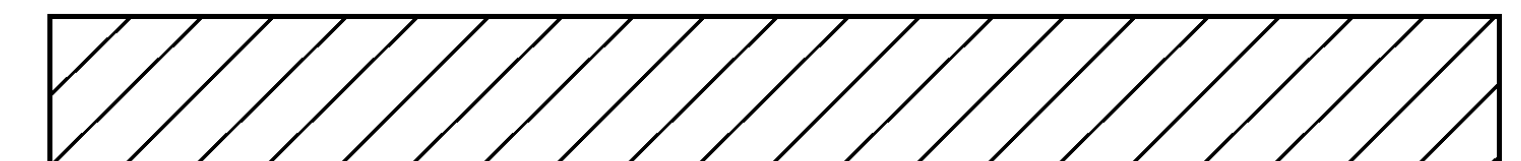

ASCUTNEY INTERCHANGE #8
I-91

NOT TO SCALE

INTERCHANGE DETAIL SHEET # 1	PROJECT NAME: STATEWIDE	PLOT DATE: 26-FEB-2010
	PROJECT NUMBER: STP CRAK(28)	DRAWN BY: LOCKE
	FILE NAME: p09k336.dgn PROJECT LEADER: FOWLER DESIGNED BY: LOCKE p09k336Int1.l	CHECKED BY: PAVT MGMT SHEET 6 OF 14