


RAMPS REQUIRING CRACK SEALING

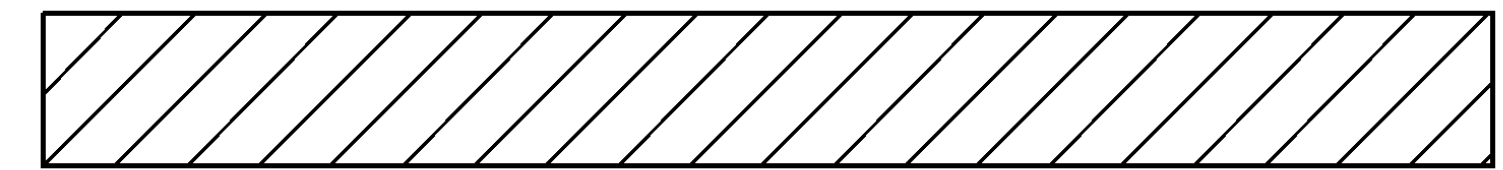

BRATTLEBORO INTERCHANGE # 1
I-91

TO SPRINGFIELD,
MASS.

NOT TO SCALE

INTERCHANGE DETAIL SHEET # 2	PROJECT NAME: STATEWIDE	PLOT DATE: 26-FEB-2010
	PROJECT NUMBER: STP CRAK(28)	DRAWN BY: LOCKE
	FILE NAME: p089k336.dgn PROJECT LEADER: FOWLER DESIGNED BY: LOCKE p09k336Int2.1	CHECKED BY: PAVT MGMT SHEET 7 OF 14