


**WILLISTON INTERCHANGE #12**  
**I-89**

**NOT TO SCALE**

RAMPS REQUIRING CRACK SEALING

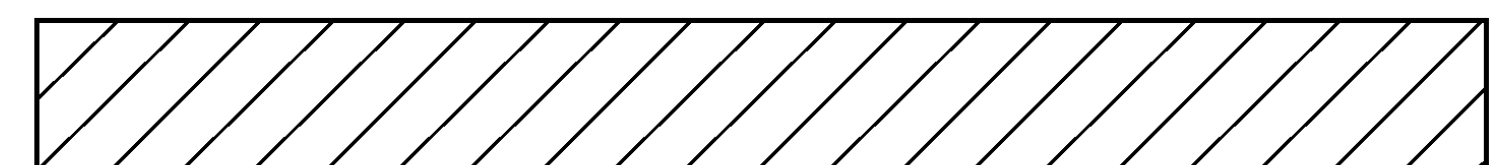

**INTERCHANGE**  
**DETAIL**  
**SHEET # 5**

PROJECT NAME: STATEWIDE  
 PROJECT NUMBER: STP CRAK(28)

FILE NAME: p09k336.dgn  
 PROJECT LEADER: FOWLER  
 DESIGNED BY: LOCKE  
 p09k336Int5.1

PLOT DATE: 26-FEB-2010  
 DRAWN BY: LOCKE  
 CHECKED BY: PAVT MGMT  
 SHEET 10 OF 14