


**WINOOSKI NORTH INTERCHANGE # 16**

**I-89**

**NOT TO SCALE**

RAMPS REQUIRING CRACK SEALING

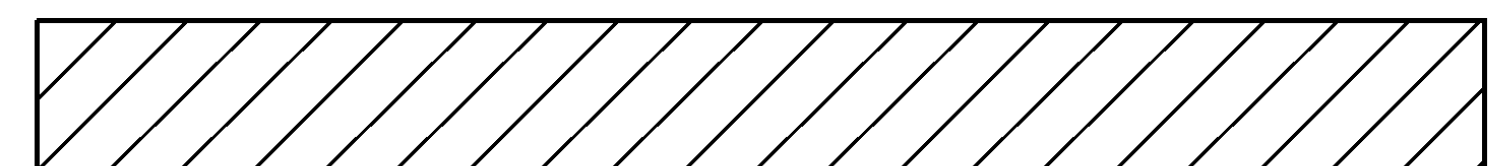

**INTERCHANGE  
DETAIL  
SHEET # 8**

PROJECT NAME: STATEWIDE  
PROJECT NUMBER: STP CRAK(28)

FILE NAME: p09k336.dgn  
PROJECT LEADER: FOWLER  
DESIGNED BY: LOCKE  
p09k336Int8.1

PLOT DATE: 26-FEB-2010  
DRAWN BY: LOCKE  
CHECKED BY: PAVT MGMT  
SHEET 13 OF 14