



DETAIL OF PARTIAL PARABOLIC CROWN OF SLAB

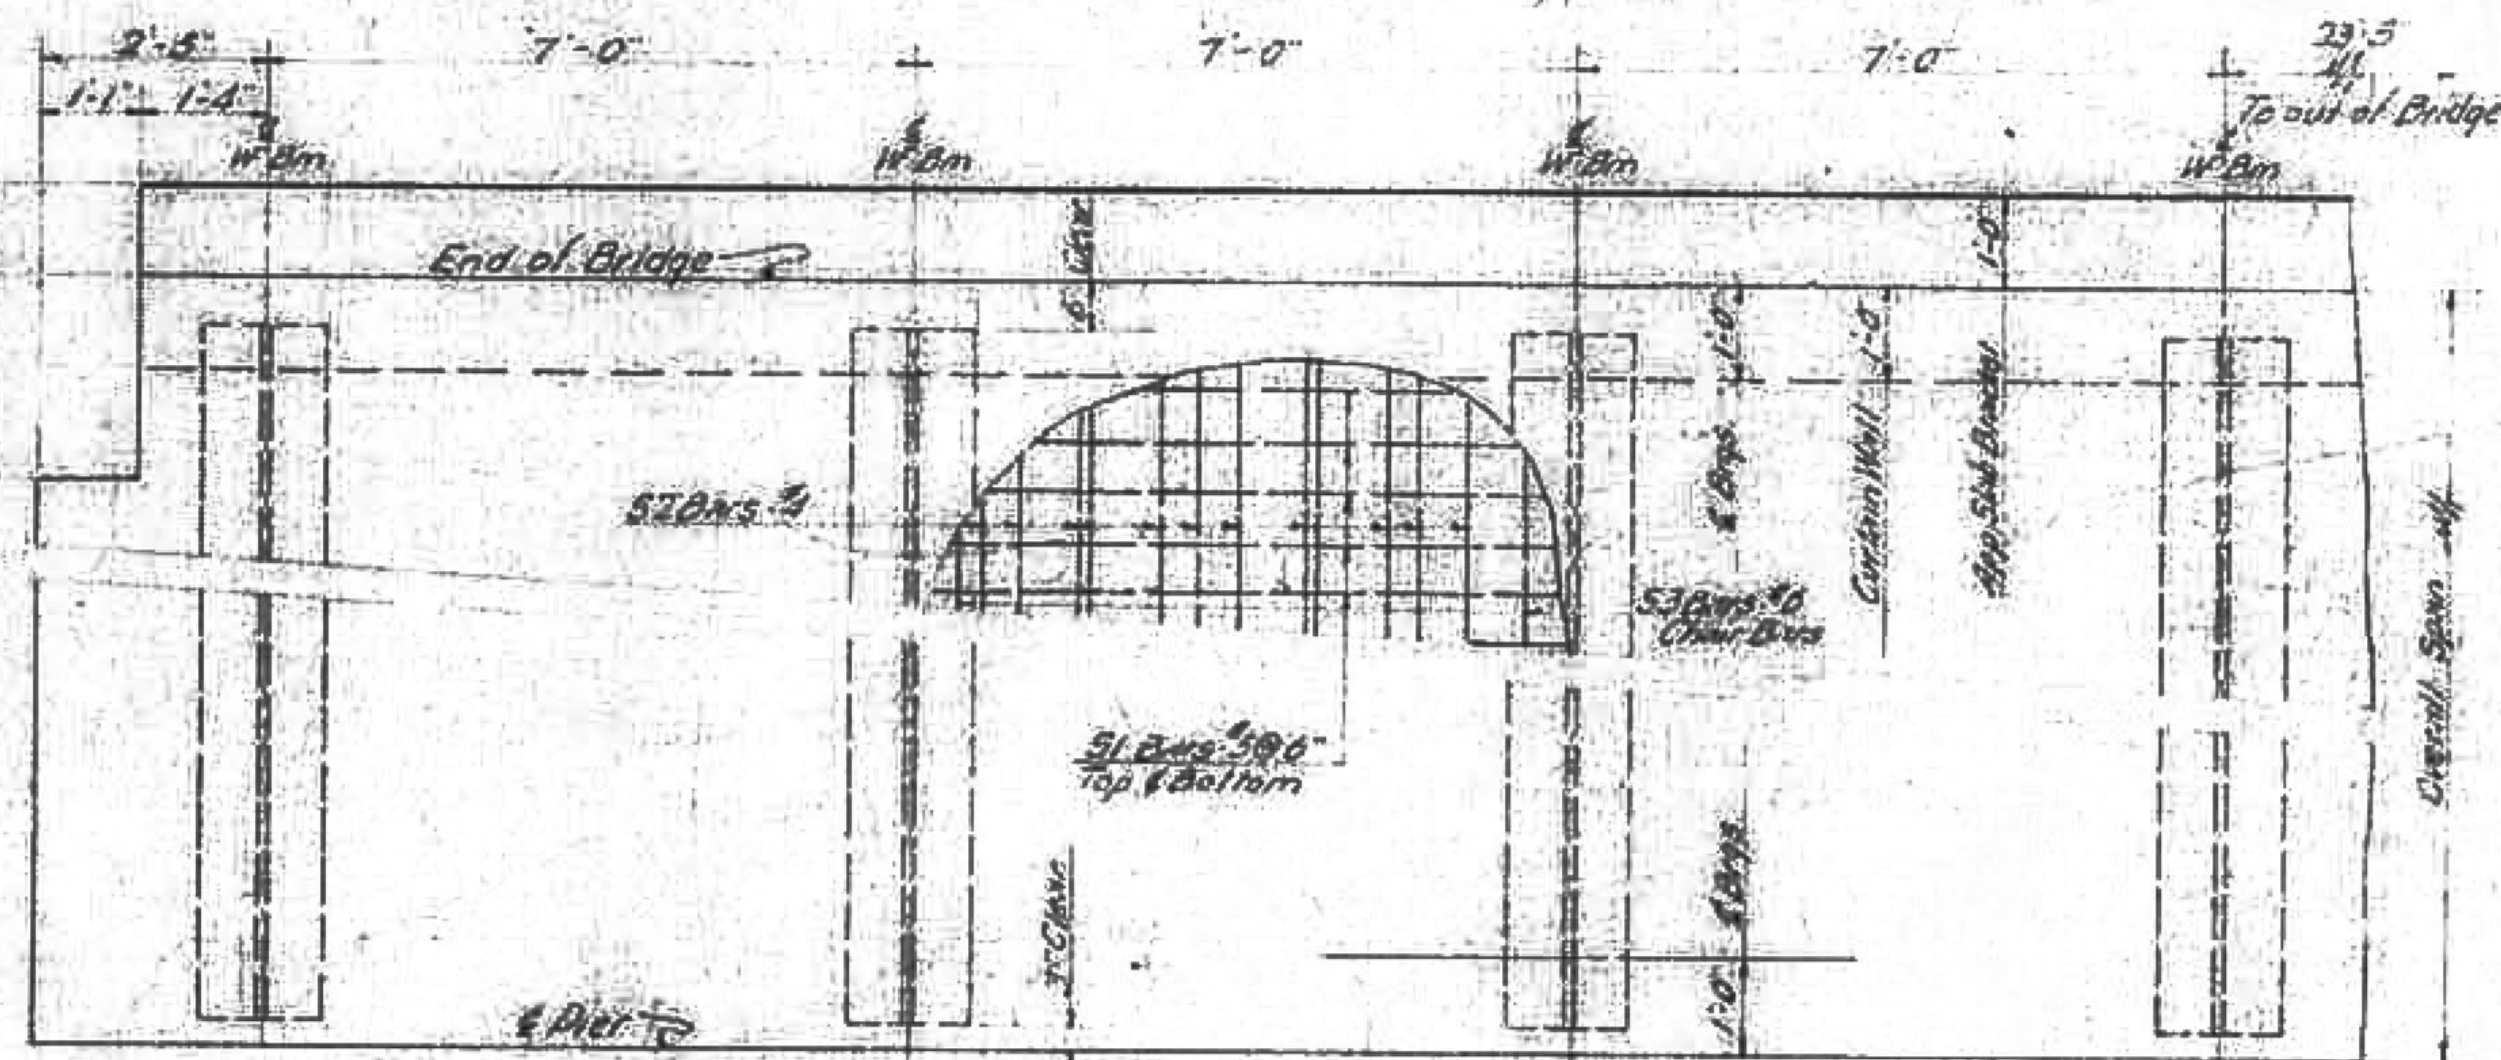

PARTIAL PLAN

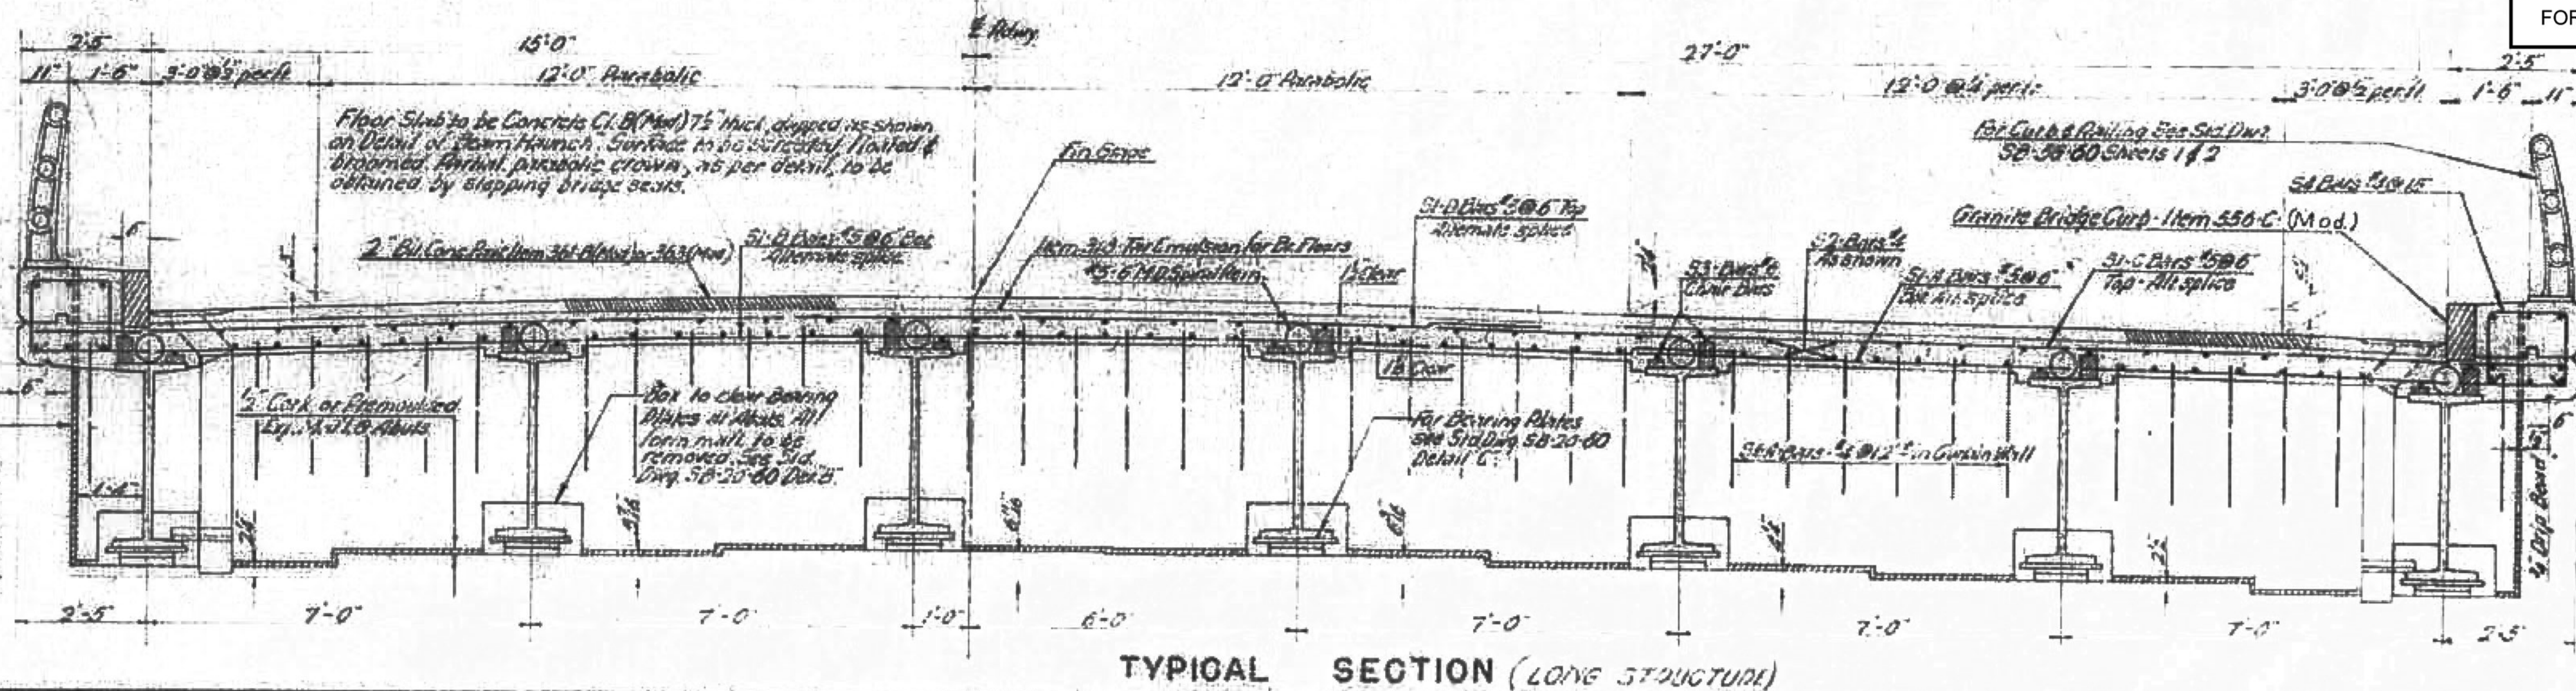

TYPICAL SECTION (LONG STRUCTURE)

**TABLE OF QUANTITIES FOR SINGLE (SQUARE) SPAN**

Span - Out to Out	99'-0"	94'-0"	89'-0"	84'-0"	79'-0"	74'-0"	69'-0"	64'-0"	59'-0"	54'-0"	49'-0"	44'-0"	39'-0"	34'-0"
Span - E to E Bearings	97'-0"	92'-0"	87'-0"	82'-0"	77'-0"	72'-0"	67'-0"	62'-0"	57'-0"	52'-0"	47'-0"	42'-0"	37'-0"	32'-0"
Length of Beams	98'-0"	93'-0"	88'-0"	83'-0"	78'-0"	73'-0"	68'-0"	63'-0"	58'-0"	53'-0"	48'-0"	43'-0"	38'-0"	33'-0"
Size of Beams	36W300	36W300	36W300	36W245	36W194	36W170	36W160	36W150	36W150	36W150	36W150	36W150	33W130	30W116
Lqth. of Size Top Cover A	85'-0"	80'-0"	75'-0"	70'-0"	65'-0"	60'-0"	55'-0"	50'-0"	45'-0"	40'-0"	35'-0"	30'-0"	25'-0"	20'-0"
Lqth. of Size Top Cover B	85'-0"	80'-0"	75'-0"	70'-0"	65'-0"	60'-0"	55'-0"	50'-0"	45'-0"	40'-0"	35'-0"	30'-0"	25'-0"	20'-0"
Dead Load Deflection	3	2 1/2	2 1/2	2 1/2	1 3/4	1 1/2	1 1/4	1	7/8	5/8	5/8	5/8	5/8	5/8
Diameter of Spiral Bars														
Main Diameter of Spiral														
Spiral Pitch 0'-10" From Brng.	Double #5	Double #5	Double #6	Double #5	Double #5	Double #5	Double #5	Double #5	Double #5	Double #5	Double #5	Double #5	Double #5	Double #5
10'-20" or E Span	Double #5	Double #5	Double #5	Double #5	Double #5	Double #5	Double #5	Double #5	Double #5	Double #5	Double #5	Double #5	Double #5	Double #5
20'-30"	45	4	4	4	4	4	4	4	4	4	4	4	4	4
30'-40"	5 1/2	5 1/2	5 1/2	5 1/2	6	6	7	7 1/2						
40'-E Span	7	7	8	8										
Lqth. of 2" Stud (All to Spirals)			6 1/2	Long unless otherwise specified	on the Plans 2 Studs required per Pitch									
Total Struct Steel (1 Span) (lbs)	269,740	237,590	218,700	172,520	138,420	115,910	97,160	82,550	72,740	65,810	58,080	52,730	39,290	30,930
Reinforcing Bars - S1-A	198	188	178	168	158	148	138	128	118	108	98	88	78	68
S1-B	198	188	178	168	158	148	138	128	118	108	98	88	78	68
S1-C	198	188	178	168	158	148	138	128	118	108	98	88	78	68
S1-D	198	188	178	168	158	148	138	128	118	108	98	88	78	68
S2	264	264	264	264	264	264	264	264	264	264	264	264	264	264
S3	42	42	42	42	42	42	42	42	42	42	42	42	42	42
S4	128	122	114	108	102	94	88	82	74	68	62	54	48	42
S5	32	32	32	32	32	32	32	32	32	32	32	32	32	32
S6A	76	76	76	76	76	76	76	76	76	76	76	76	76	76
S7	62	62	62	62	62	62	62	62	62	62	62	62	62	62
Total Weight Reinf. Bars (lbs)	30,140	28,710	27,290	25,840	24,400	22,980	21,530	19,900	18,460	17,030	15,500	14,160	12,710	11,090
Approx. Weight Spiral (lbs)	3,570	3,530	3,490	3,310	3,250	3,070	2,920	2,740	2,600	2,360	2,170	Non Composite	Non Composite	Non Composite
Total Concrete Class B (Cords)	151	144	137	131	124	117	110	103	95	89	82	75	67	59
Total Weight Column Conc. (Tons)	59	56	53	50	47	44	41	38	35	32	29	26	23	20
Tie Reinforcement for Bridge Heads (lbs)	185	176	166	157	148	138	129	120	110	101	92	82	73	64
Approx. Quantity 2" x 6" Studs	4,150	4,050	3,950	3,800	3,720	3,500	3,300	3,100	3,000	2,700	2,500	Non Composite	Non Composite	Non Composite

RICHMOND  
IM BPNT (7)  
SHEET 13 OF 15  
BRIDGE 57  
FOR REFERENCE ONLY

**REINFORCING STEEL SCHEDULE**

Span	S2-2	S3-4	S6A-4d	S4-2	S6A-4
34	33'-6"	33'-6"	2'-8"	6'-6"	TL 5'-3"
39	20'-3"	20'-6"	2'-9"	7'-0"	B 1'-6"
44	22'-9"	23'-0"	3'-0"	7'-6"	D 1'-6"
49	25'-3"	25'-6"	3'-0"	7'-6"	C 1'-5"
54	27'-9"	28'-0"	3'-0"	7'-6"	H 3"
59	30'-3"	30'-6"	3'-0"	7'-6"	B
64	32'-9"	33'-0"	3'-0"	7'-6"	D
69	34'-3"	34'-6"	3'-2"	7'-10"	A 5" 6 1/2"
74	26'-0"	26'-3"	3'-2"	7'-10"	57'-4"
79	27'-6"	28'-0"	3'-3"	8'-0"	56D-15
84	29'-3"	29'-6"	3'-3"	8'-0"	TL 3'-0"
89	31'-0"	31'-3"	3'-3"	8'-0"	TL 4'-2"
94	32'-6"	33'-0"	3'-4"	8'-2"	B 1'-8"
99	34'-3"	34'-6"	3'-4"	8'-2"	B 2'-6"

Revisions & Corrections  
Changed To 12" Curb 9/7/60

Drawn By: A.B.M. 6-17-60  
Traced By: A.B.M. 6-17-60  
Checked By: R.I.B. & R.S.H. July, 1960  
Correct: 13 July 1960  
Approved: 13 July 1960  
Chief Engineer

TYPICAL SECTION, PLAN VIEW, & QUANTITIES  
42 FOOT ROADWAY W/ BEAM BRIDGES  
34-44 NON COMPOSITE, 49-99 COMPOSITE  
FOR ADDITIONAL DETAILS SEE STANDARD SCB-D-60

DEPARTMENT OF HIGHWAYS  
STANDARD STRUCTURES

SCB-42-60

VOID  
Reprinted  
for photographing  
July 1962