


SEE SHEET 2 FOR INDEX OF SHEETS
AND LIST OF STANDARDS

STATE OF VERMONT AGENCY OF TRANSPORTATION



PROPOSED IMPROVEMENT BRIDGE PROJECT

TOWN OF BROOKFIELD
COUNTY OF ORANGE

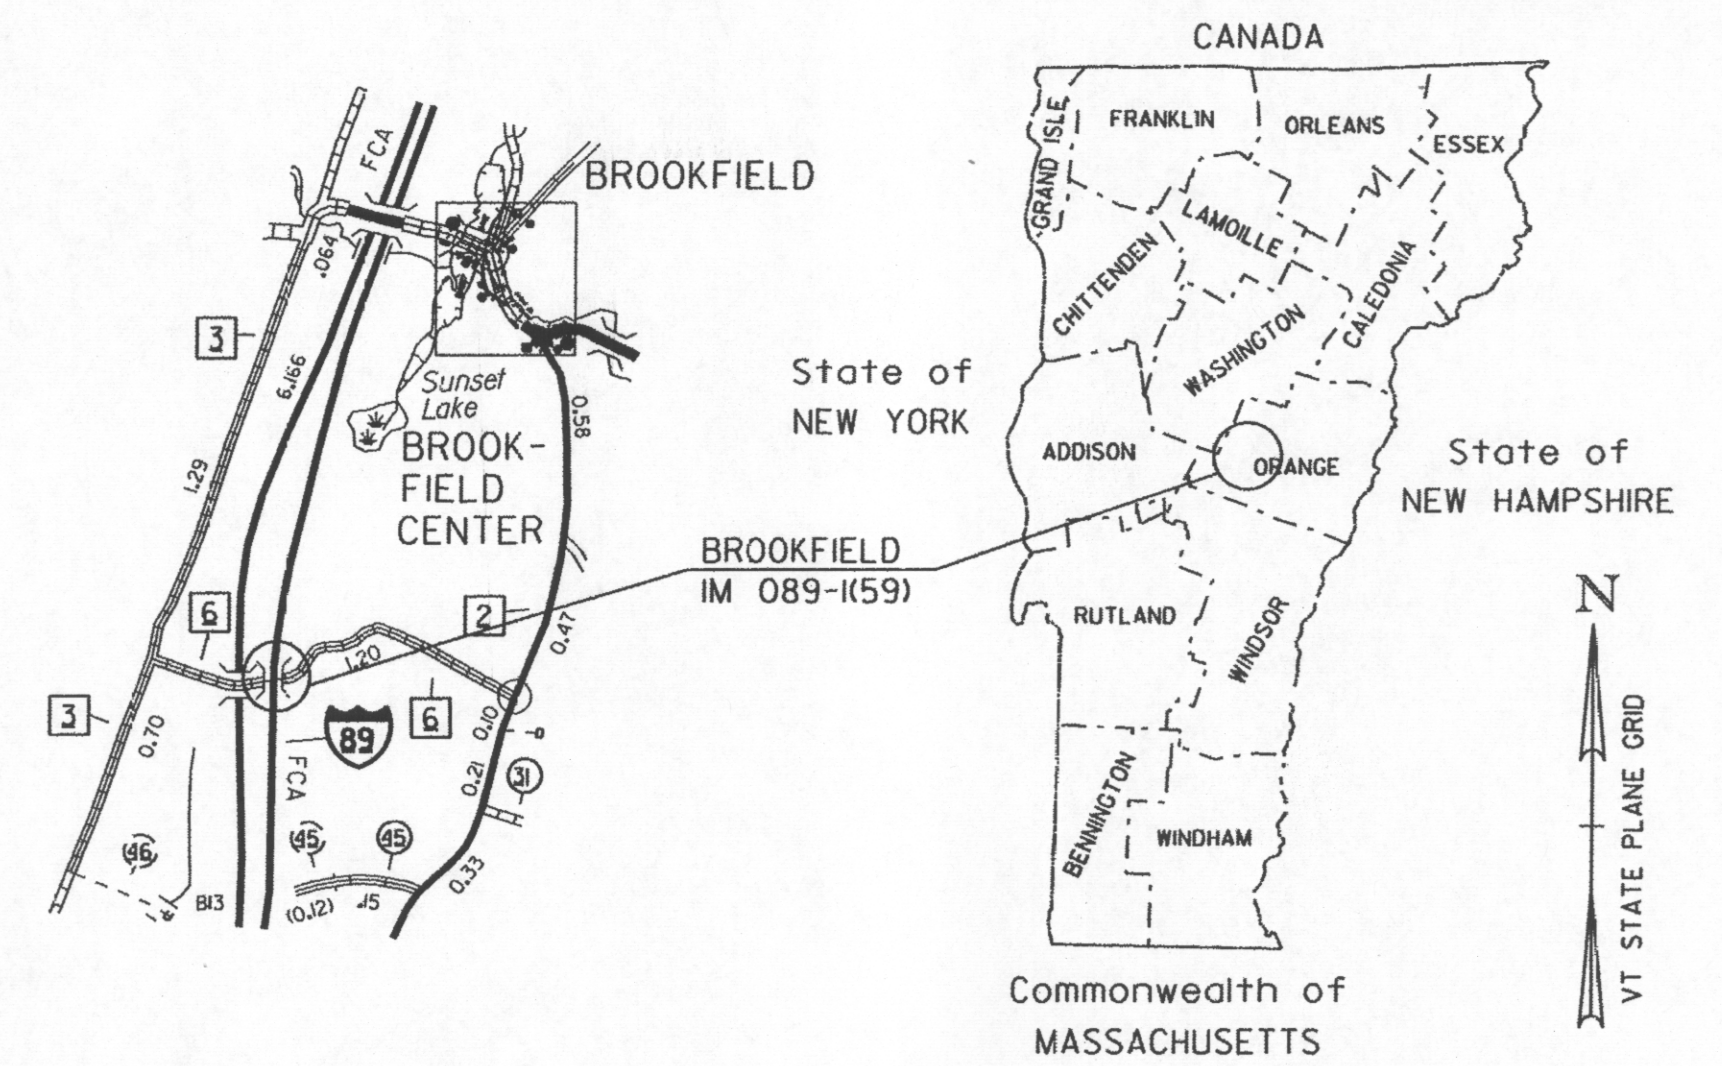

ROUTE NO : INTERSTATE 89

BRIDGE NO : 32N

PROJECT LOCATION : IN BROOKFIELD ON INTERSTATE 89NB NEAR MILE MARKER 36.545

PROJECT DESCRIPTION : REPLACEMENT OF EXISTING BRIDGE DECK ALONG WITH RELATED ROADWAY APPROACH WORK.

LENGTH OF STRUCTURE : 69.00 FEET.
LENGTH OF ROADWAY : 240.00 FEET.
LENGTH OF PROJECT : 309.00 FEET.

RECORD PLANS	
CONTRACTOR:	S. D. IRELAND CONC. CONST. CORP - BURLINGTON, VT
RESIDENT ENGINEER:	DARYL BASSETT
CONSTRUCTION BEGAN:	APRIL 30, 2012
CONSTRUCTION COMPLETE:	JULY 26, 2012
RECORD PLANS BY:	DARYL BASSETT & CRAIG PIERCE
I HEREBY CERTIFY THAT ALL THE CONSTRUCTION REQUIRED BY THIS SET OF DRAWINGS HAS BEEN ACCOMPLISHED AS INDICATED HEREIN.	
BY	<i>Daryl Bassett</i> RESIDENT ENGINEER
DATE	April 12, 2013
NOTE: Any further information concerning final quantities, amounts or other details relative to this project may be found at Central Files in the electronic archives.	

QUALITY ASSURANCE PROGRAM: LEVEL I

CONVENTIONAL SYMBOLS	
COUNTY LINE	
TOWN LINE	
LIMITS OF ACCESS	
POINT OF ACCESS	
FENCE LINE	
STONE WALL	
TRAVELED WAY	
GUARD RAIL	
RAILROAD	
SURVEY LINE	
CULVERT	
POWER POLE	
TELEPHONE POLE	
TREES	
CONTROL OF ACCESS	
PROPERTY LINE	
R.O.W. TAKING LINE	
SLOPE RIGHTS	
TOP OF CUT	
TOE OF SLOPE	

SURVEYED BY :	NA
SURVEYED DATE :	NA
DATUM	
VERTICAL	NA
HORIZONTAL	NA

THESE PLANS ARE SUBJECT TO SUCH ENGINEERING CHANGES AS MAY BE REQUIRED BY THE FEDERAL HIGHWAY ADMINISTRATION OR THE DIRECTOR OF PROGRAM DEVELOPMENT.
CONSTRUCTION IS TO BE CARRIED ON IN ACCORDANCE WITH THESE PLANS AND THE STANDARD SPECIFICATIONS FOR CONSTRUCTION DATED 2006, AS APPROVED BY THE FEDERAL HIGHWAY ADMINISTRATION ON JUNE 15, 2006 FOR USE ON THIS PROJECT, INCLUDING ALL SUBSEQUENT REVISIONS AND SUCH REVISED SPECIFICATIONS AND SPECIAL PROVISIONS AS ARE INCORPORATED IN THESE PLANS.

DIRECTOR OF PROGRAM DEVELOPMENT	
APPROVED <i>Jan V. [Signature]</i>	DATE 12-5-2011
PROJECT MANAGER : C.P. WILLIAMS	
PROJECT NAME : BROOKFIELD	
PROJECT NUMBER : IM 089-(159)	
SHEET 1 OF 24 SHEETS	

02-DEC-2011