


DECK ELEVATION
(NOT TO SCALE)

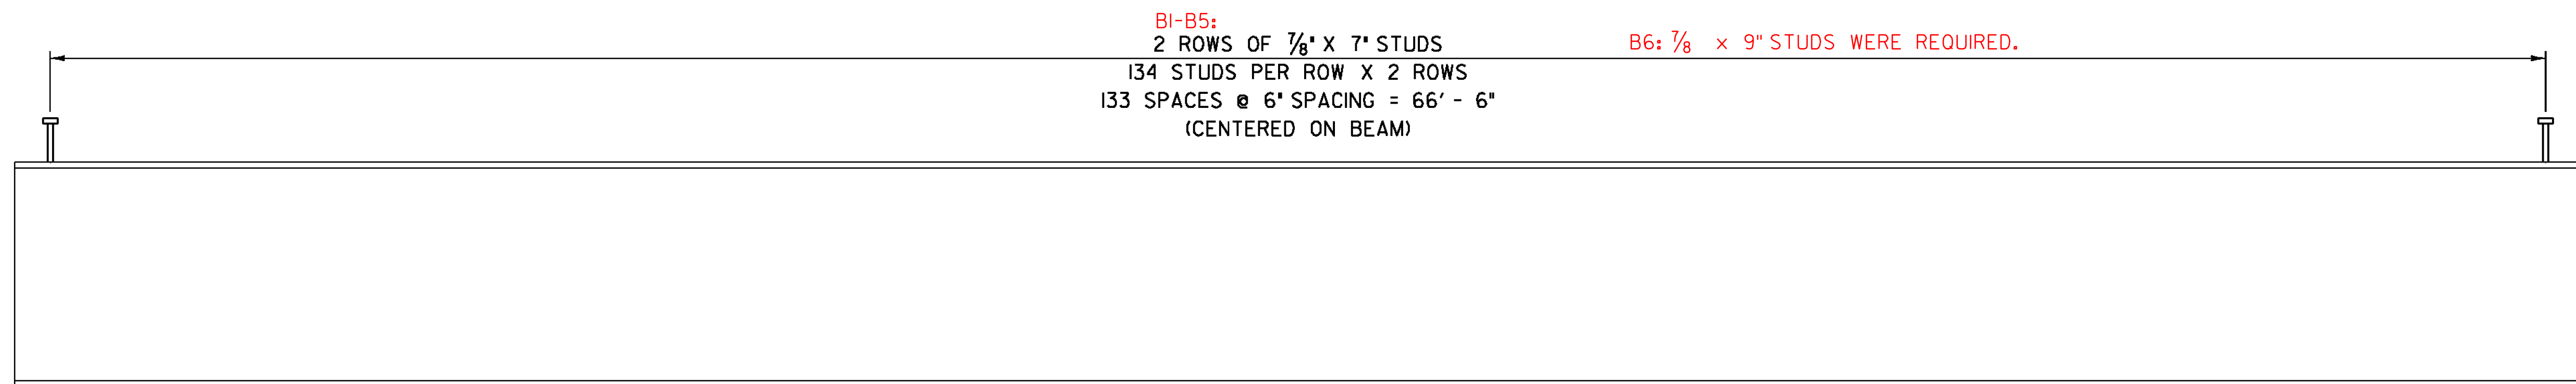

BEAM ELEVATION
(NOT TO SCALE)

PROJECT NAME: BROOKFIELD	PLOT DATE: 25-OCT-2011
PROJECT NUMBER: IM 089-1(59)	DRAWN BY: H.I. SALLS
FILE NAME: s10a074shear studs.dgn	CHECKED BY: R.S. YOUNG
PROJECT LEADER: C.P. WILLIAMS	SHEET 7 OF 24
DESIGNED BY: H.I. SALLS	
SHEAR CONNECTOR LAYOUT	