


ROADWAY PROJECT TYPICAL SECTION

I - 89 NORTHBOUND - M.M. 106.900 - M.M. 114.100
I - 89 SOUTHBOUND - M.M. 106.900 - M.M. 114.100

NOT TO SCALE


BRIDGES WITHIN THE PROJECT ARE:

- BRIDGE NUMBER 86N MM 107.461 (NO WORK REQUIRED)
- BRIDGE NUMBER 86S MM 107.461 (MICROSURFACE TREATMENT, TYPE III, LEVELING COURSE & MICROSURFACE TREATMENT, TYPE II, WEARING COURSE, REPLACE PLUG JOINTS)
- BRIDGE NUMBER 87N MM 111.351 (MICROSURFACE TREATMENT, TYPE III, LEVELING COURSE & MICROSURFACE TREATMENT, TYPE II, WEARING COURSE, REPLACE PLUG JOINTS)
- BRIDGE NUMBER 87S MM 111.351 (MICROSURFACE TREATMENT, TYPE III, LEVELING COURSE & MICROSURFACE TREATMENT, TYPE II, WEARING COURSE, REPLACE PLUG JOINTS)
- BRIDGE NUMBER 88N MM 113.747 (MICROSURFACE TREATMENT, TYPE III, LEVELING COURSE & MICROSURFACE TREATMENT, TYPE II, WEARING COURSE, REPLACE PLUG JOINTS)
- BRIDGE NUMBER 88S MM 113.747 (MICROSURFACE TREATMENT, TYPE III, LEVELING COURSE & MICROSURFACE TREATMENT, TYPE II, WEARING COURSE, REPLACE PLUG JOINTS)

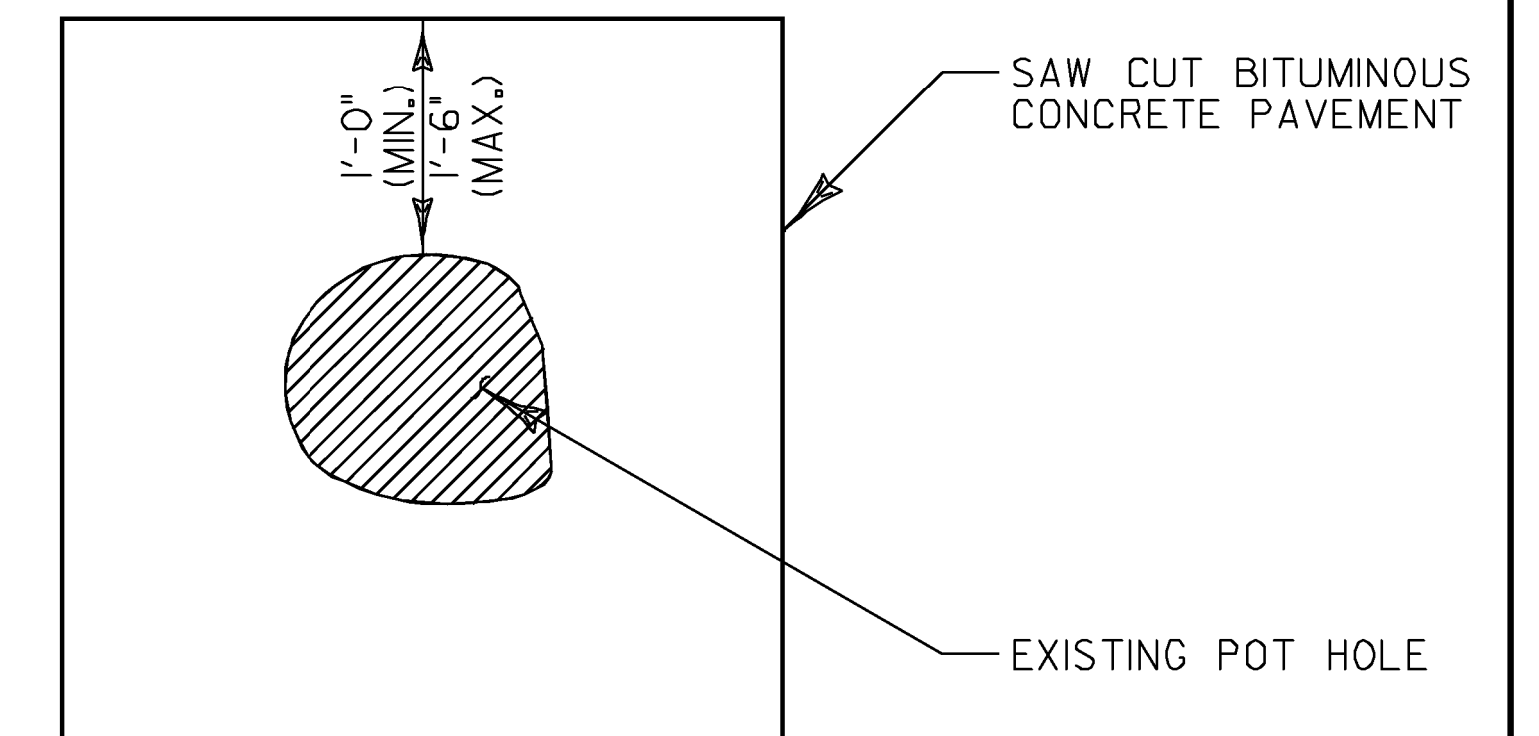


TYPICAL - POT HOLE REPAIR

NOT TO SCALE

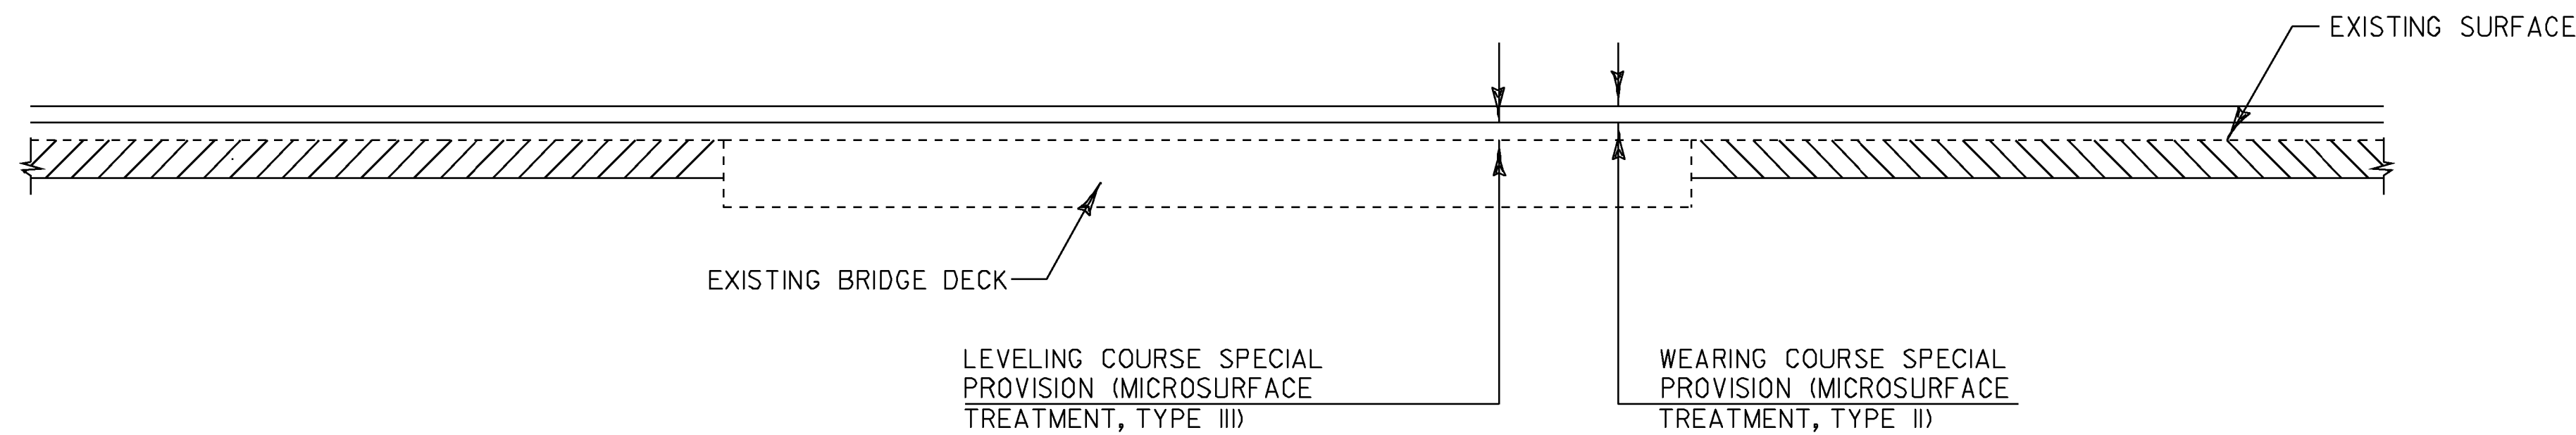

BRIDGE OVERLAY DETAIL

NOT TO SCALE

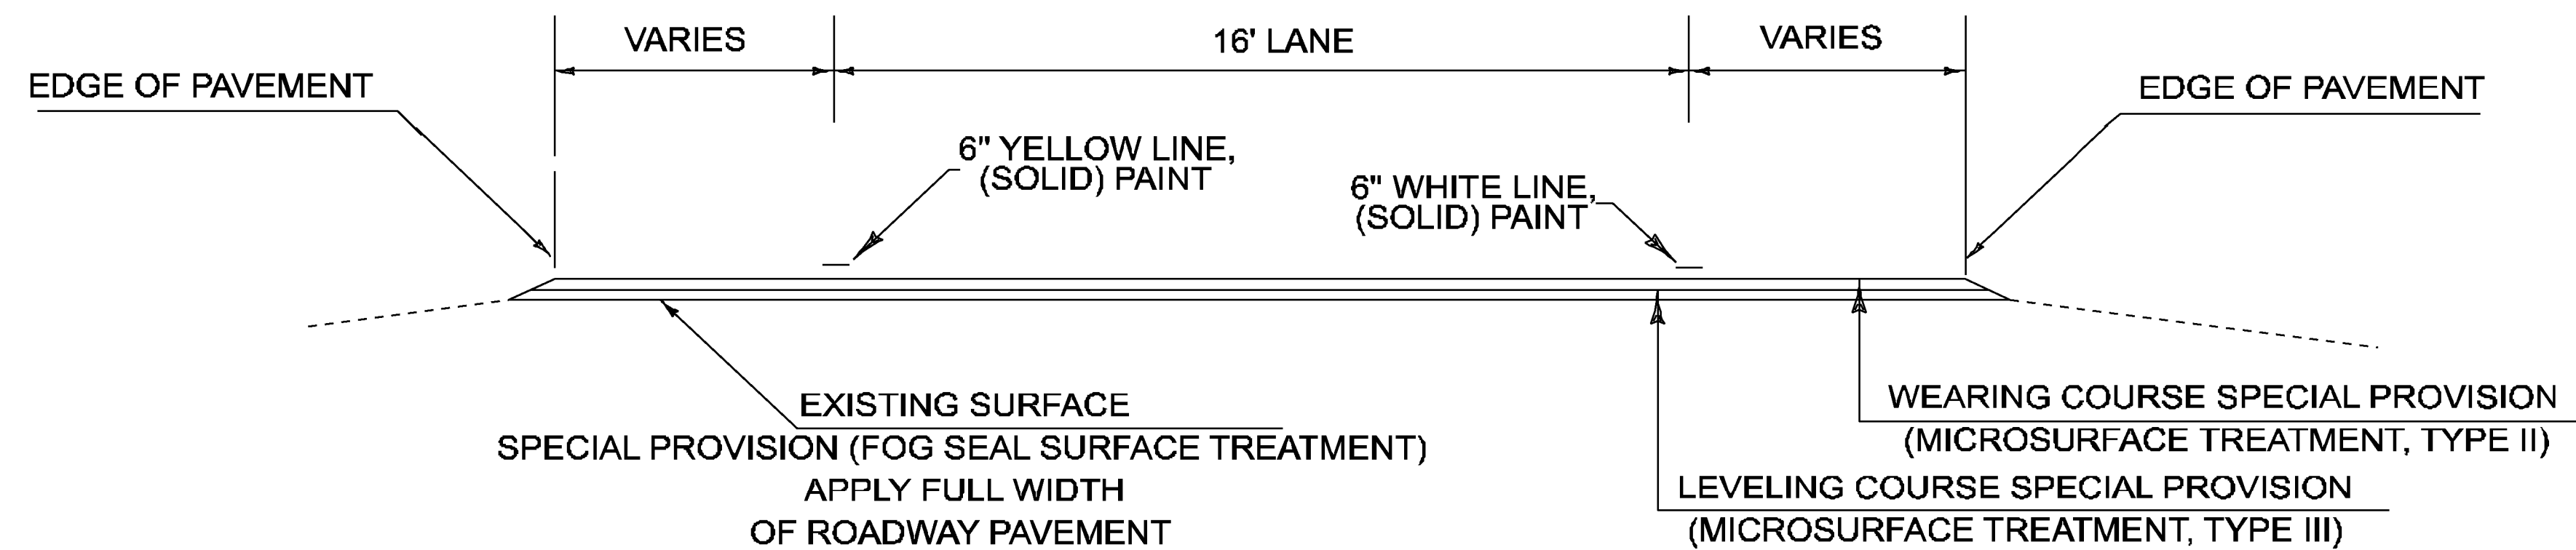

RAMP TYPICAL SECTION

NOT TO SCALE

**TYPICAL SECTION -
MICROSURFACE
TREATMENT,
TYPE II & III**

PROJECT NAME: GEORGIA - ST. ALBANS	
PROJECT NUMBER: IM SURF (2I)	
FILE NAME: I0a092\pi0a092.dgn	PLOT DATE: 27-JUL-2010
PROJECT LEADER: M. FOWLER	DRAWN BY: LOCKE
DESIGNED BY: LOCKE	CHECKED BY: PVMT MGMT
IPARM FILE NAME: pi0a092+yp.i	SHEET 3 OF 16