

646.214 6 INCH WHITE LINE  
 646.622 TEMPORARY 6 INCH WHITE LINE, PAINT

EXIT 24  
 NORTHBOUND OFF RAMP "C" SOLID RT EDGE LINE  
 NORTHBOUND OFF RAMP "C" DOTTED LANE LINE  
 NORTHBOUND ON RAMP "D" SOLID RT EDGE LINE  
 NORTHBOUND ON RAMP "D" DOTTED LANE LINE

646.215 6 INCH YELLOW LINE  
 646.632 TEMPORARY 6 INCH YELLOW LINE, PAINT

EXIT 24  
 NORTHBOUND OFF RAMP "C" SOLID LT EDGE LINE  
 NORTHBOUND ON RAMP "D" SOLID LT EDGE LINE

646.24 12 INCH WHITE LINE  
 646.662 TEMPORARY 12 INCH WHITE LINE, PAINT

EXIT 24  
 NORTHBOUND OFF RAMP "C" SOLID LT GORE AREA  
 NORTHBOUND ON RAMP "D" SOLID LT GORE AREA

646.25 12 INCH YELLOW LINE  
 646.672 TEMPORARY 12 INCH YELLOW LINE, PAINT


EXIT 24  
 NORTHBOUND OFF RAMP "C" @ VT RTE I22 SOLID LT

646.30 LETTER OR SYMBOL  
 646.692 TEMPORARY LETTER OR SYMBOL, PAINT




EXIT 24  
 NORTHBOUND OFF RAMP "C" "STOP AHEAD"  
 NORTHBOUND OFF RAMP "C" @ VT RTE I22 "STOP"  
 NORTHBOUND OFF RAMP "C" →

646.26 24 INCH STOP BAR  
 646.682 TEMPORARY 24 INCH STOP BAR, PAINT

EXIT 24  
 NORTHBOUND OFF RAMP "C" @ VT RTE I22

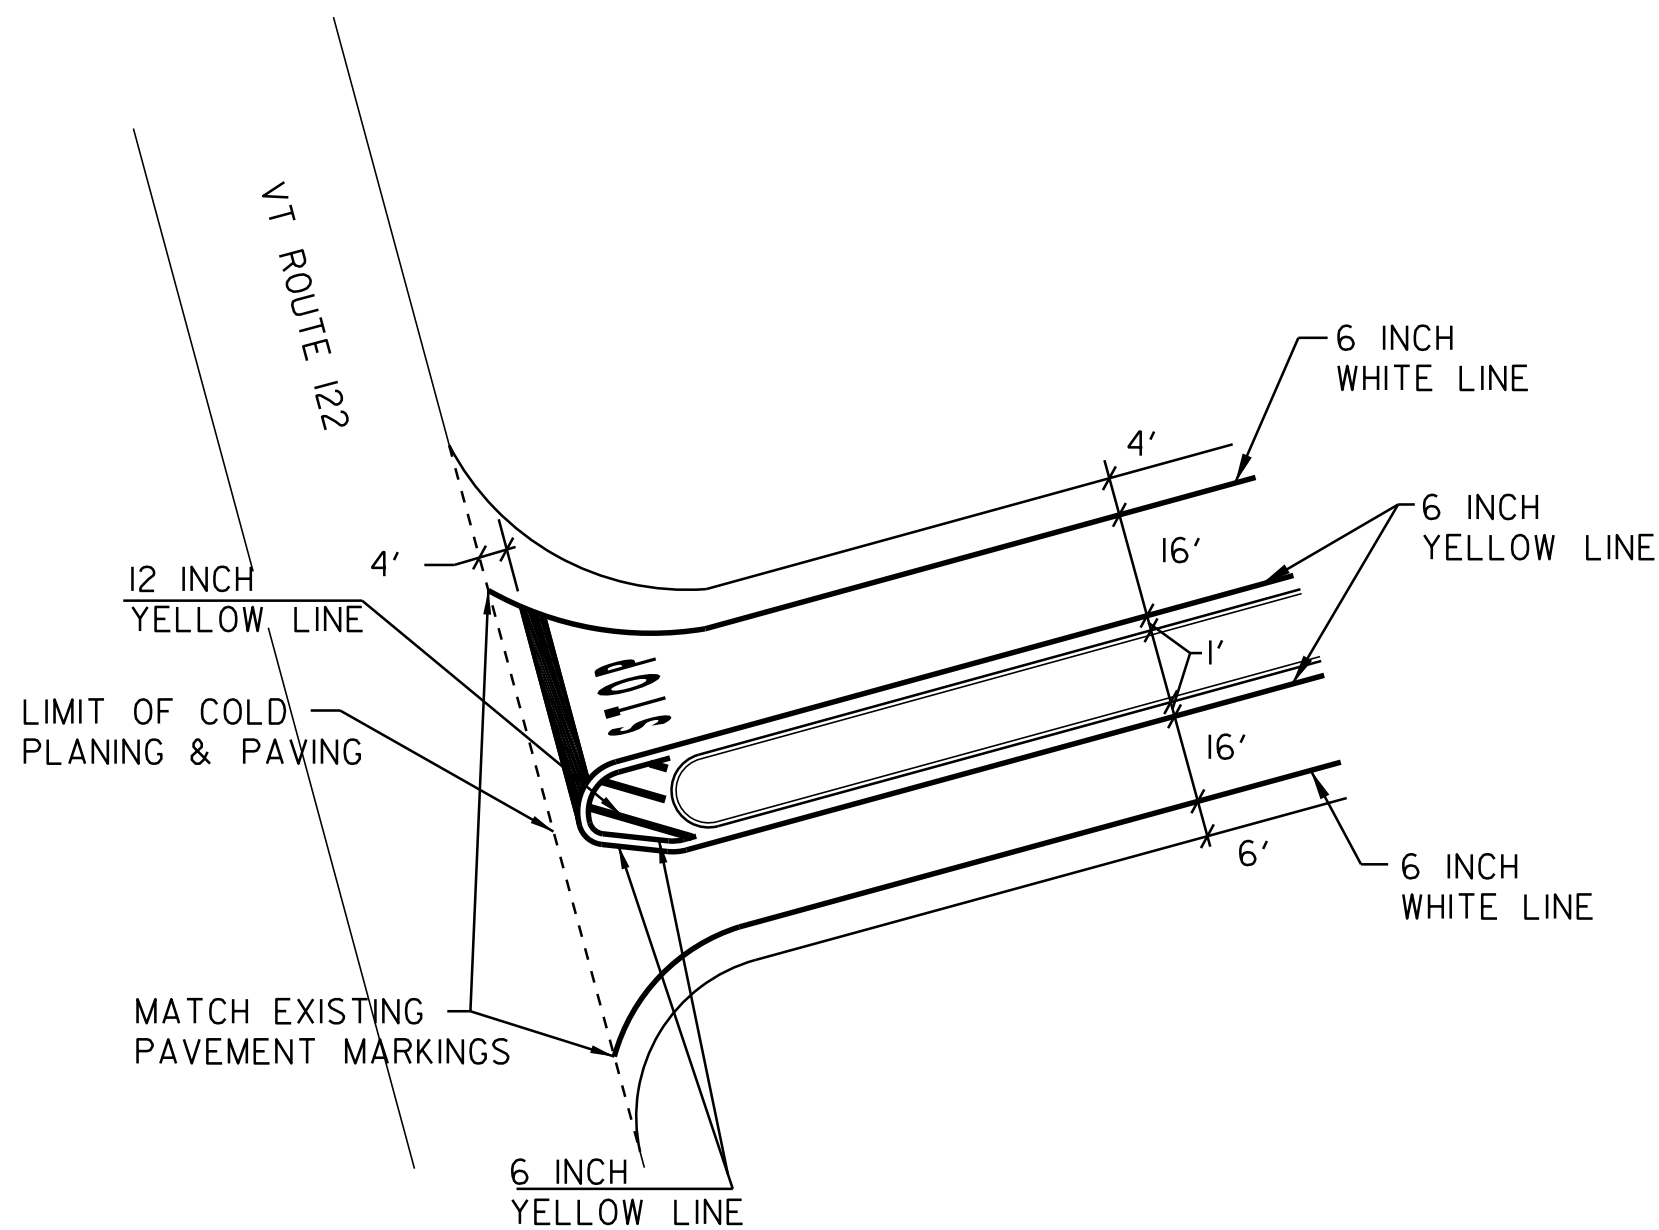

**NOTES:**  
 1. TWO (2) APPLICATIONS OF FINAL PAVEMENT MARKINGS WILL BE REQUIRED. THE FIRST APPLICATION WILL BE IMMEDIATELY FOLLOWING PLACEMENT OF THE SURFACE TREATMENT. THE SECOND AND FINAL APPLICATION WILL BE APPLIED NO SOONER THAN 14 CALENDER DAYS AFTER THE FIRST APPLICATION, AND NO LATER THAN OCT. 14, 2011.

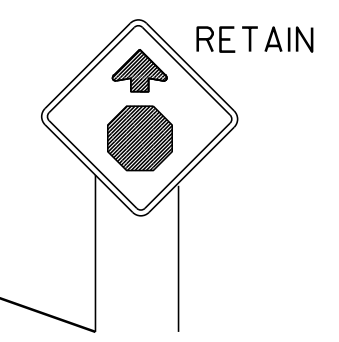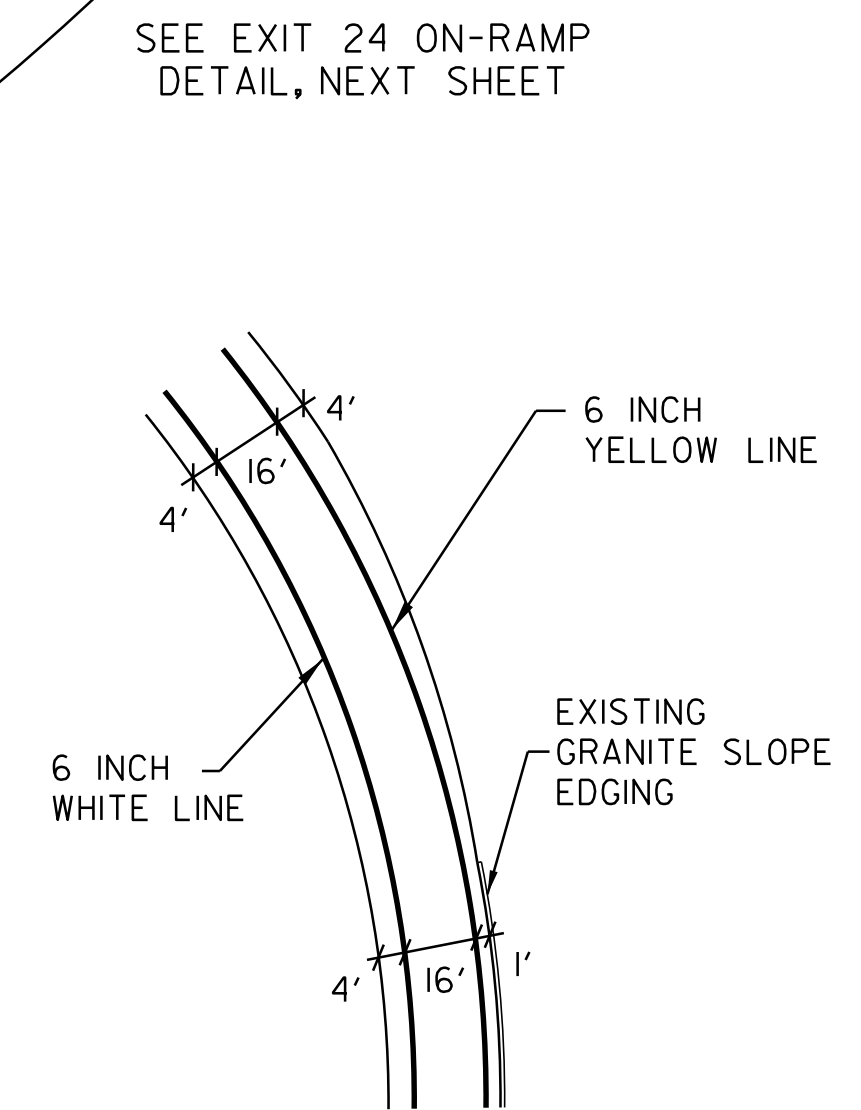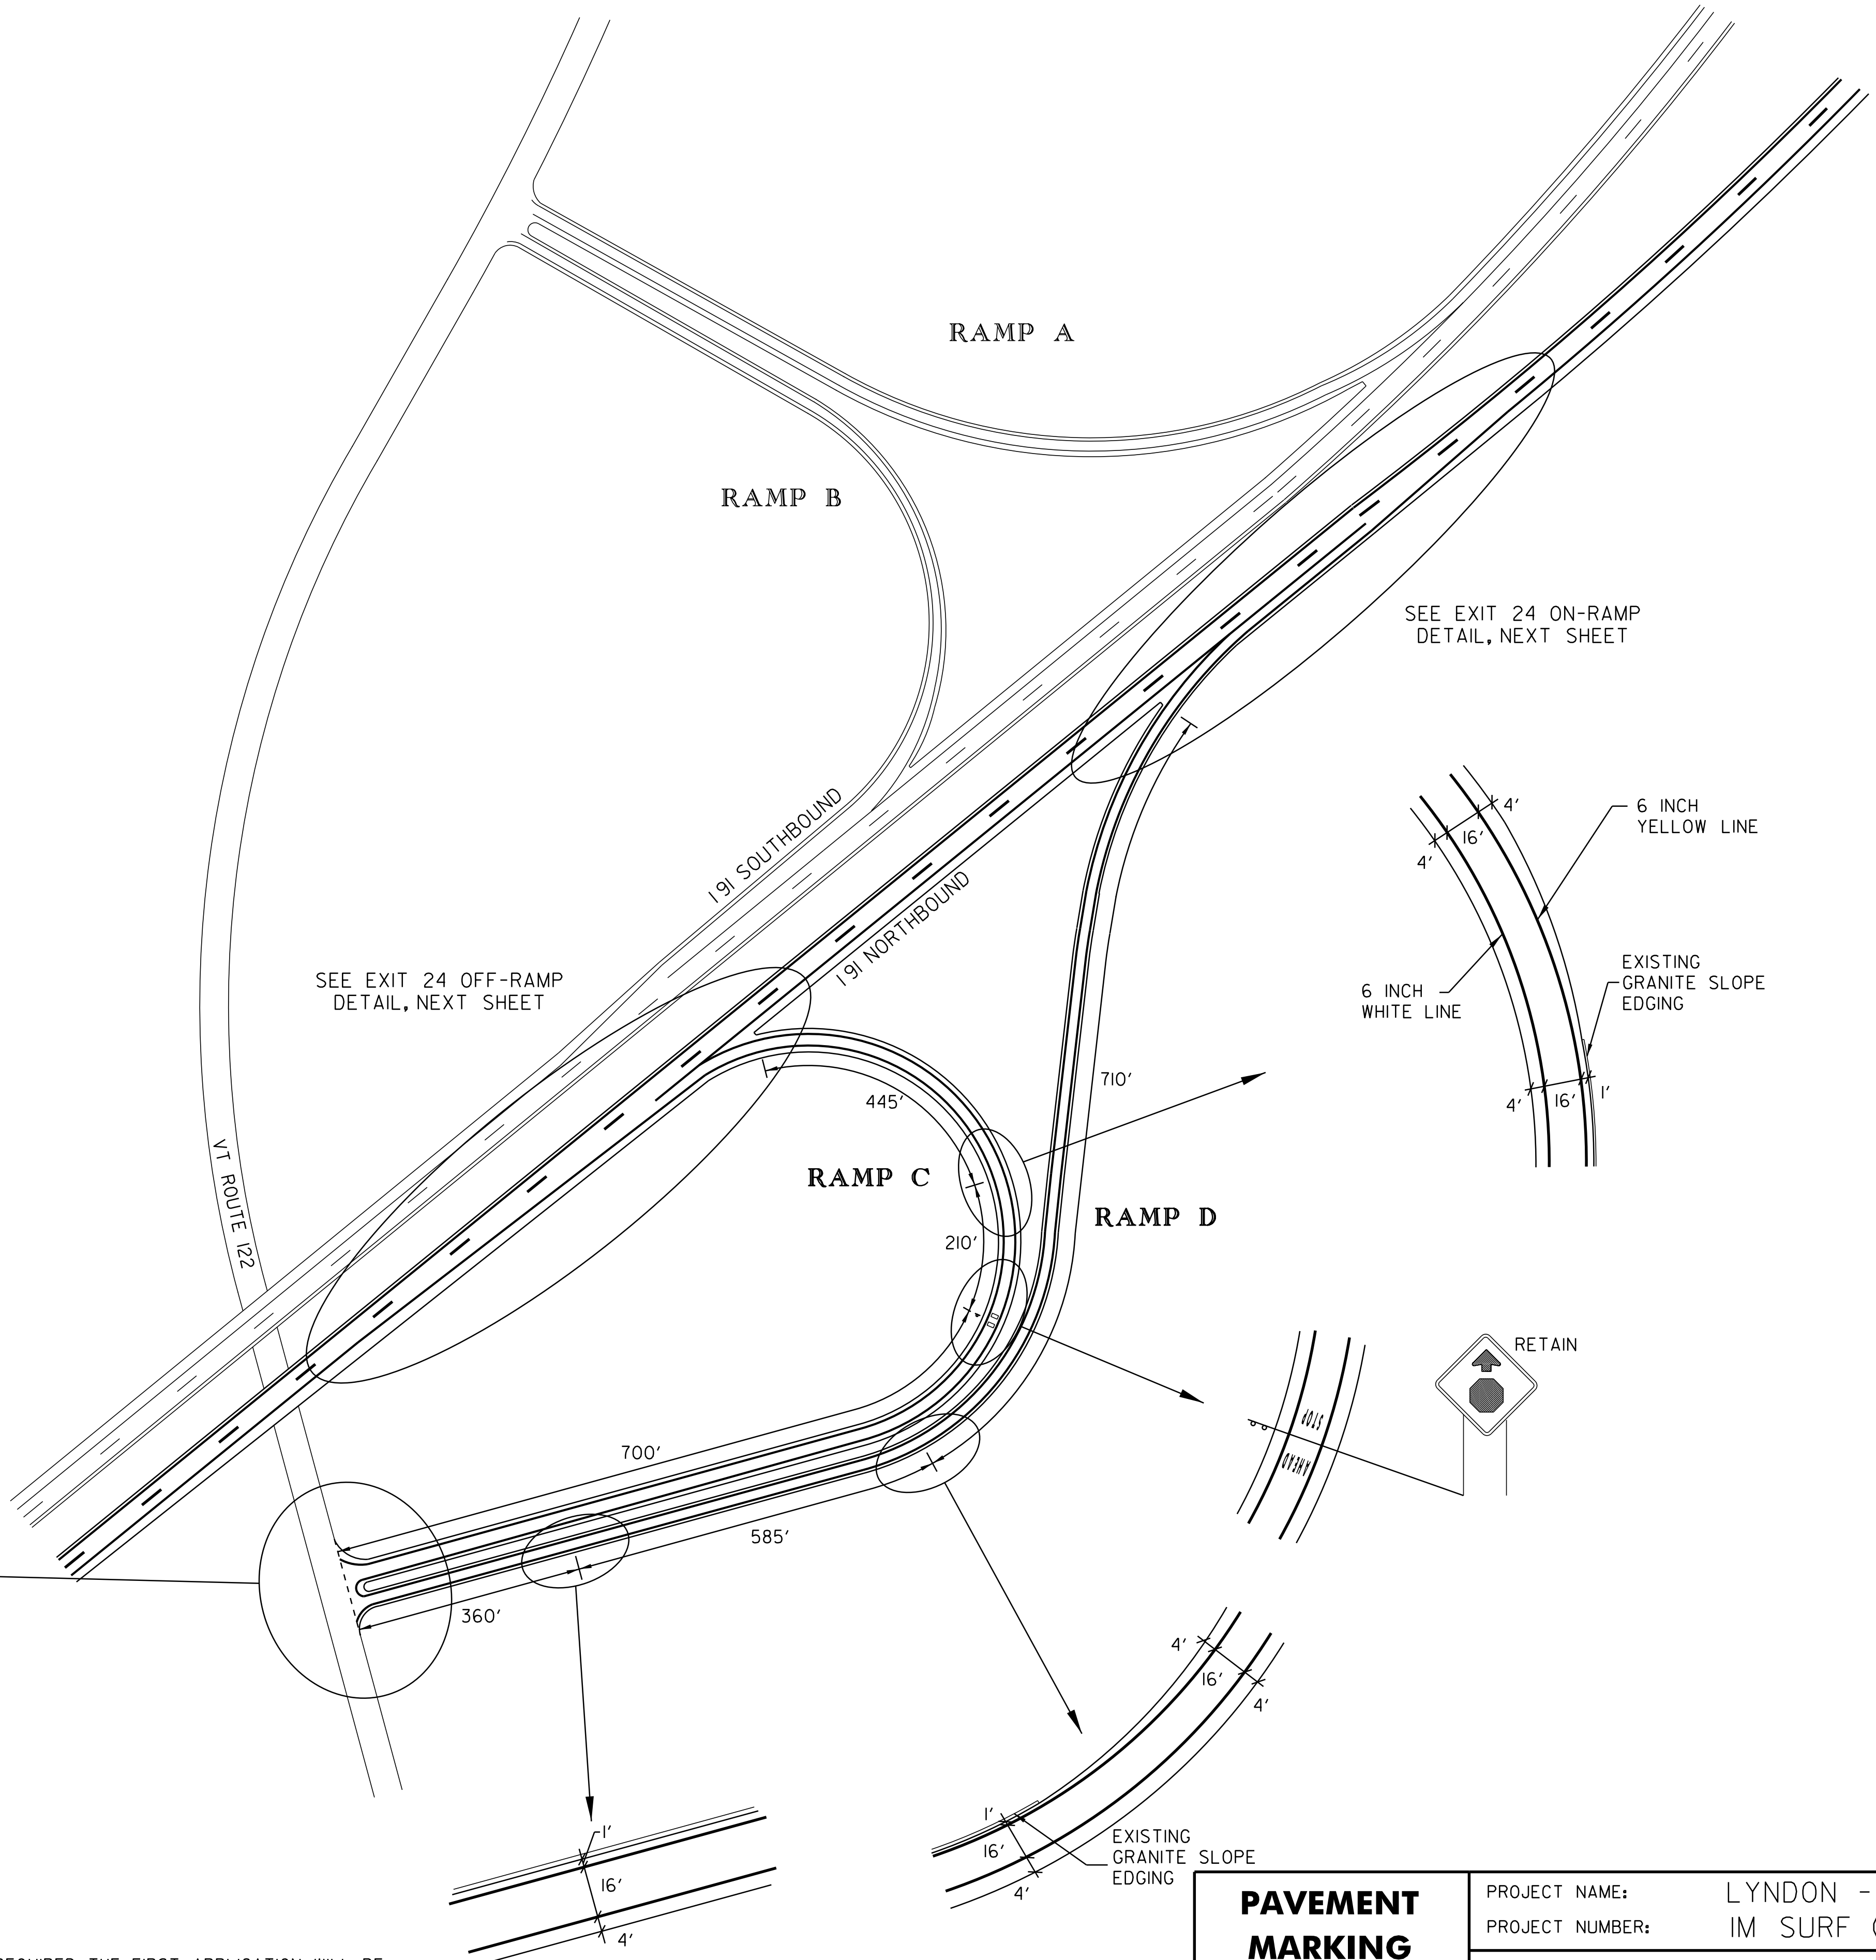

<b>PAVEMENT MARKING DETAIL SHEET 1 EXIT 24</b>	PROJECT NAME:	LYNDON - BARTON
	PROJECT NUMBER:	IM SURF (25)
	FILE NAME: pi0a120.dgn	PLOT DATE: 11-JUN-2012 11:44
	PROJECT LEADER: M. FOWLER	DRAWN BY: LOCKE
DESIGNED BY: LOCKE	CHECKED BY: PAVT MGMT	
IPARM FILE NAME: pi0a120pmd3.i	SHEET 10	OF 18