



EXIT 24 OFF-RAMP DETAIL

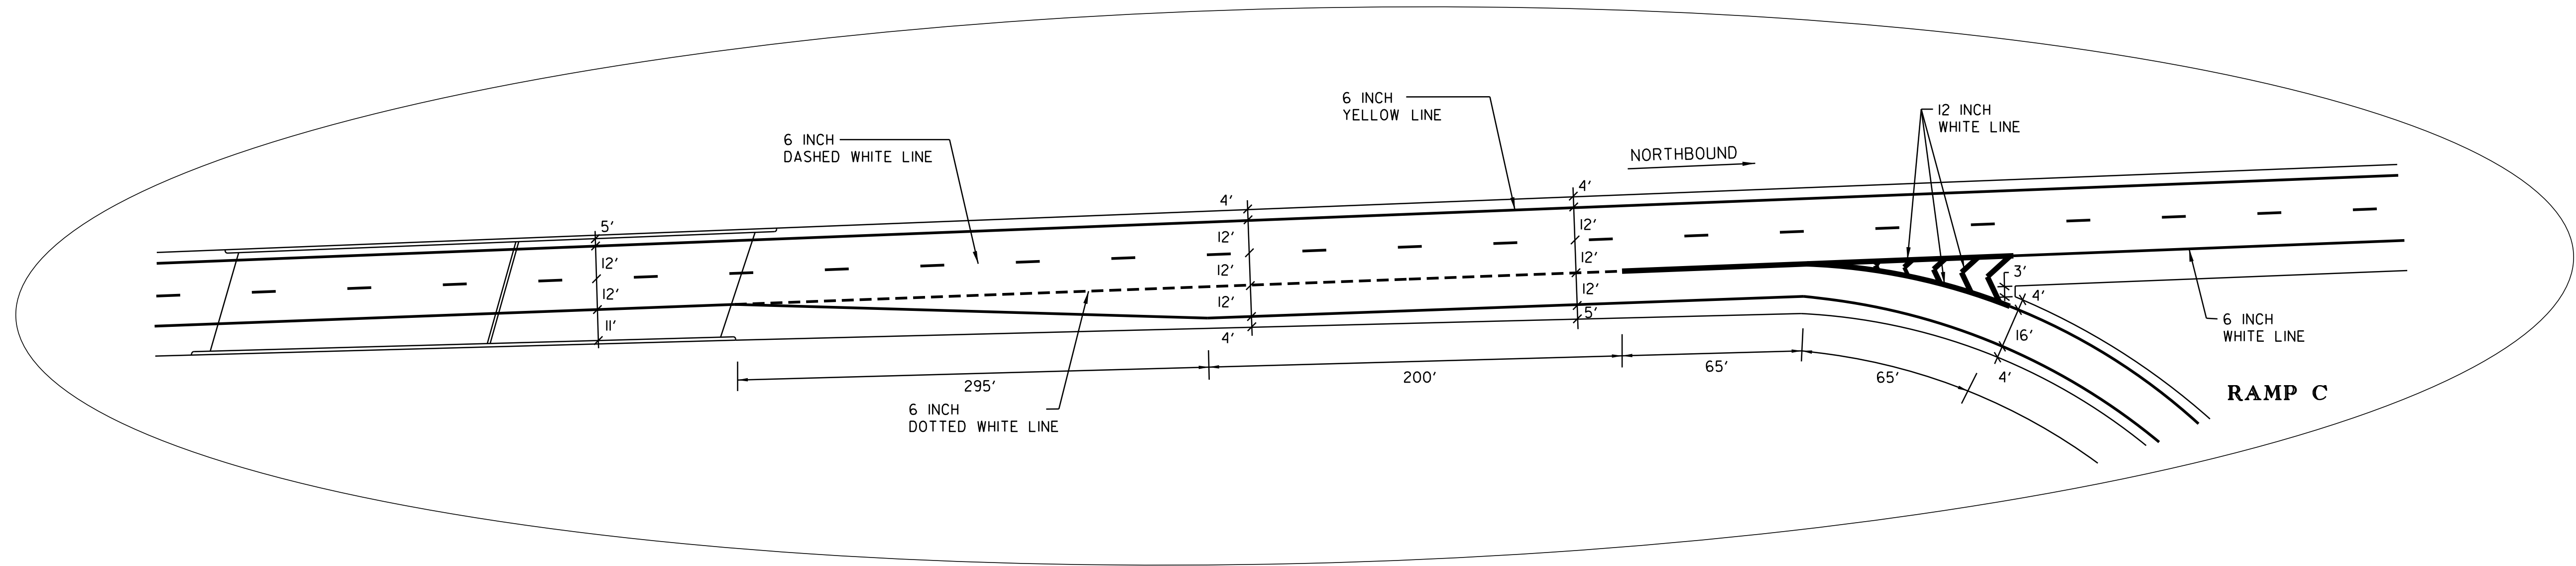

EXIT 24 ON-RAMP DETAIL

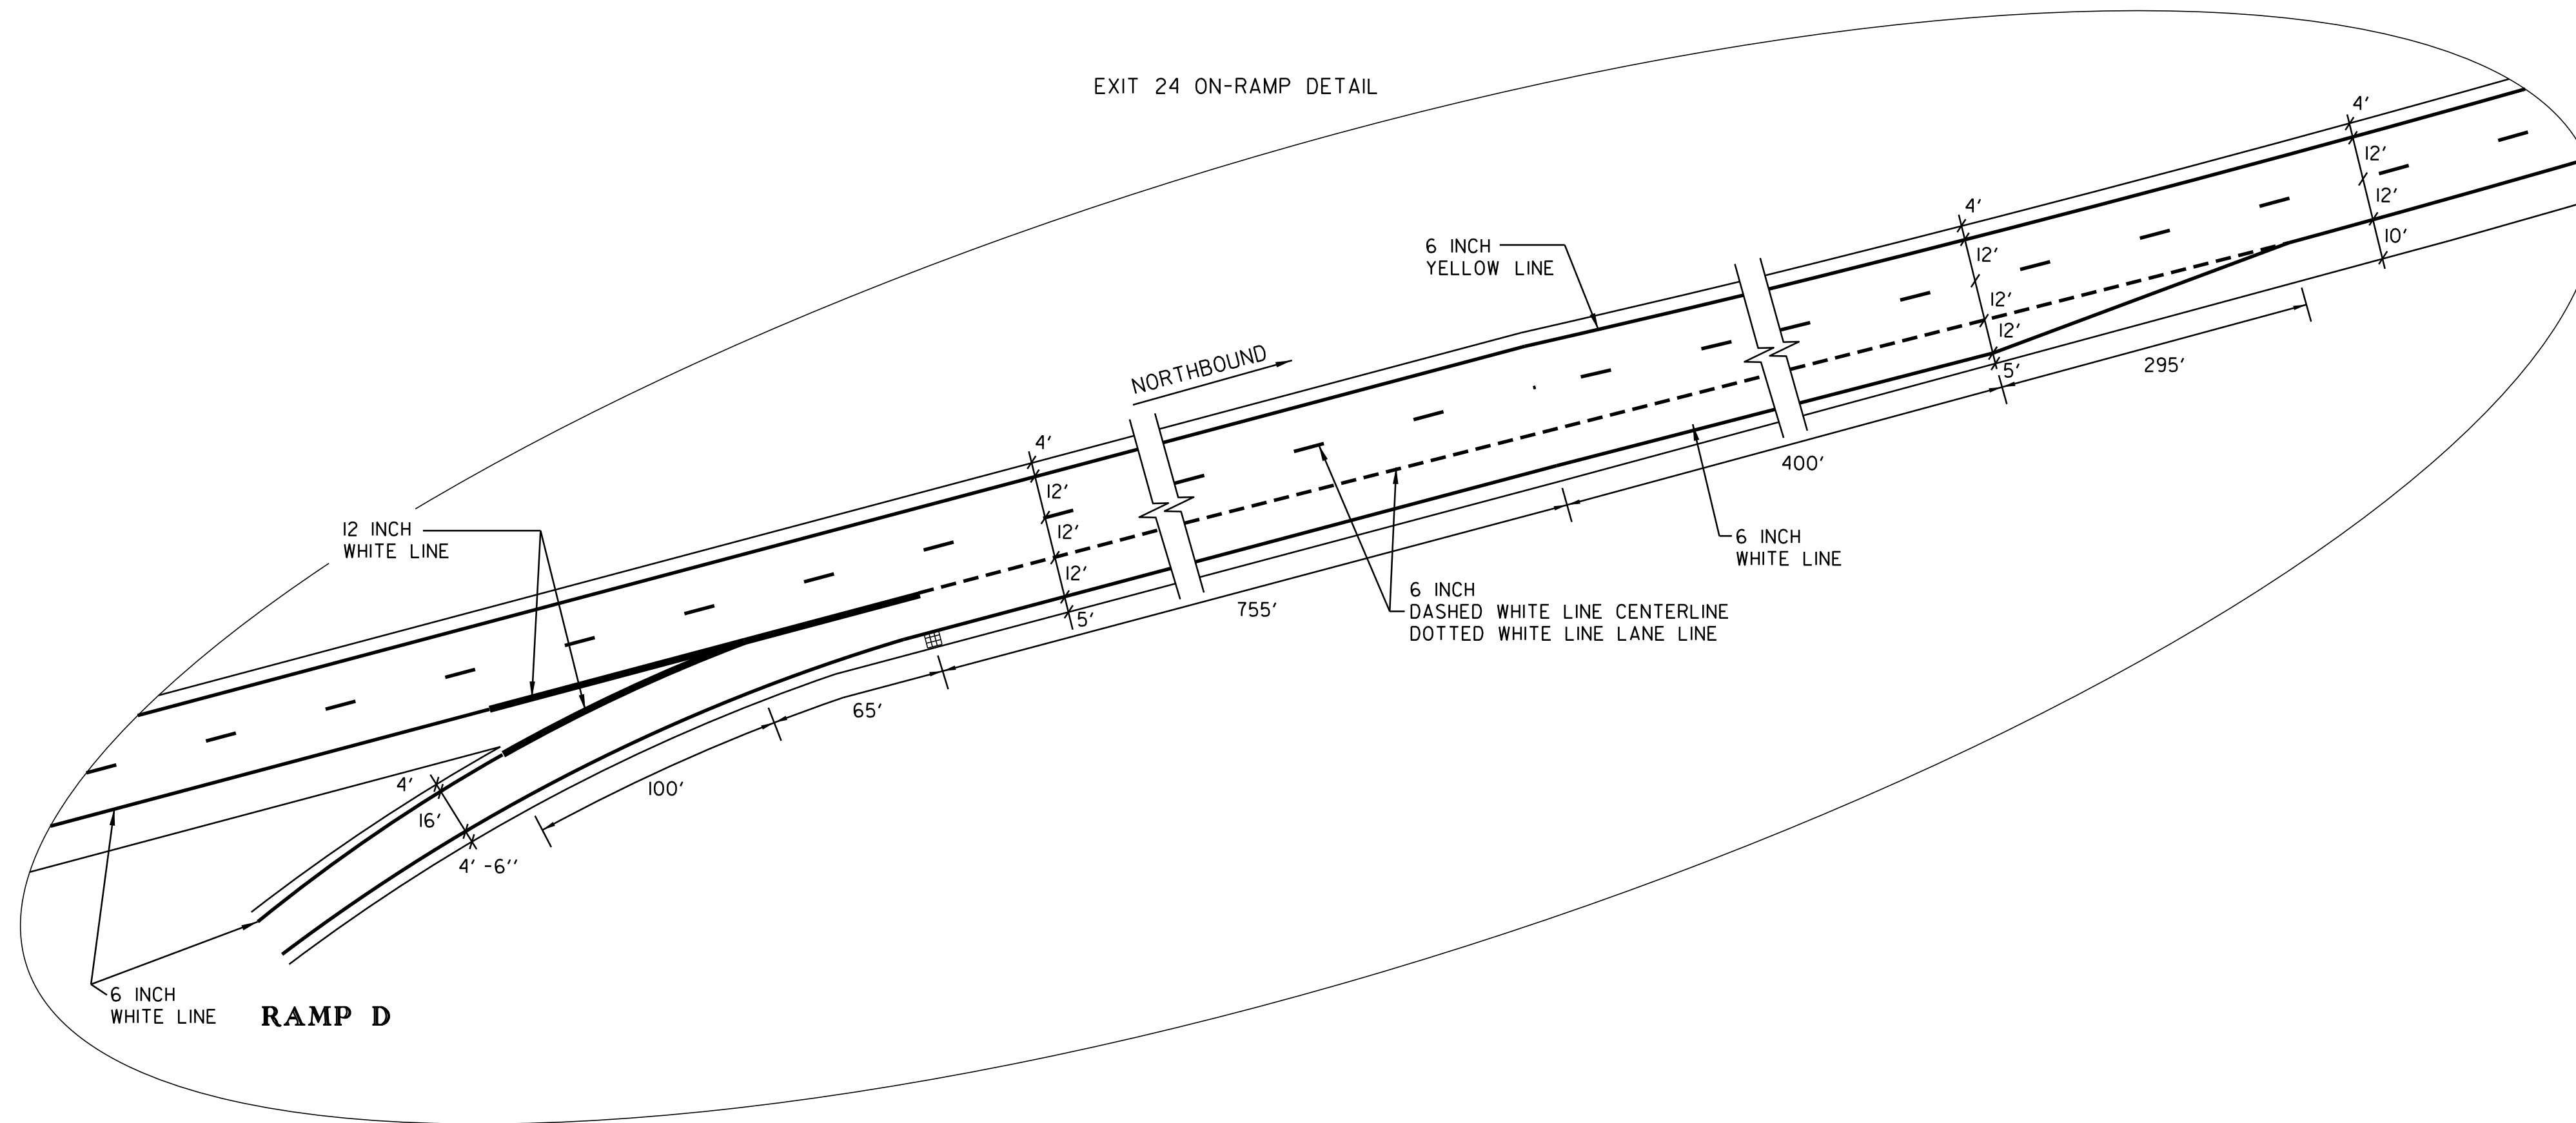

**NOTES:**

I. TWO (2) APPLICATIONS OF FINAL PAVEMENT MARKINGS WILL BE REQUIRED. THE FIRST APPLICATION WILL BE IMMEDIATELY FOLLOWING PLACEMENT OF THE SURFACE TREATMENT, THE SECOND AND FINAL APPLICATION WILL BE APPLIED NO SOONER THAN 14 CALENDER DAYS AFTER THE FIRST APPLICATION, AND NO LATER THAN OCT. 14, 2011.

|  |                                |                              |
|--|--------------------------------|------------------------------|
| <b>PAVEMENT<br/>MARKING<br/>DETAIL SHEET 2<br/>EXIT 24</b> | PROJECT NAME:                  | LYNDON - BARTON              |
|  | PROJECT NUMBER:                | IM SURF (25)                 |
|  | FILE NAME: p10a120.dgn         | PLOT DATE: 11-JUN-2012 11:44 |
|  | PROJECT LEADER: M. FOWLER      | DRAWN BY: LOCKE              |
|  | DESIGNED BY: LOCKE             | CHECKED BY: PAVT MGMT        |
|  | IPARM FILE NAME: p10a120pmd4.i | SHEET 11 OF 18               |