


**RAMP A**

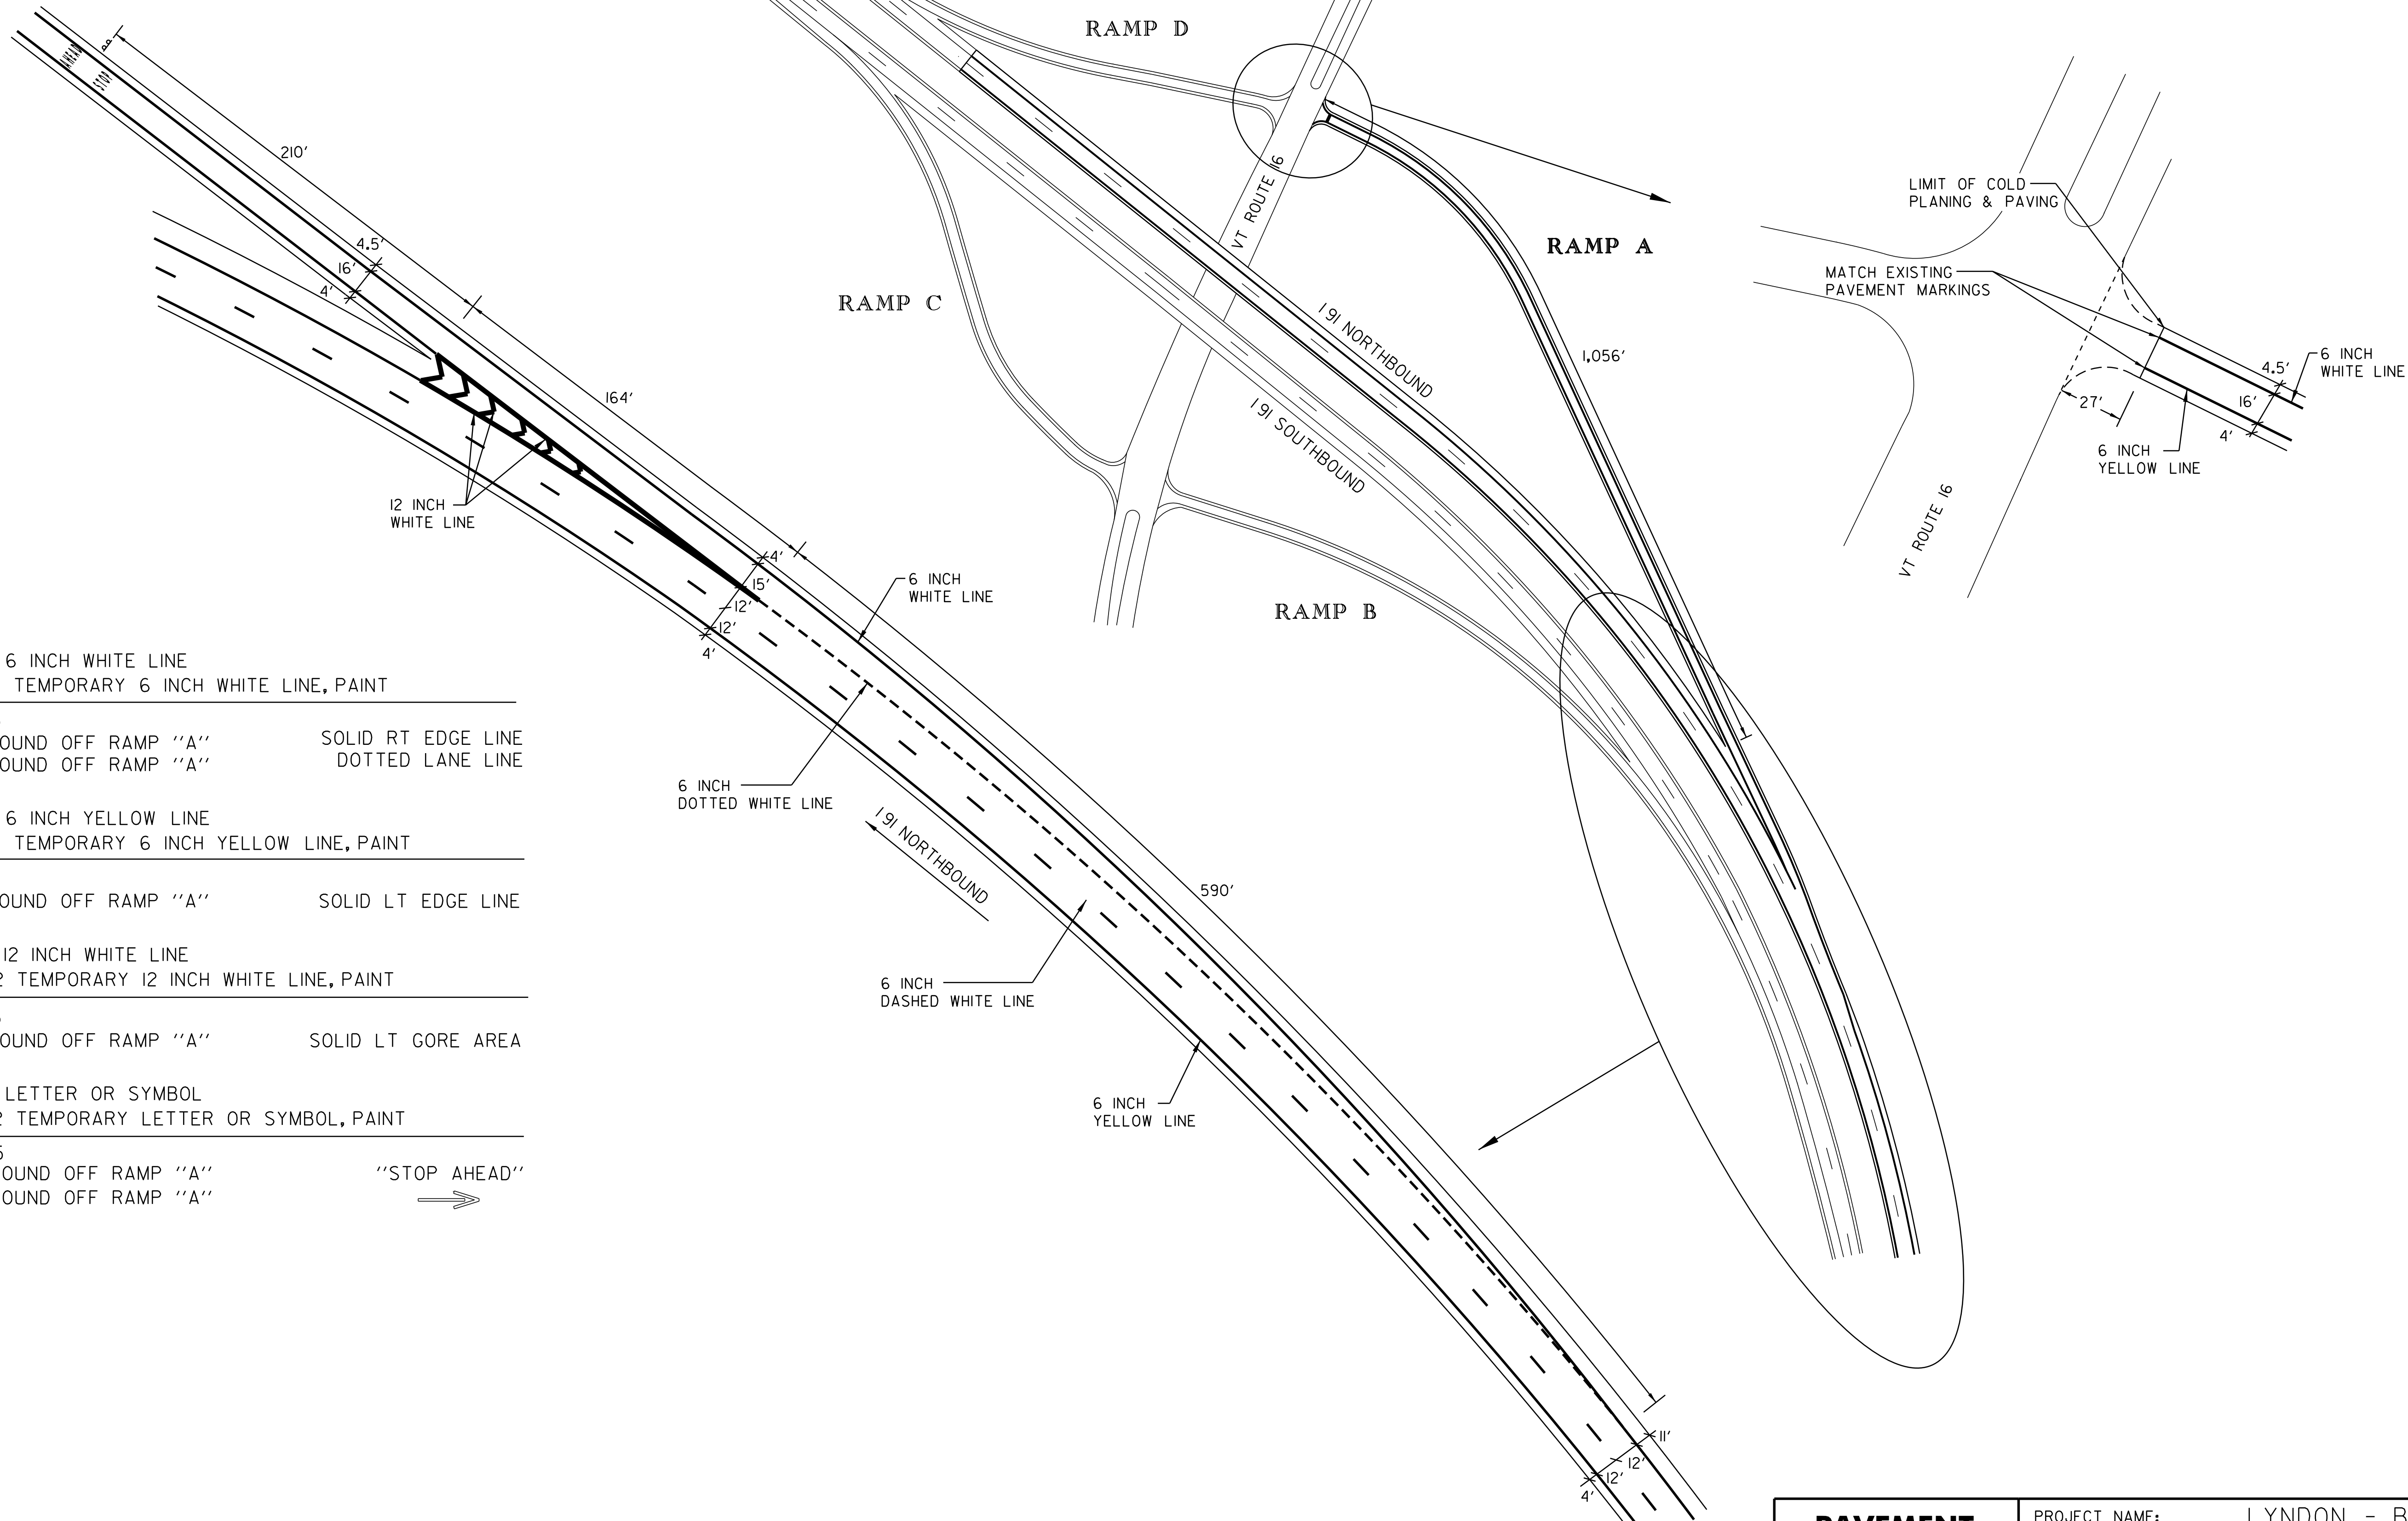

- 646.214 6 INCH WHITE LINE
- 646.622 TEMPORARY 6 INCH WHITE LINE, PAINT

---

- EXIT 25
- NORTHBOUND OFF RAMP "A"      SOLID RT EDGE LINE
- NORTHBOUND OFF RAMP "A"      DOTTED LANE LINE

---

- 646.215 6 INCH YELLOW LINE
- 646.632 TEMPORARY 6 INCH YELLOW LINE, PAINT

---

- EXIT 25
- NORTHBOUND OFF RAMP "A"      SOLID LT EDGE LINE

---

- 646.24 12 INCH WHITE LINE
- 646.662 TEMPORARY 12 INCH WHITE LINE, PAINT

---

- EXIT 25
- NORTHBOUND OFF RAMP "A"      SOLID LT GORE AREA

---

- 646.30 LETTER OR SYMBOL
- 646.692 TEMPORARY LETTER OR SYMBOL, PAINT

---

- EXIT 25
- NORTHBOUND OFF RAMP "A"      "STOP AHEAD"
- NORTHBOUND OFF RAMP "A"      ➡

**NOTES:**

I. TWO (2) APPLICATIONS OF FINAL PAVEMENT MARKINGS WILL BE REQUIRED. THE FIRST APPLICATION WILL BE IMMEDIATELY FOLLOWING PLACEMENT OF THE SURFACE TREATMENT, THE SECOND AND FINAL APPLICATION WILL BE APPLIED NO SOONER THAN 14 CALENDER DAYS AFTER THE FIRST APPLICATION, AND NO LATER THAN OCT. 14, 2011.

<b>PAVEMENT MARKING DETAIL SHEET EXIT 25</b>	PROJECT NAME:	LYNDON - BARTON
	PROJECT NUMBER:	IM SURF (25)
	FILE NAME: pi0a120.dgn	PLOT DATE: 11-JUN-2012 11:45
	PROJECT LEADER: M. FOWLER	DRAWN BY: LOCKE
DESIGNED BY: LOCKE	CHECKED BY: PAVT MGMT	
IPARM FILE NAME: pi0a120pmd5.i	SHEET 12 OF 18	