

PLAN

**NOTES**  
 1. ELEVATION DATUM SEA LEVEL BASED ON NEAREST U.S. GOVERNMENT VERTICAL CONTROL.  
 2. FOR ADDITIONAL NOTES SEE SCB-DI-62.  
 3. APPROACH SLABS SHALL BE CONSTRUCTED AS PART OF STAGE 1 CONSTRUCTION.


- LIST OF SHEETS**
- BA 200 - PLAN AND ELEVATION
  - 201 - BRIDGE QUANTITY SHEET
  - 202 - PRELIMINARY INFORMATION SHEET
  - 203, 204, 205 - BORINGS
  - 206 - SLAB DETAILS
  - 207 - FRAMING PLAN
  - 208 - FLOOR BEAM & BRACING DETAILS
  - 209 - BRACING DETAILS
  - 210 - BRIDGE RAILING DETAILS
  - 211, 212 - EXPANSION DAM DETAILS
  - 213 - HEATING DEVICE DETAILS
  - 214 - ABUTMENTS NO. 1, 2, & 4
  - 215 - PIERS 1 & 2 DETAILS
  - 216 - REINFORCING STEEL SCHEDULES
  - BA 217-222 - CHANNEL SECTIONS

- STANDARD SHEETS**
- G-3A
  - SCB-D6-62, DETAILS A & B
  - SCB-DI-62, GENERAL NOTES
  - 9B-R1-G4, Sheets 1 & 2 of 2

**Allowable Unit Stresses**

$f_c = 3000 \text{ psi}$   
 $f_s = 12,000 \text{ psi}$   
 $f_p = 20,000 \text{ psi}$

WESTMINSTER-NORWICH  
 IM BPNT (B)  
 SHEET 18 OF 58  
 BRIDGE 40  
 FOR REFERENCE ONLY

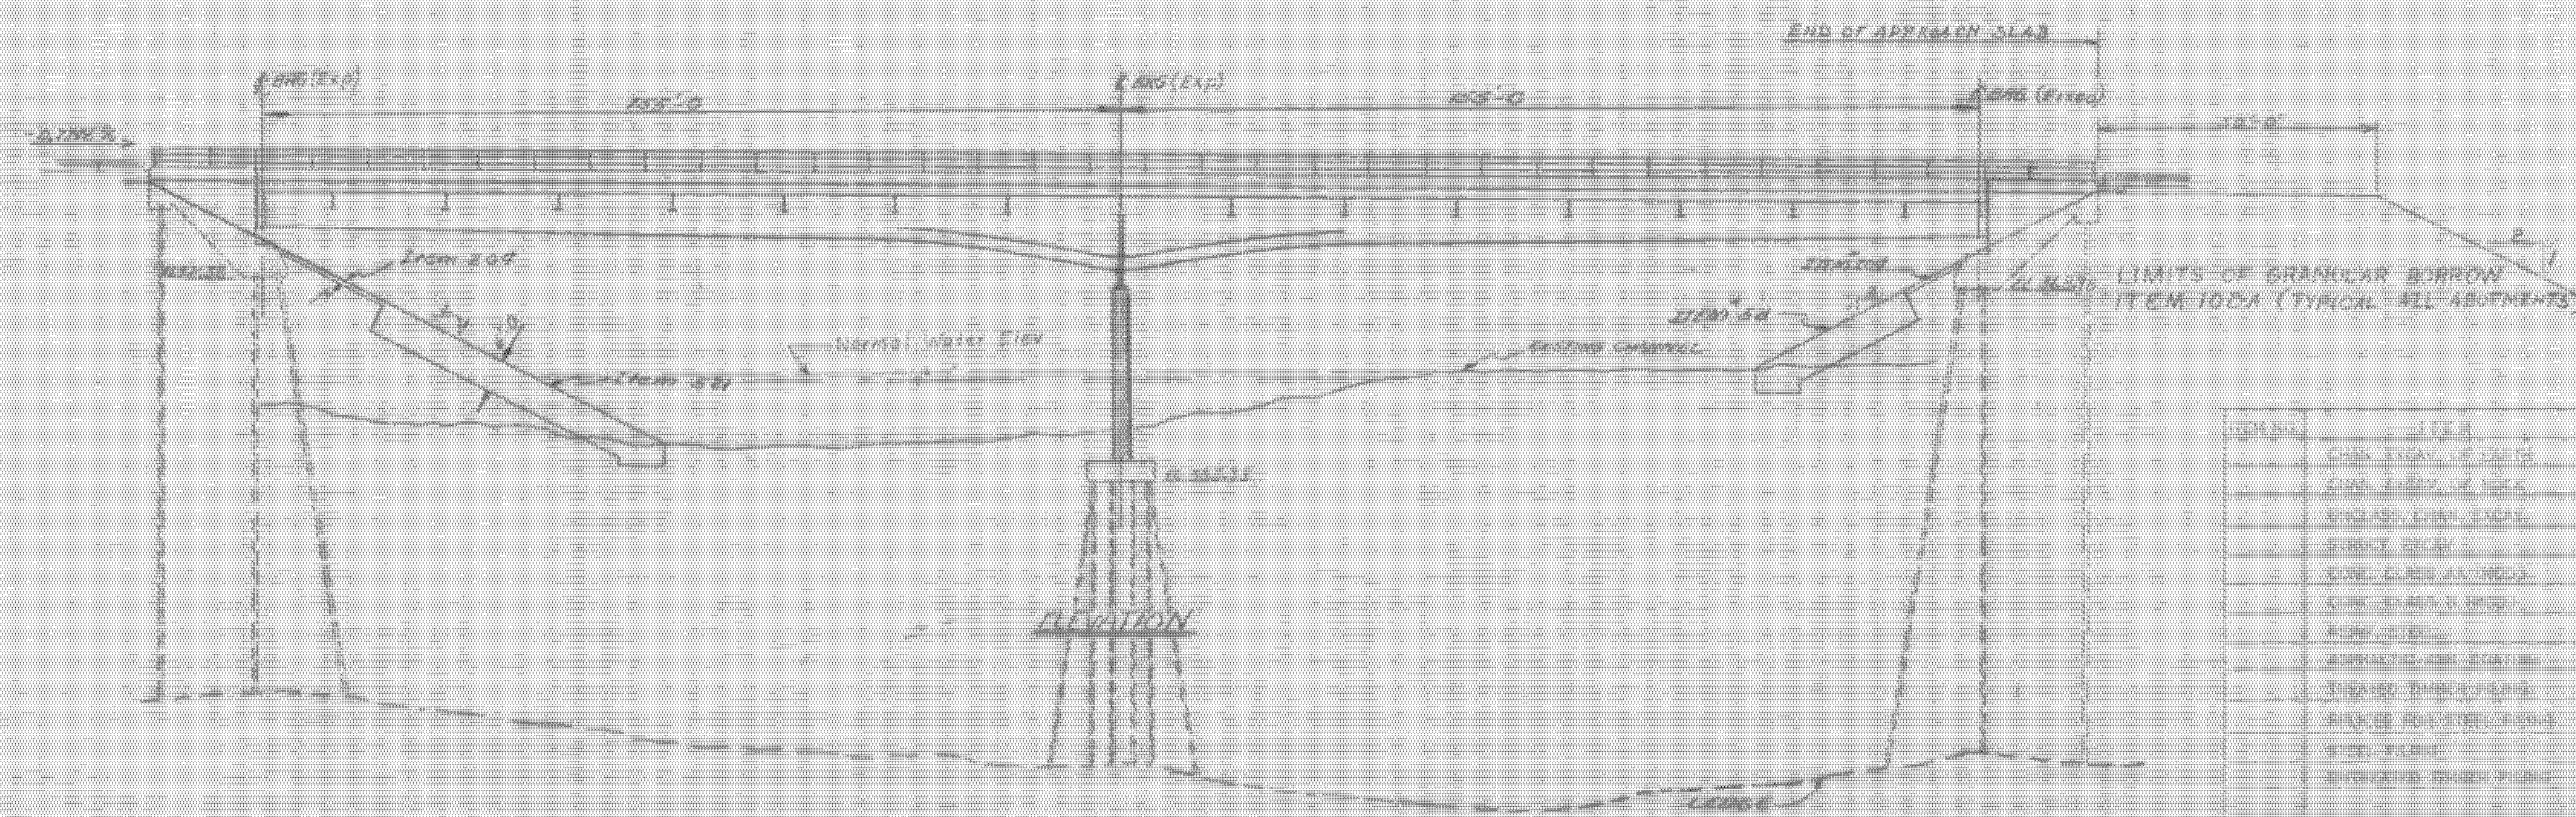

ELEVATION

Revisions  
 #1 Scuppers added to Plan  
 4-11-66 W. Tripp

ITEM NO.	ITEM	QTY	UNIT	TOTAL	PAID
	CONC. TRAY OF PARTS		C.Y.		
	CONC. TRAY OF RISE		C.Y.		
	CONCRETE TRAY, EXCAV.		C.Y.		
	STEEL TRAY		C.Y.		
	CONC. CLASS 1 (1000)		C.Y.		
	CONC. CLASS 2 (1000)		C.Y.		
	FORM STEEL		LB		
	BRIDGE TRAY BOARD		C.Y.		
	TRAY BOARD BOARD		C.Y.		
	BRIDGE TRAY BOARD		LB		
	STEEL TRAY		C.Y.		
	BRIDGE TRAY BOARD		C.Y.		

BR 200 OF 222

STATE OF VERMONT  
 DEPARTMENT OF HIGHWAYS

TOWN OF HARTLAND - HARTFORD

ROAD NO. \_\_\_\_\_ BRIDGE NO. \_\_\_\_\_

PLAN & ELEVATION

2-71 OVER THE OTTAUQUECHEE RIVER

SCALE 1" = 20'-0"

SURVEYED BY: JENETT

DRAWN BY: S.H.S. CHECKED BY: A.G.C.

PROJECT NO. 1-91-10-100-1 (31)

SHEET 57 OF 103 Sheets 101 to 242