
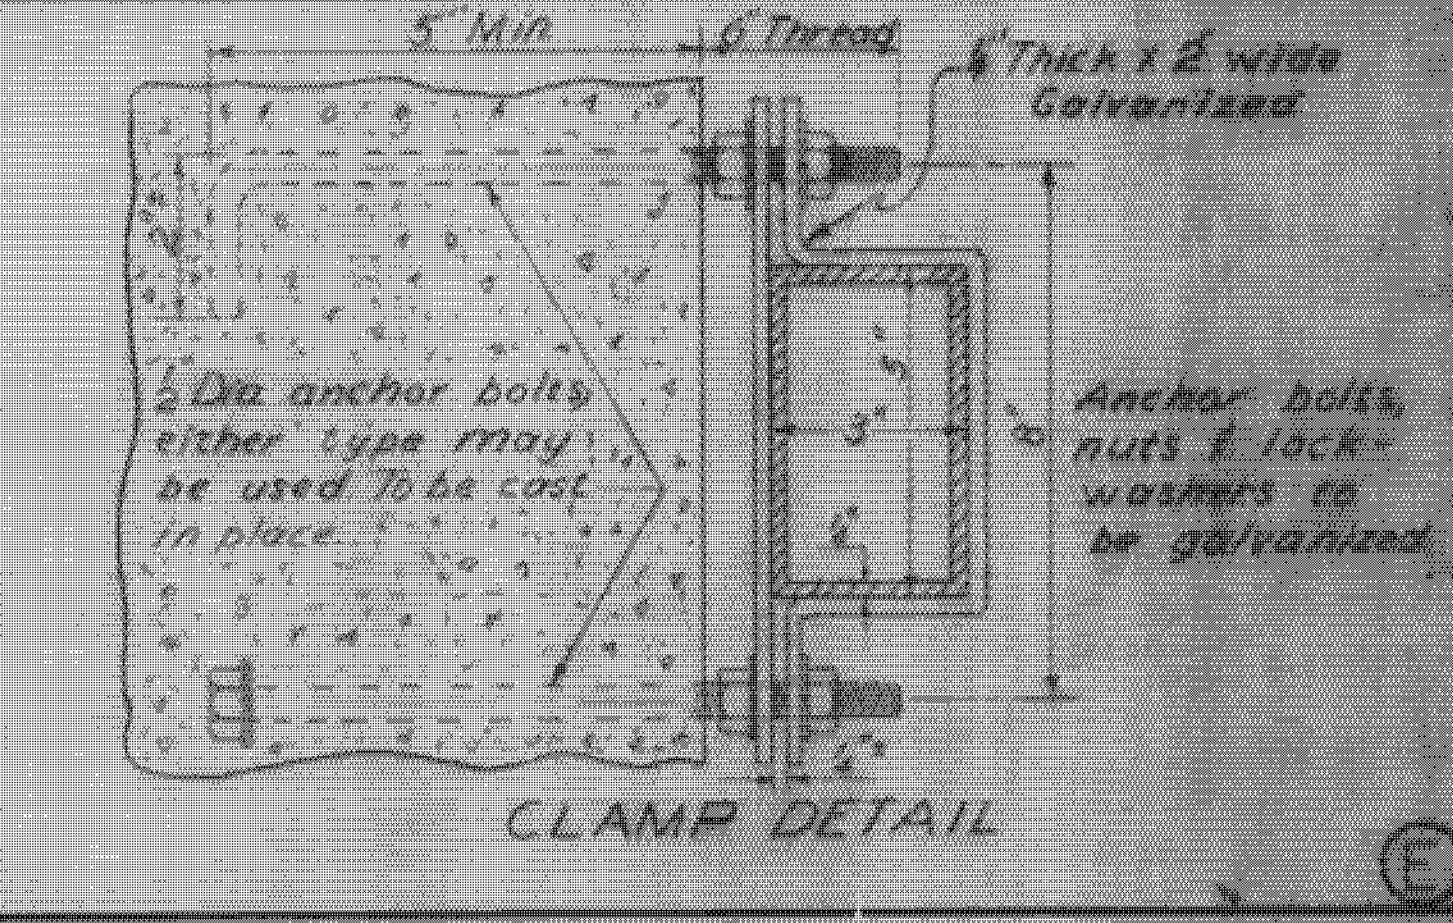
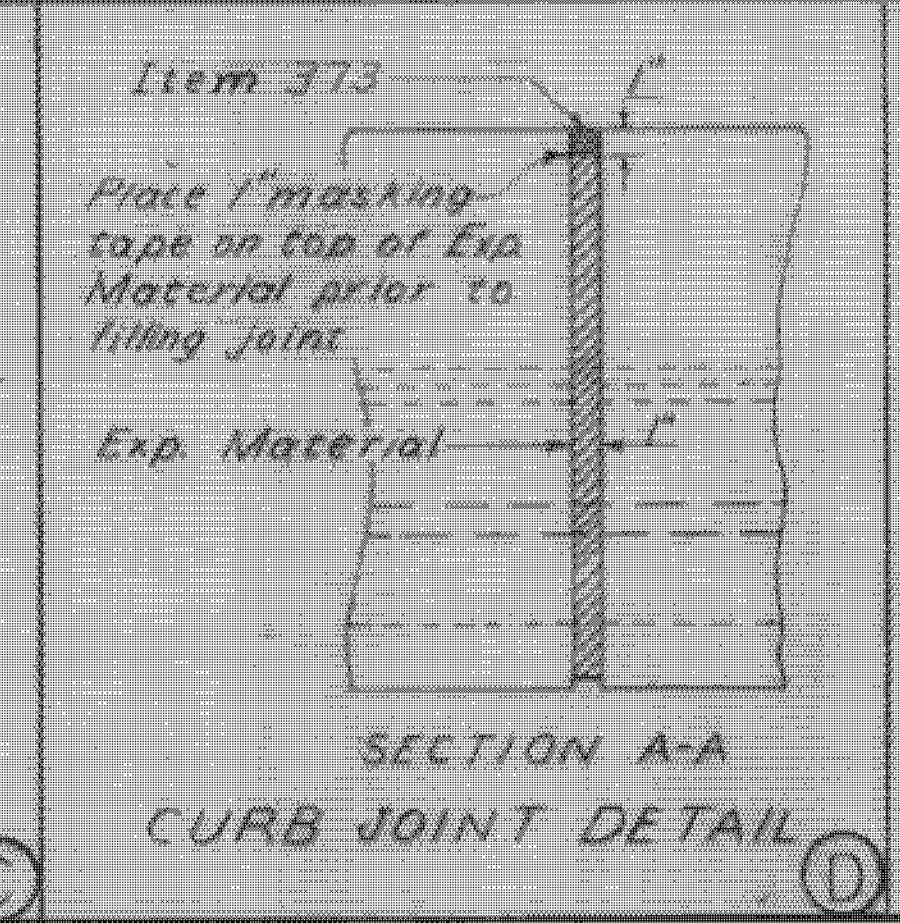
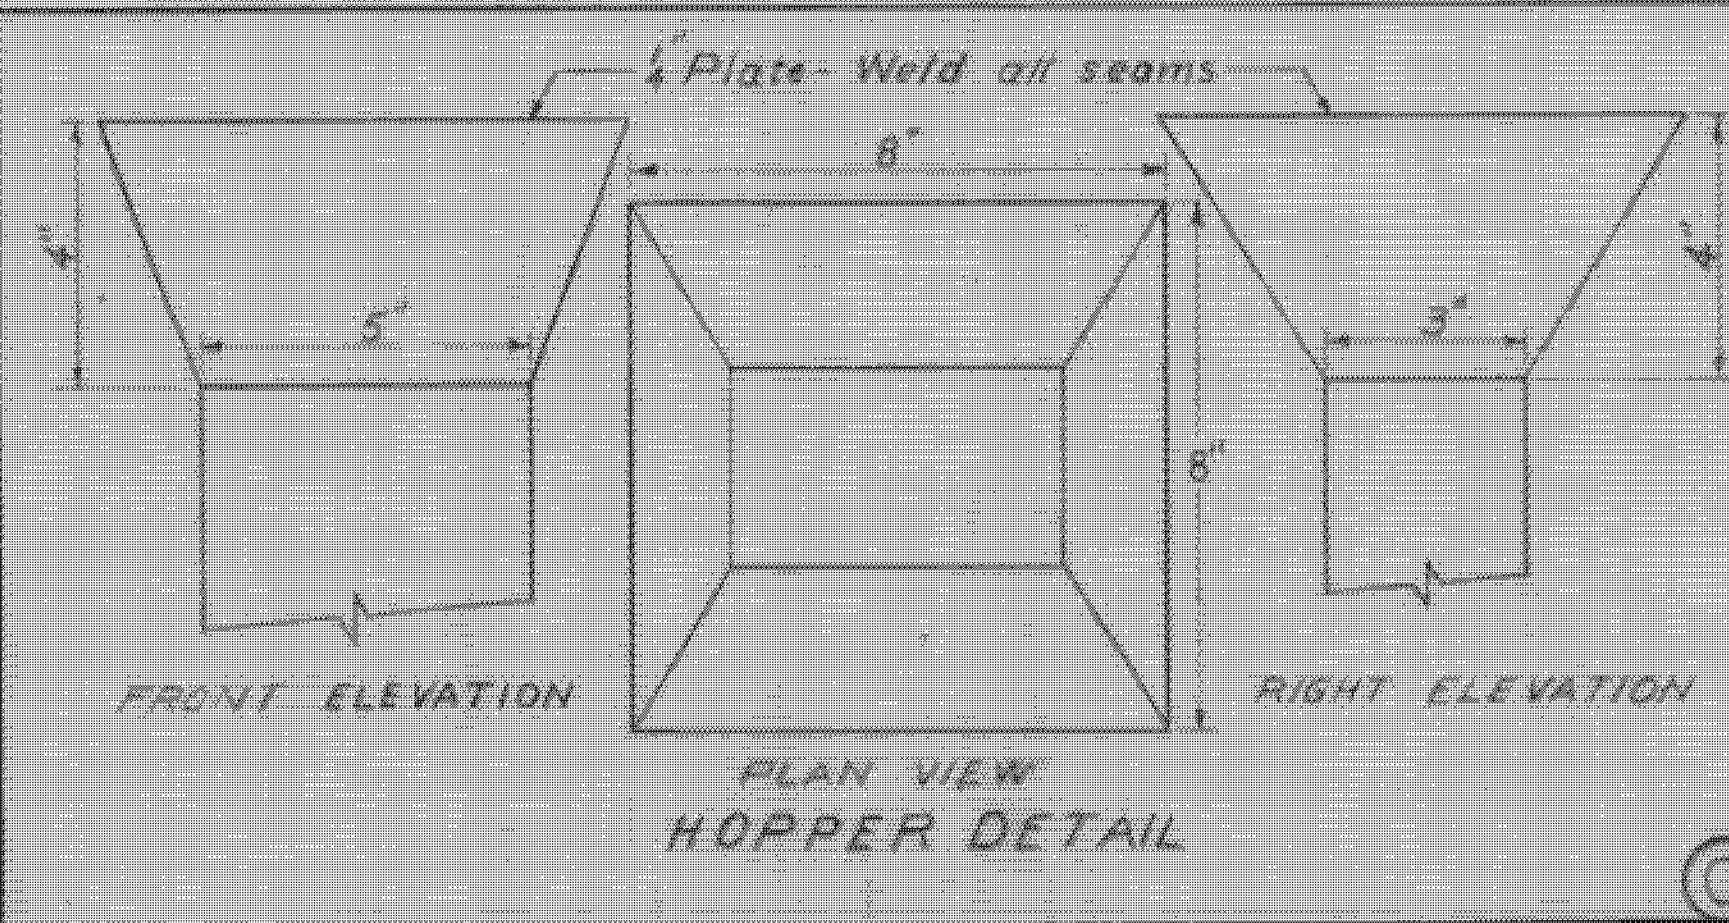


ELEVATION VIEW OF EXPANSION PLATE & DRAIN TROUGH

END VIEW

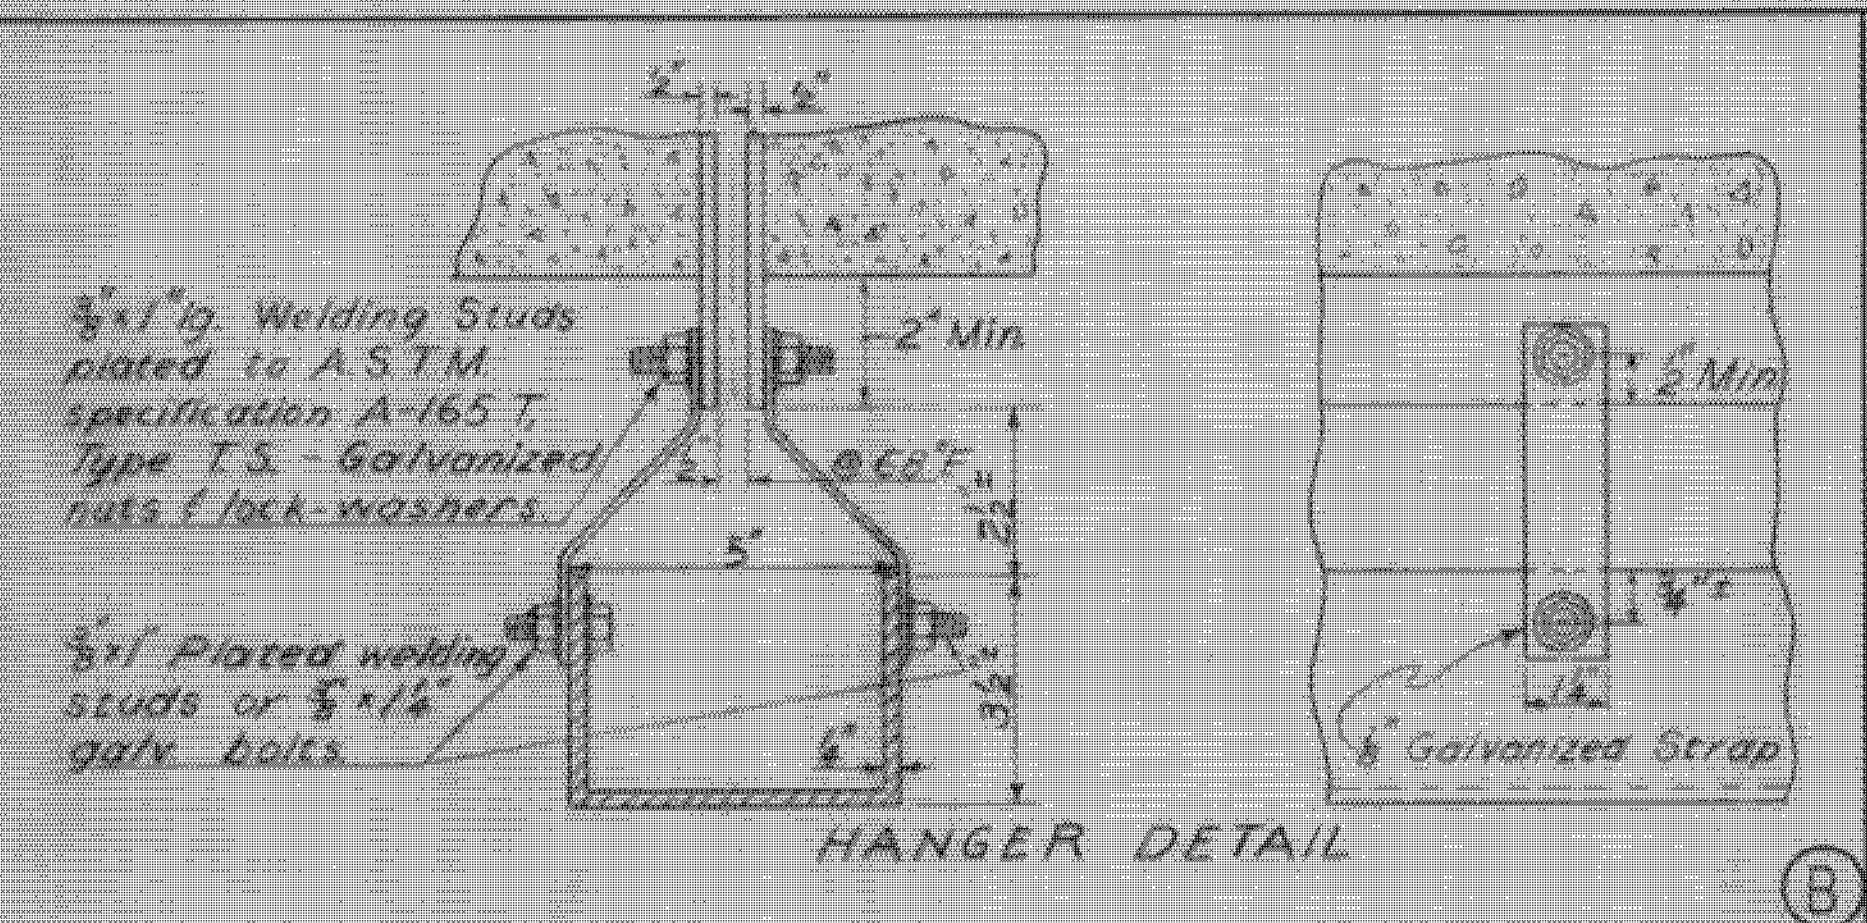

REVISIONS & CORRECTIONS

Revised: Exp. R. Material & Item 373. 6/21/62

Added dimension to S&P Bars. 6/21/62

Added 6" Thread See Clamp Detail 11/1/62

Drawn By: *[Signature]* Date: Dec 11/1962

Traced By: *[Signature]* Date: Dec 11/1962

Checked By: *[Signature]* Date: Dec 11/1962

Recommended For Approval: *[Signature]* Date: 10/1/62

Recommended For Approval: *[Signature]* Date: 11/6/62

Approved By: *[Signature]* Date: 11/1/62

DETAIL OF WF BEAM BRIDGES
PIER EXPANSION PLATES
&
DRAIN TROUGH DETAILS

VERMONT
DEPARTMENT OF HIGHWAYS
STRUCTURE STANDARDS

WESTMINSTER-NORWICH
IM BPNT (8)
SHEET 45 OF 58
FOR REFERENCE ONLY

SCB-D3-62