



ELEVATION VIEW OF EXPANSION PLATE & DRAIN TROUGH


END VIEW

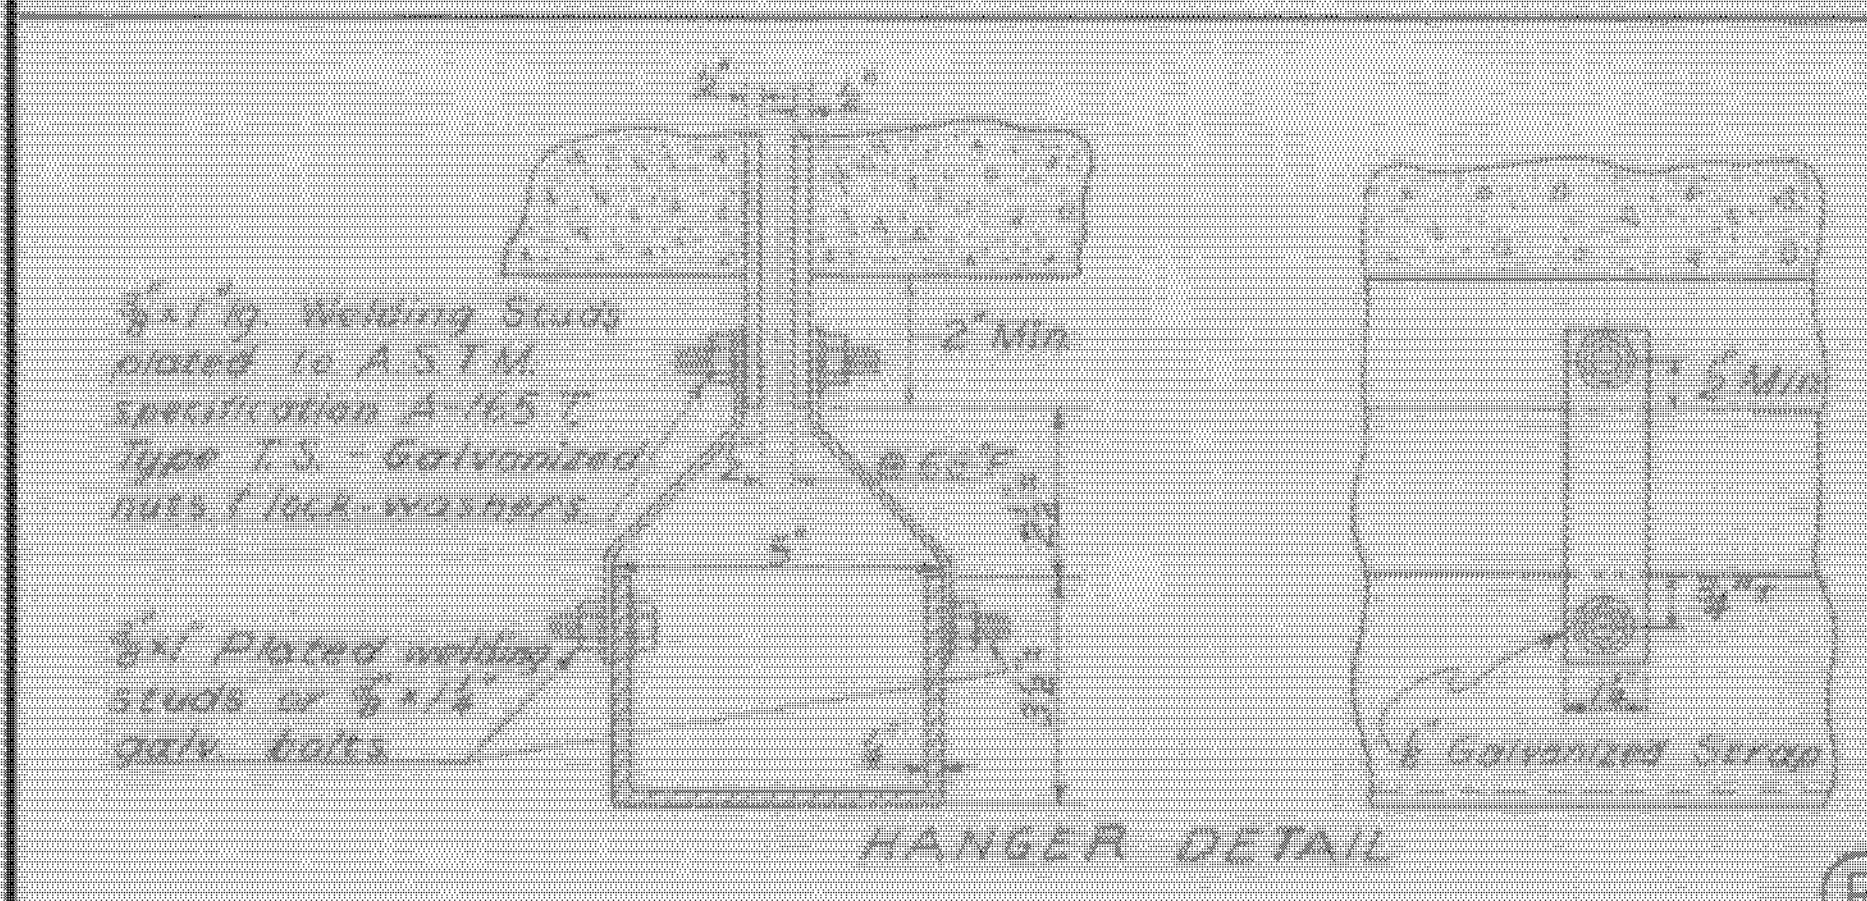


HANGER DETAIL

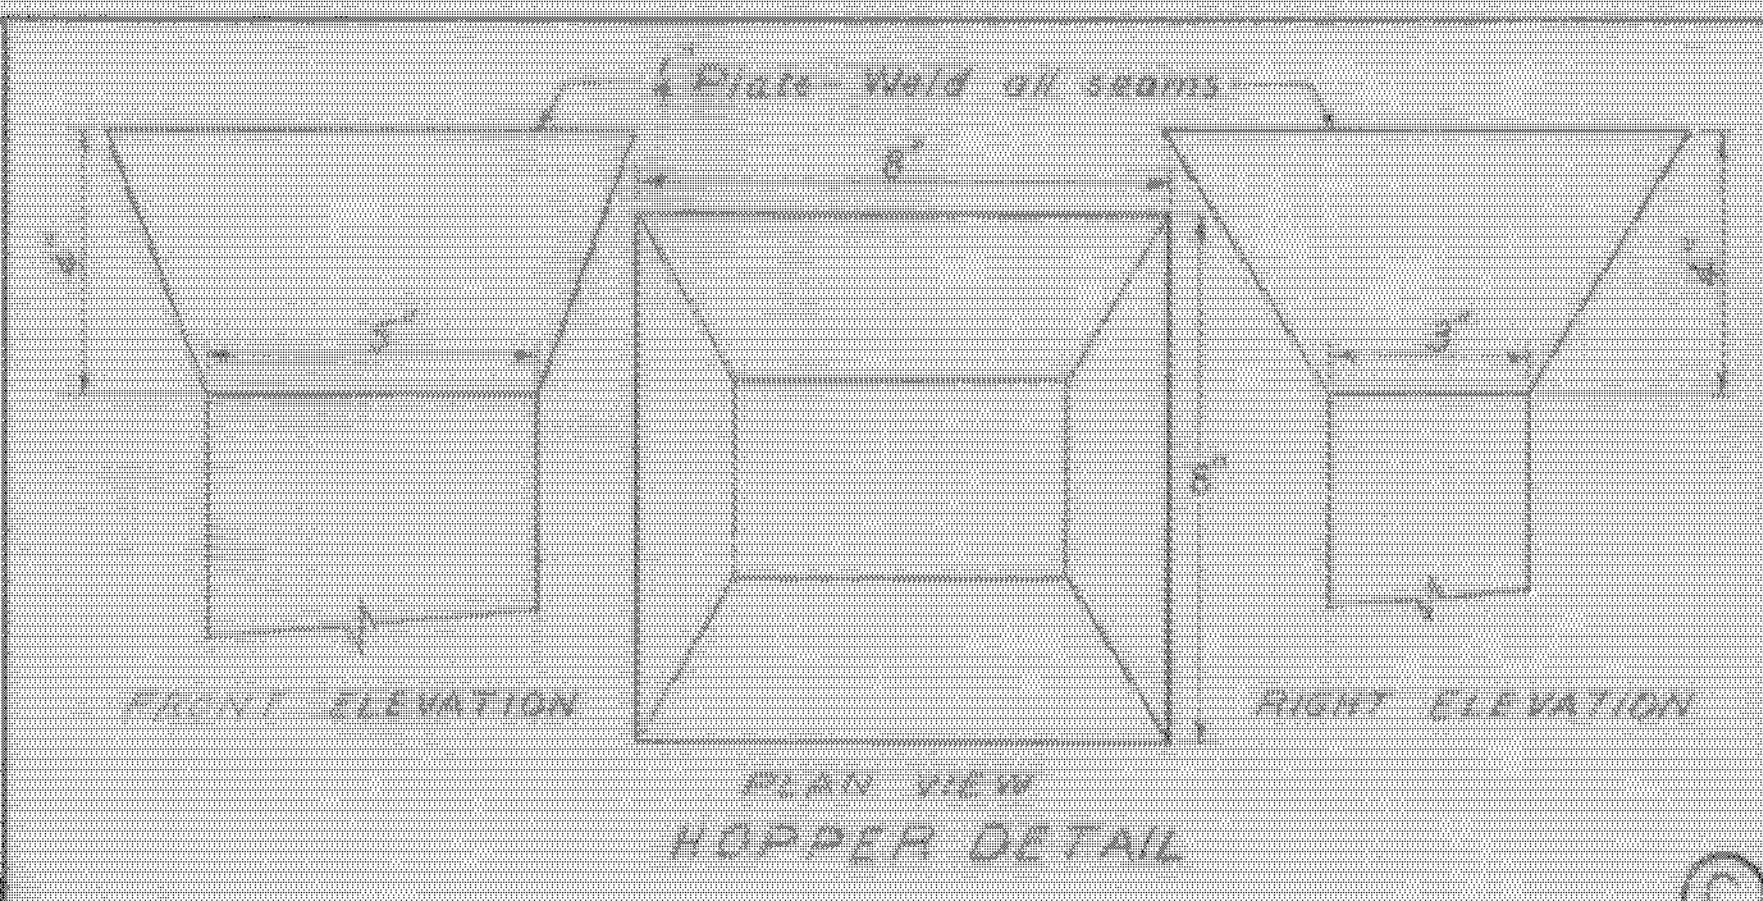

FRONT ELEVATION
PLAN VIEW HOPPER DETAIL
RIGHT ELEVATION

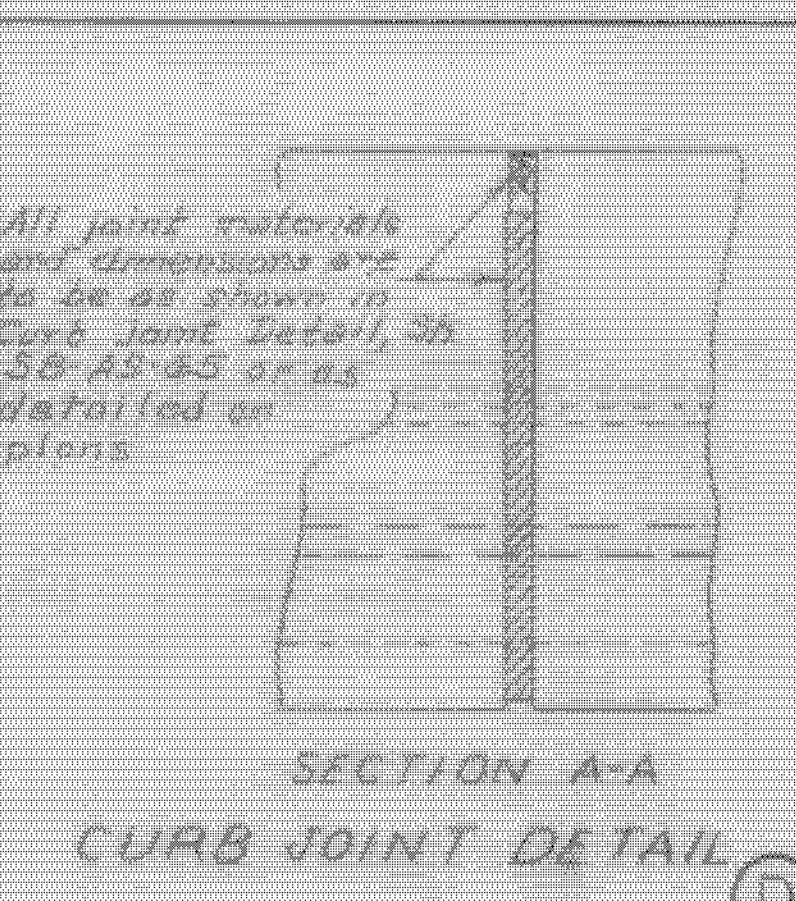

SECTION A-A CURB JOINT DETAIL

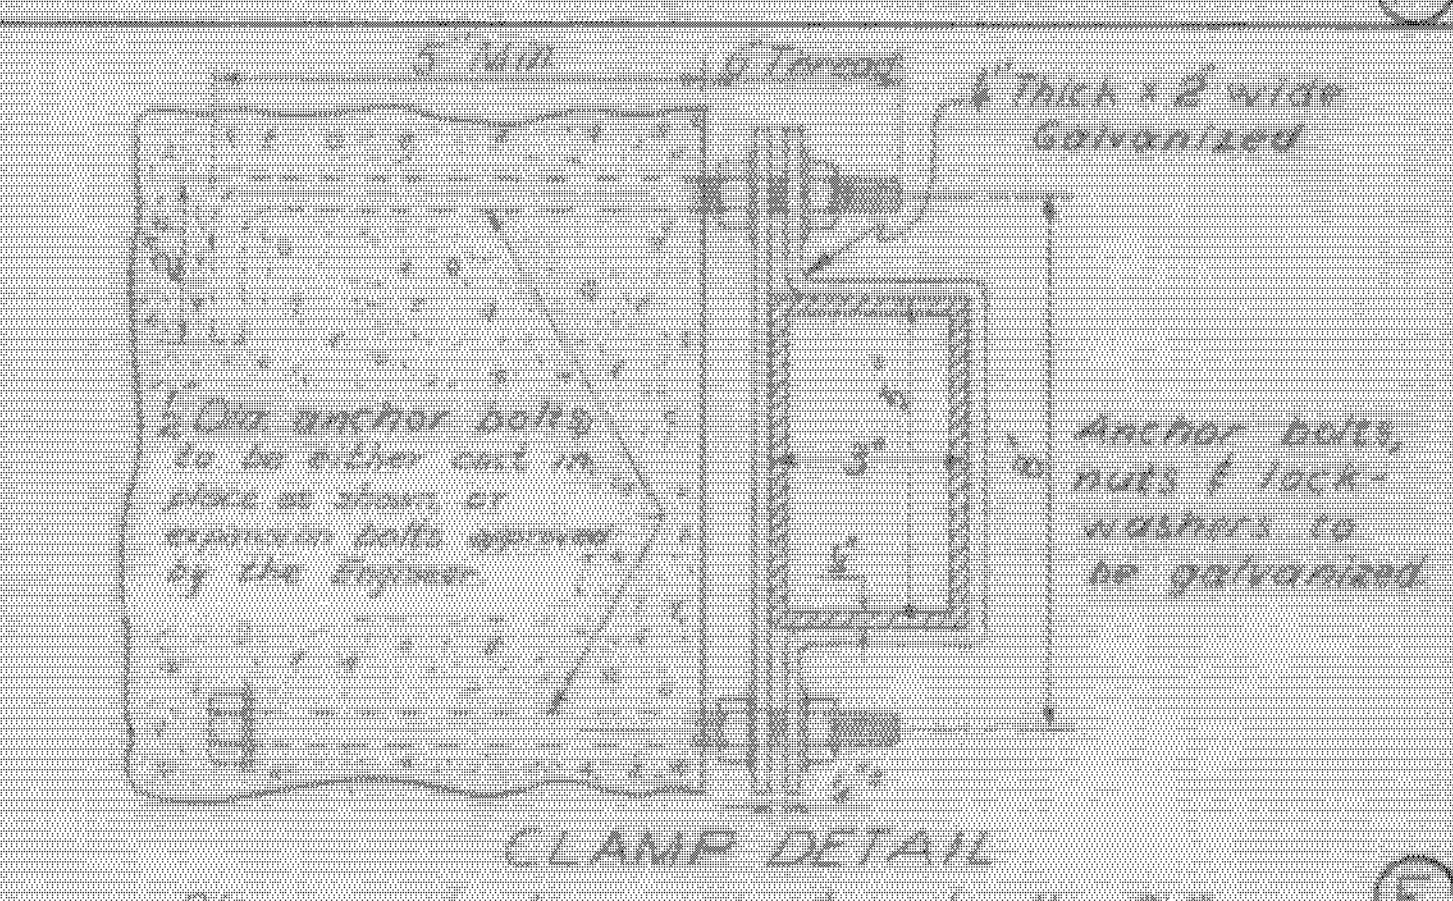

CLAMP DETAIL

REVISIONS & CORRECTIONS

Drawn By: *X 12/1/62* *Wasson, W. J.*
 Traced By: *X 12/1/62* *Revised, W. J.*
 Checked By: *E. E. ...*
 Recommended: *12/1/62*
 For Approval: *Chief Engineer* Date: *12/1/62*
 Recommended: *12/1/62*
 For Approval: *Asst. Chief Engineer* Date: *12/1/62*
 Approved By: *Chief Engineer* Date: *12/1/62*

DETAIL OF W BEAM BRIDGES
 PIER EXPANSION PLATES
 &
 DRAIN TROUGH DETAILS

VERMONT
 DEPARTMENT OF HIGHWAYS
 STRUCTURE STANDARDS

WESTMINSTER-NORWICH
 IM BPNT (8)
 SHEET 46 OF 58
 FOR REFERENCE ONLY

SCB-D3-65