



GENERAL NOTES:-

1. Elevation datum is sea level based on nearest U. S. Government vertical control.
2. For additional notes see SCB-DI-65.

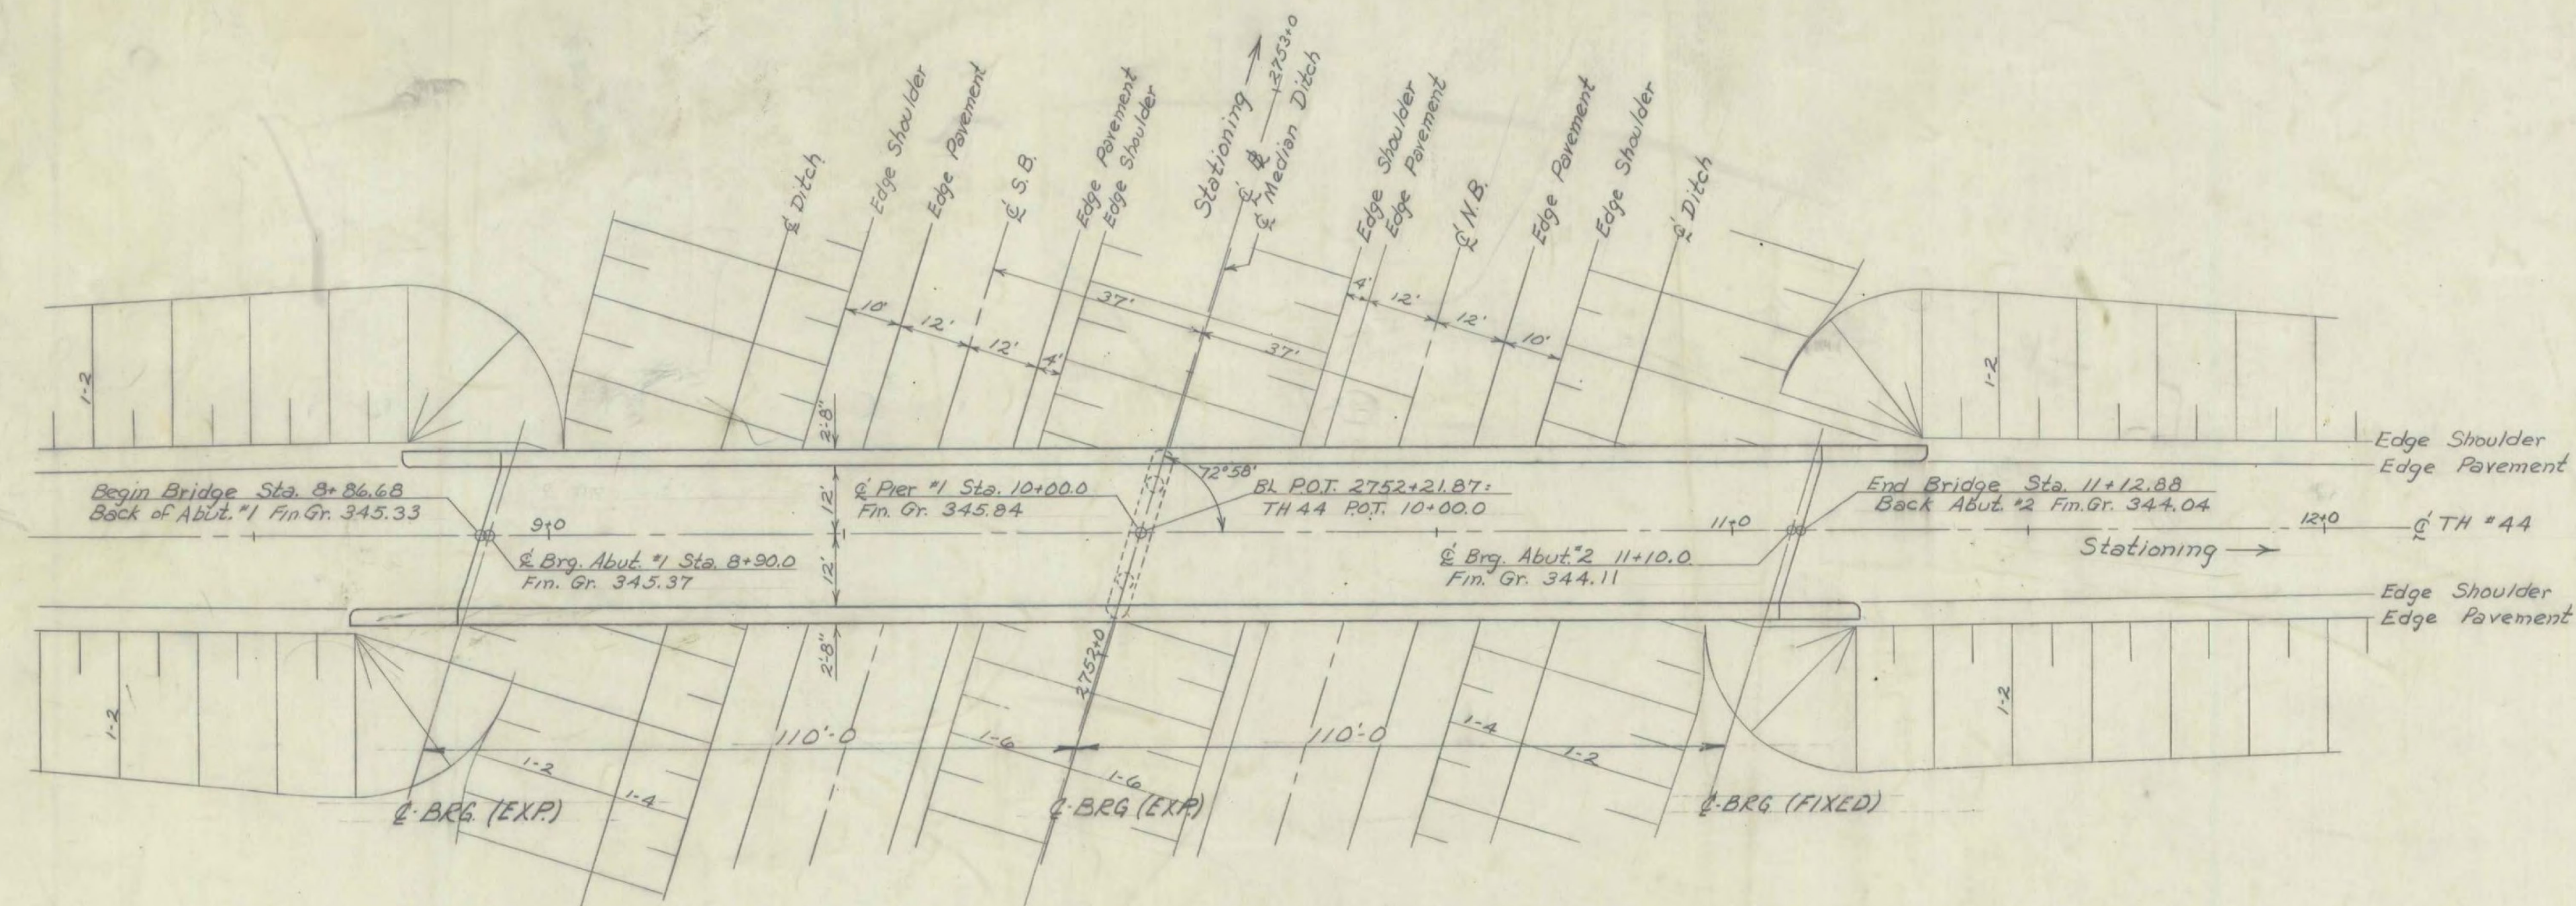

Plan
Scale: 1" = 20'

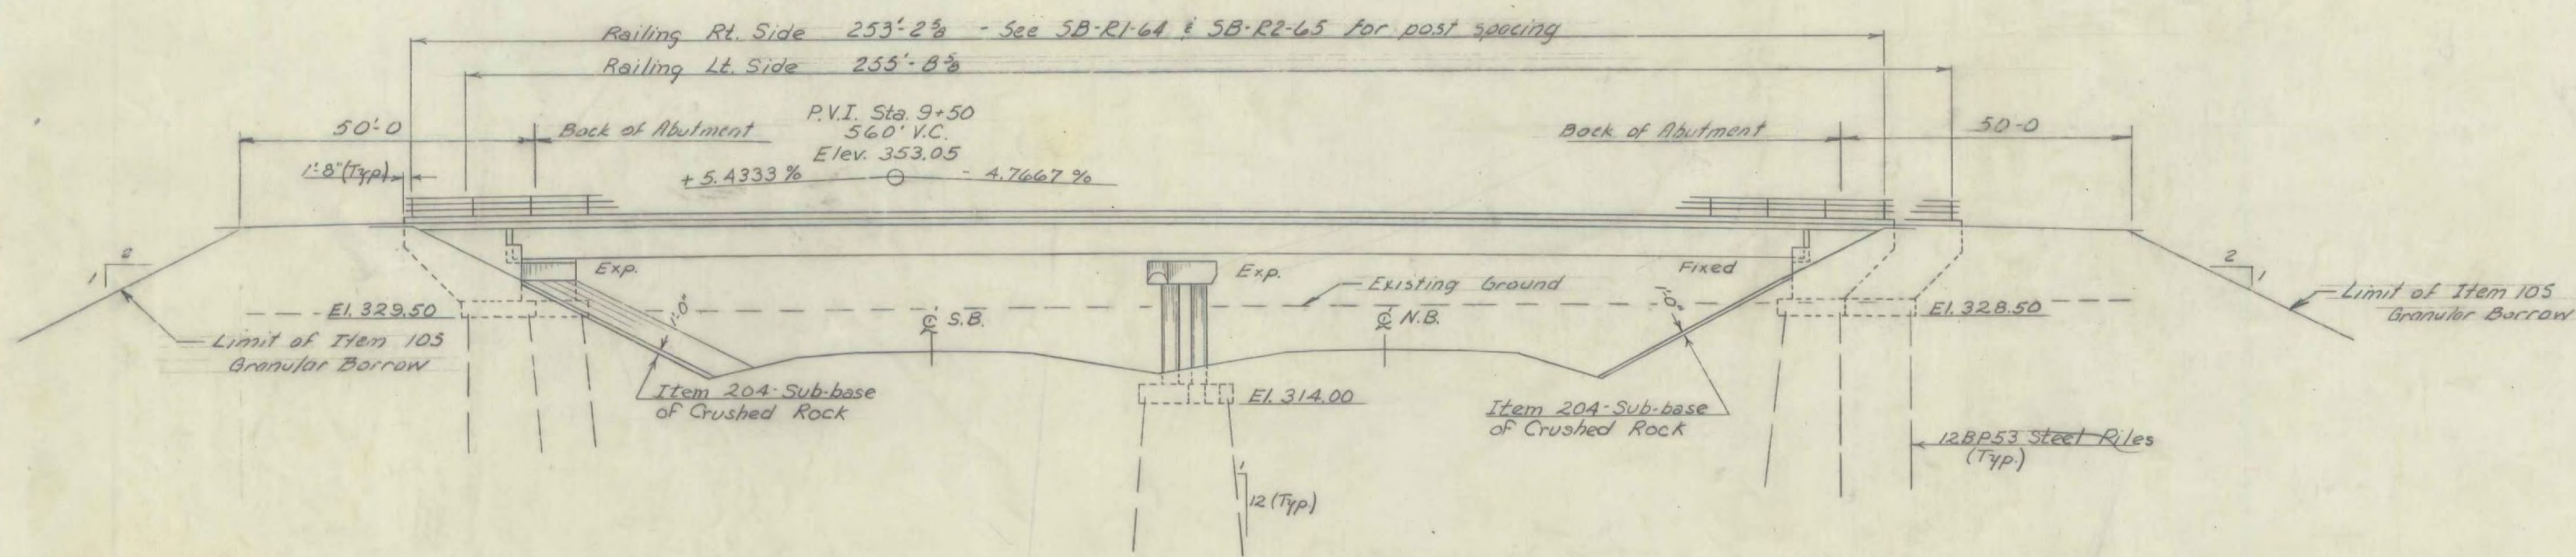

Elevation
Scale: 1" = 20'

LIST OF SHEETS:-

- BR. 100 - Plan and Elevation
- 101 - Bridge Quantity Sheet
- 102 - Preliminary Information Sheet
- 103 - Borings
- 104 - Girder Details
- 105 - Bracing Details and Bearing Devices
- 106 - Expansion Dam Details
- 107 - Abutment No. 1
- 108 - Abutment No. 2
- 109 - Pier
- BR. 110 - Reinforcing Steel Schedule

STANDARD SHEETS

- G-3a
- SCB-DI-65
- SCB-D6-65
- SB-R1-64 Sh. 1 & 2 of 2
- SB-R2-65
- SCB-D4-65

RICHMOND-HIGHGATE
IM BPNT(9)
SHEET 13 OF 30
BRIDGE 80
FOR INFORMATION ONLY

BR. 100 OF 110

ITEM NO.	ITEM	UNIT	NET	TOTAL	FINAL
	CHAN. EXCAV. OF EARTH	C.Y.			
	CHAN. EXCAV. OF ROCK	C.Y.			
	UNCLASS. CHAN. EXCAV.	C.Y.			
	STRUCT. EXCAV.	C.Y.			
	CONC. CLASS AA (MOD.)	C.Y.			
	CONC. CLASS B (MOD.)	C.Y.			
	REINF. STEEL	LBS.			
	ASPHALTIC-ASR COATING	S.Y.			
	TREATED TIMBER PILING	L.F.			
	SPLICES FOR STEEL PILING	EA.			
	STEEL PILING	L.F.			
	UNTREATED TIMBER PILING	L.F.			

STATE OF VERMONT
DEPARTMENT OF HIGHWAYS

PROJECT NAME COLCHESTER MILTON
TOWN OF MILTON
New CLASS 2 & 6
ROUTE No. T.H. 44 LOG STA.
T.H. 44 OVER I-89 @ B. STA. 2752+21.87

PLAN AND ELEVATION
SCALE: As shown

SURVEYED BY _____
DRAWN BY WBT CHECKED BY RLO
PROJECT No. J-89-3(34)
SHEET 102 OF 419

188-B
M