
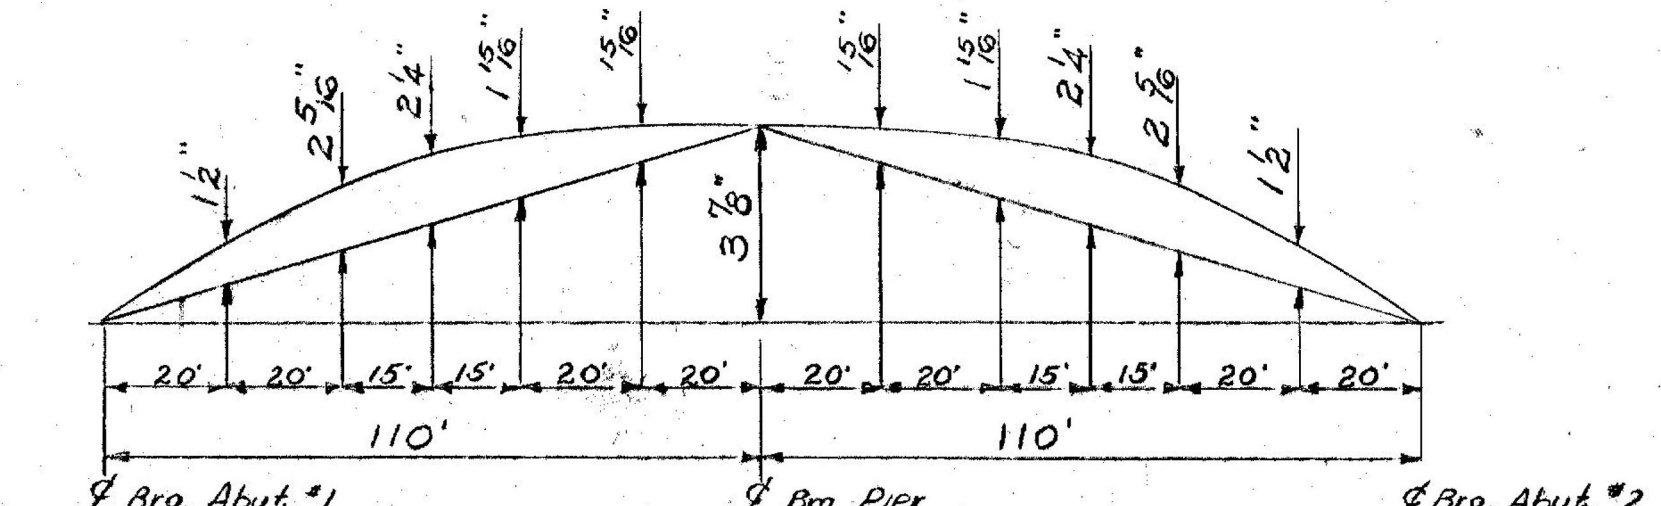
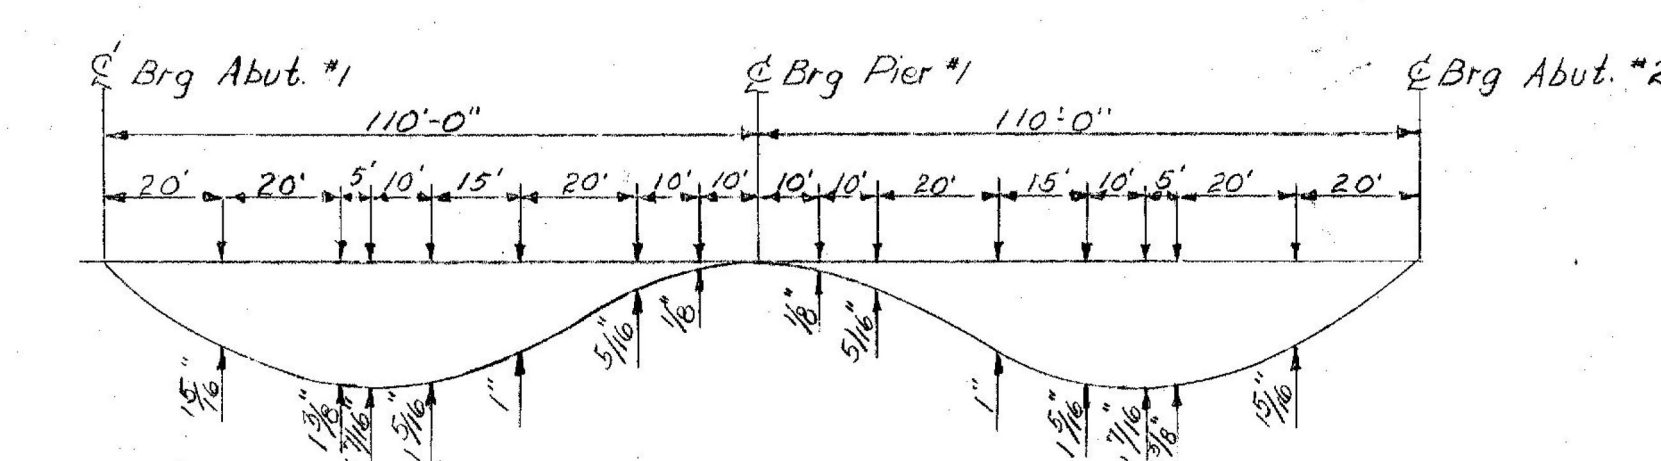


**Field Splice Detail**  
Scale: 1/2" = 1'-0"

\* Top Flange is in tension between Field Splices. Bottom Flange is in tension between Field Splices and Abutments.

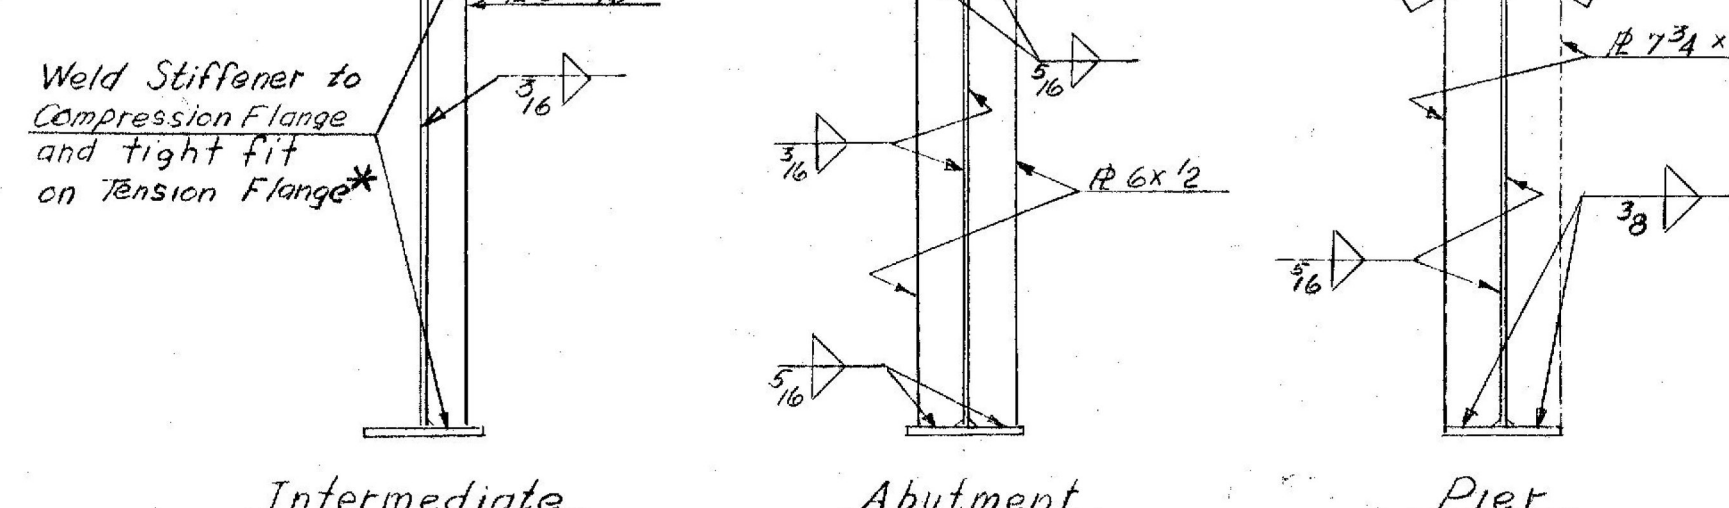

RICHMOND-HIGHGATE  
IM BPNT(9)  
SHEET 26 OF 30  
BRIDGE 91  
FOR INFORMATION ONLY

STATE OF VERMONT  
DEPARTMENT OF HIGHWAYS

PROJECT NAME St Albans-Swanton  
TOWN OF Swanton  
ROUTE No. I 89  
Vt #105 over I 89 @ Sta 3546+92.66  
Framing Plan & Girder Details  
SCALE As noted

SURVEYED BY \_\_\_\_\_  
DRAWN BY VF CHECKED BY A.J.C.  
PROJECT No. I 89-3(3) Cont. #1  
SHEET 91 OF 298