



- * - ADJUST LENGTH OF TAPER AS NECESSARY TO AVOID REMOVING THE MILLED RUMBLE STRIPS.
- ** - REDUCE DIMENSION TO 12'-6" AS NECESSARY TO AVOID REMOVING THE MILLED RUMBLE STRIP.

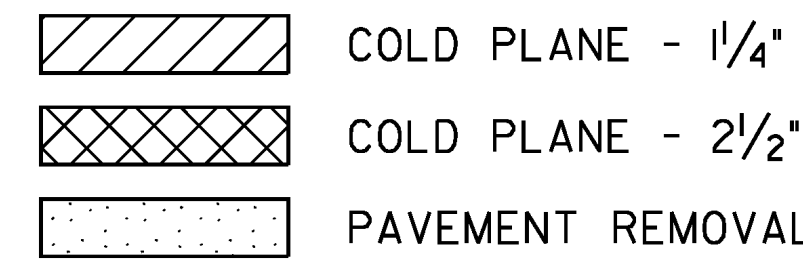


- REMOVE THE PAVEMENT TO THE TOP OF CONCRETE BRIDGE DECK.
- REMOVE THE PAVEMENT TO THE TOP OF CONCRETE APPROACH SLAB OR 2 1/2", - WHICHEVER IS LESS.
- REMOVE BARRIER MEMBRANE ON THE BRIDGE DECK.
- REMOVE BARRIER MEMBRANE ON THE APPROACH SLAB.

BITUMINOUS CONCRETE REMOVAL PLAN
NOT TO SCALE

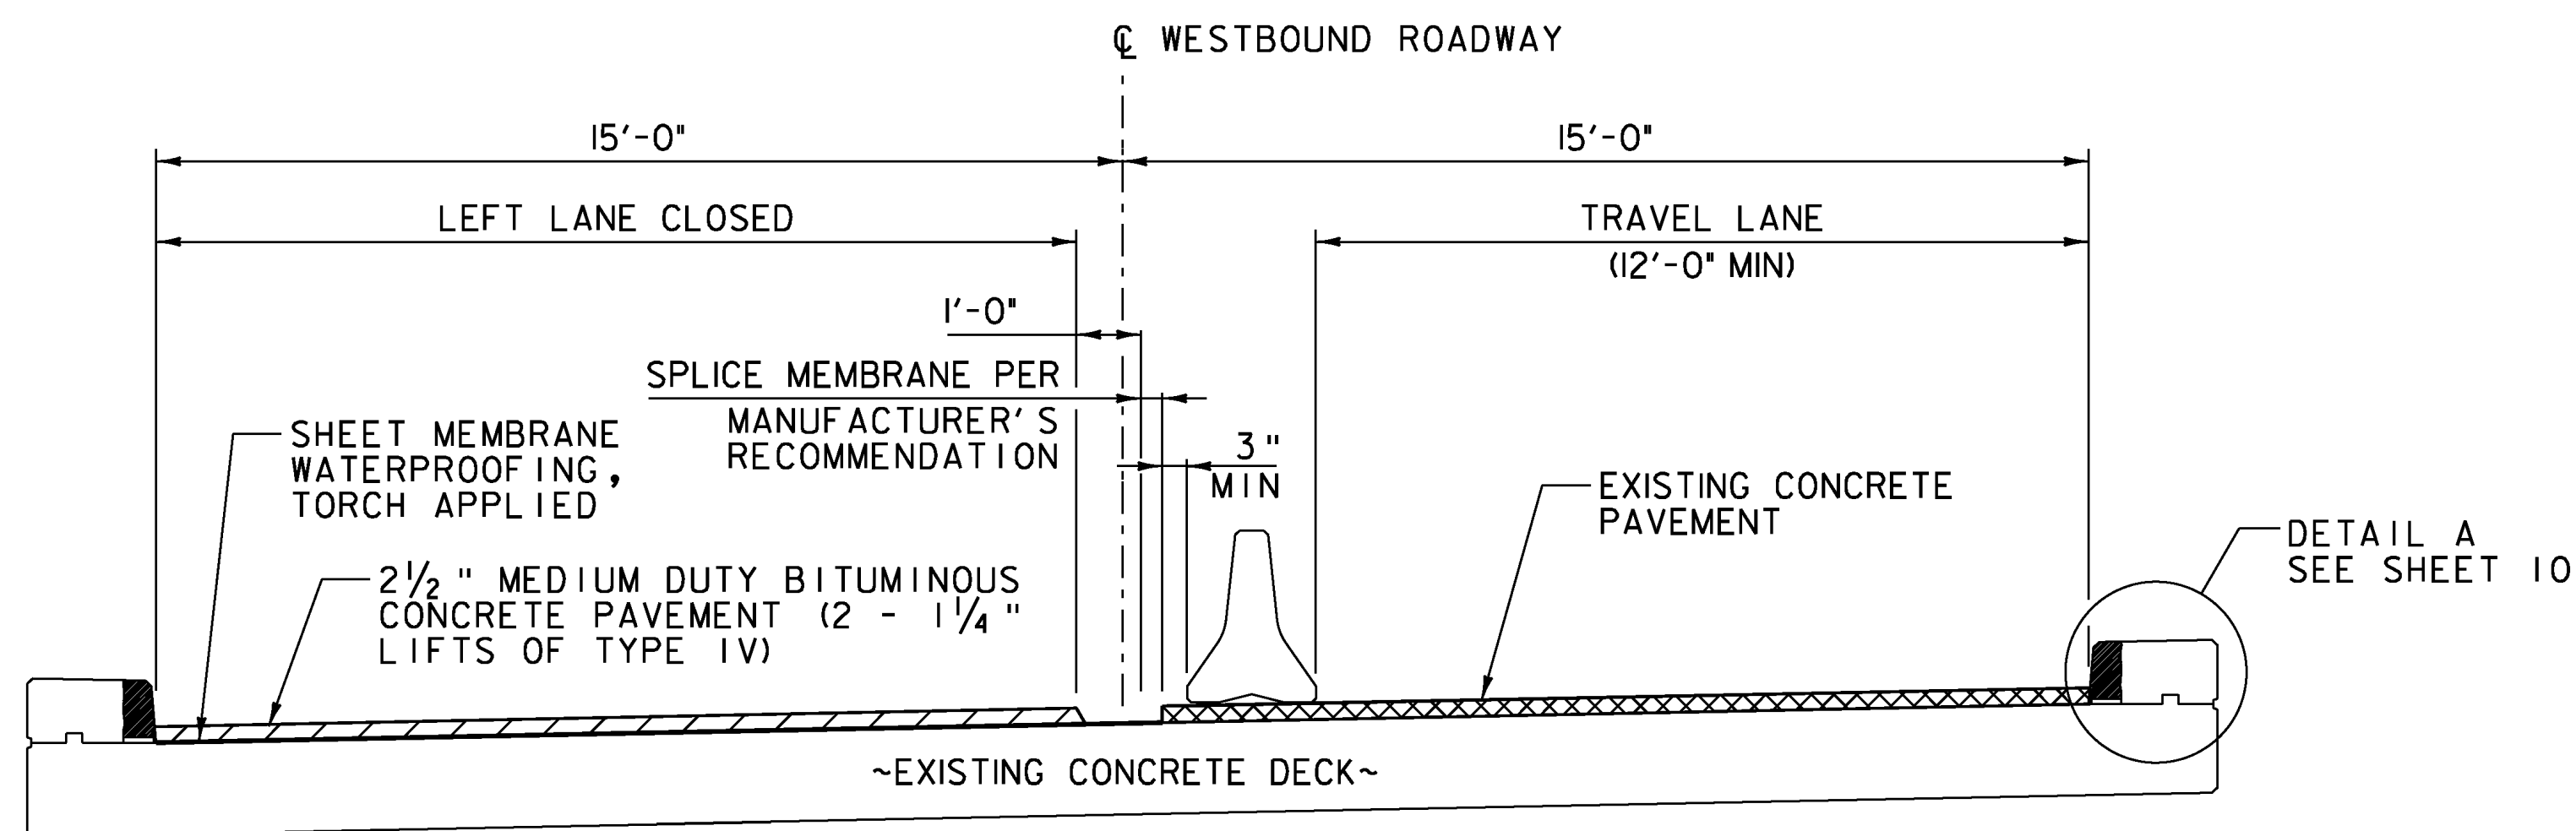

NOTE: PLACEMENT OF THE MEMBRANE SHALL START AT THE LOW SIDE OF THE BRIDGE. THE SPLICE SHALL BE AS SHOWN ABOVE, WITH THE HIGH SIDE OVERLAPPING THE LOW SIDE.

BRIDGE 67 - PHASE I CONSTRUCTION
NOT TO SCALE

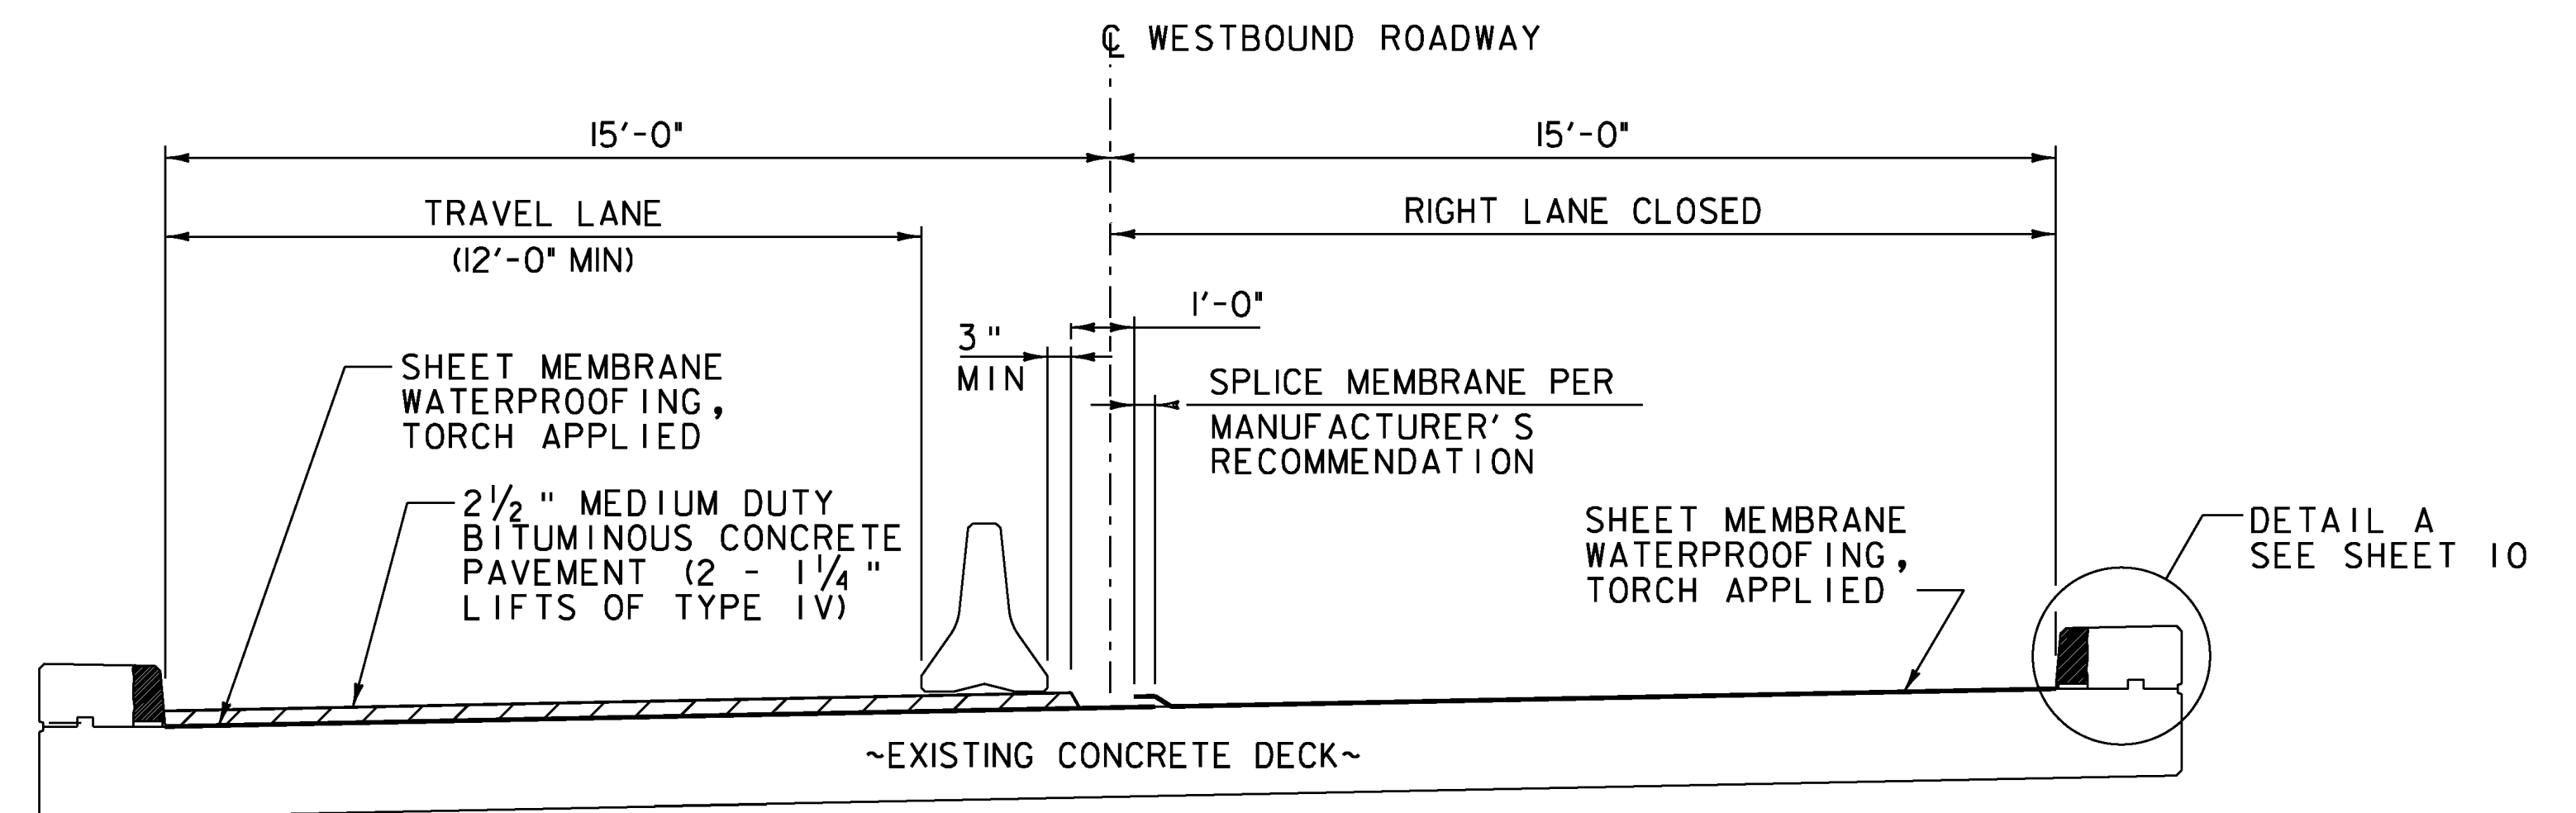

NOTE: PLACEMENT OF THE MEMBRANE SHALL START AT THE LOW SIDE OF THE BRIDGE. THE SPLICE SHALL BE AS SHOWN ABOVE, WITH THE HIGH SIDE OVERLAPPING THE LOW SIDE.

BRIDGE 67 - PHASE II CONSTRUCTION
NOT TO SCALE