


PLAN - BRIDGE NO. 67

SCALE: 1"=20'

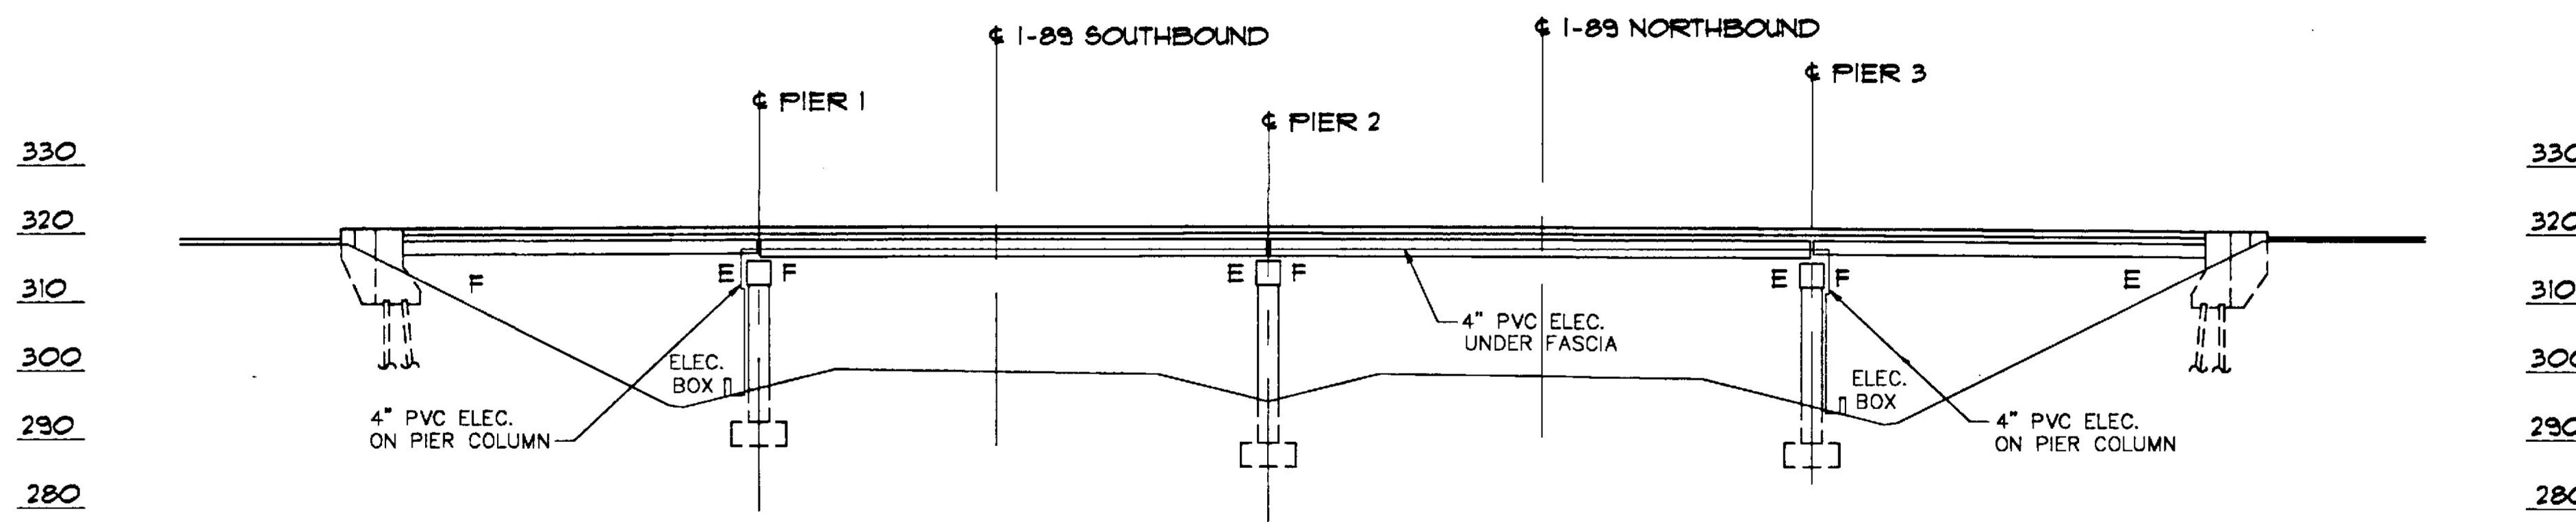

ELEVATION - BRIDGE NO. 67

SCALE: 1"=20'

WILLISTON - GEORGIA
 IM MEMB(25)
 SHEET 22 OF 38
 BRIDGE 67
 FOR REFERENCE ONLY

VANASSE HANGEN BRUSTLIN, INC.

STATE OF VERMONT AGENCY OF TRANSPORTATION	
Town Of SOUTH BURLINGTON	Bridge No. 67
Highway No. 1-189	Log Sta. Surv. Sta.
1-189 W.B. OVER 1-89	
PLAN & ELEVATION	
Designed By T.S. BRYANT	Drawn By B.J. MASSE
Checked By J.P. HALSTEAD 1/94	Date 1/94 Bridge Design Supervisor J.P. HALSTEAD Date 1/94
PROJECT SOUTH BURLINGTON	PROJECT NO. IM DECK(30)
VHB Cad Drawing No. 50363840	Date 2-24-94
Bridge Sheet No.	Sheet 59 of 195